



	Fusion Medical Staffing
	Fusion Medical Staffing Tenant Fit-Out
	11808 Grant Street Omaha, NE 68164
	Fusion
	MEDICAL STAFFING
	11506 Nicholas St, Suite 110 Omaha, NE 68154
	Project No. 001-10127-001 December 8, 2015 CONSTRUCTION DOCUMENTS
	CONSTRUCTION DOCUMENTS
	ADDENDUM NO. 1 December 18, 2015
	LEO A DALY
	PLANNING ARCHITECTURE ENGINEERING INTERIORS




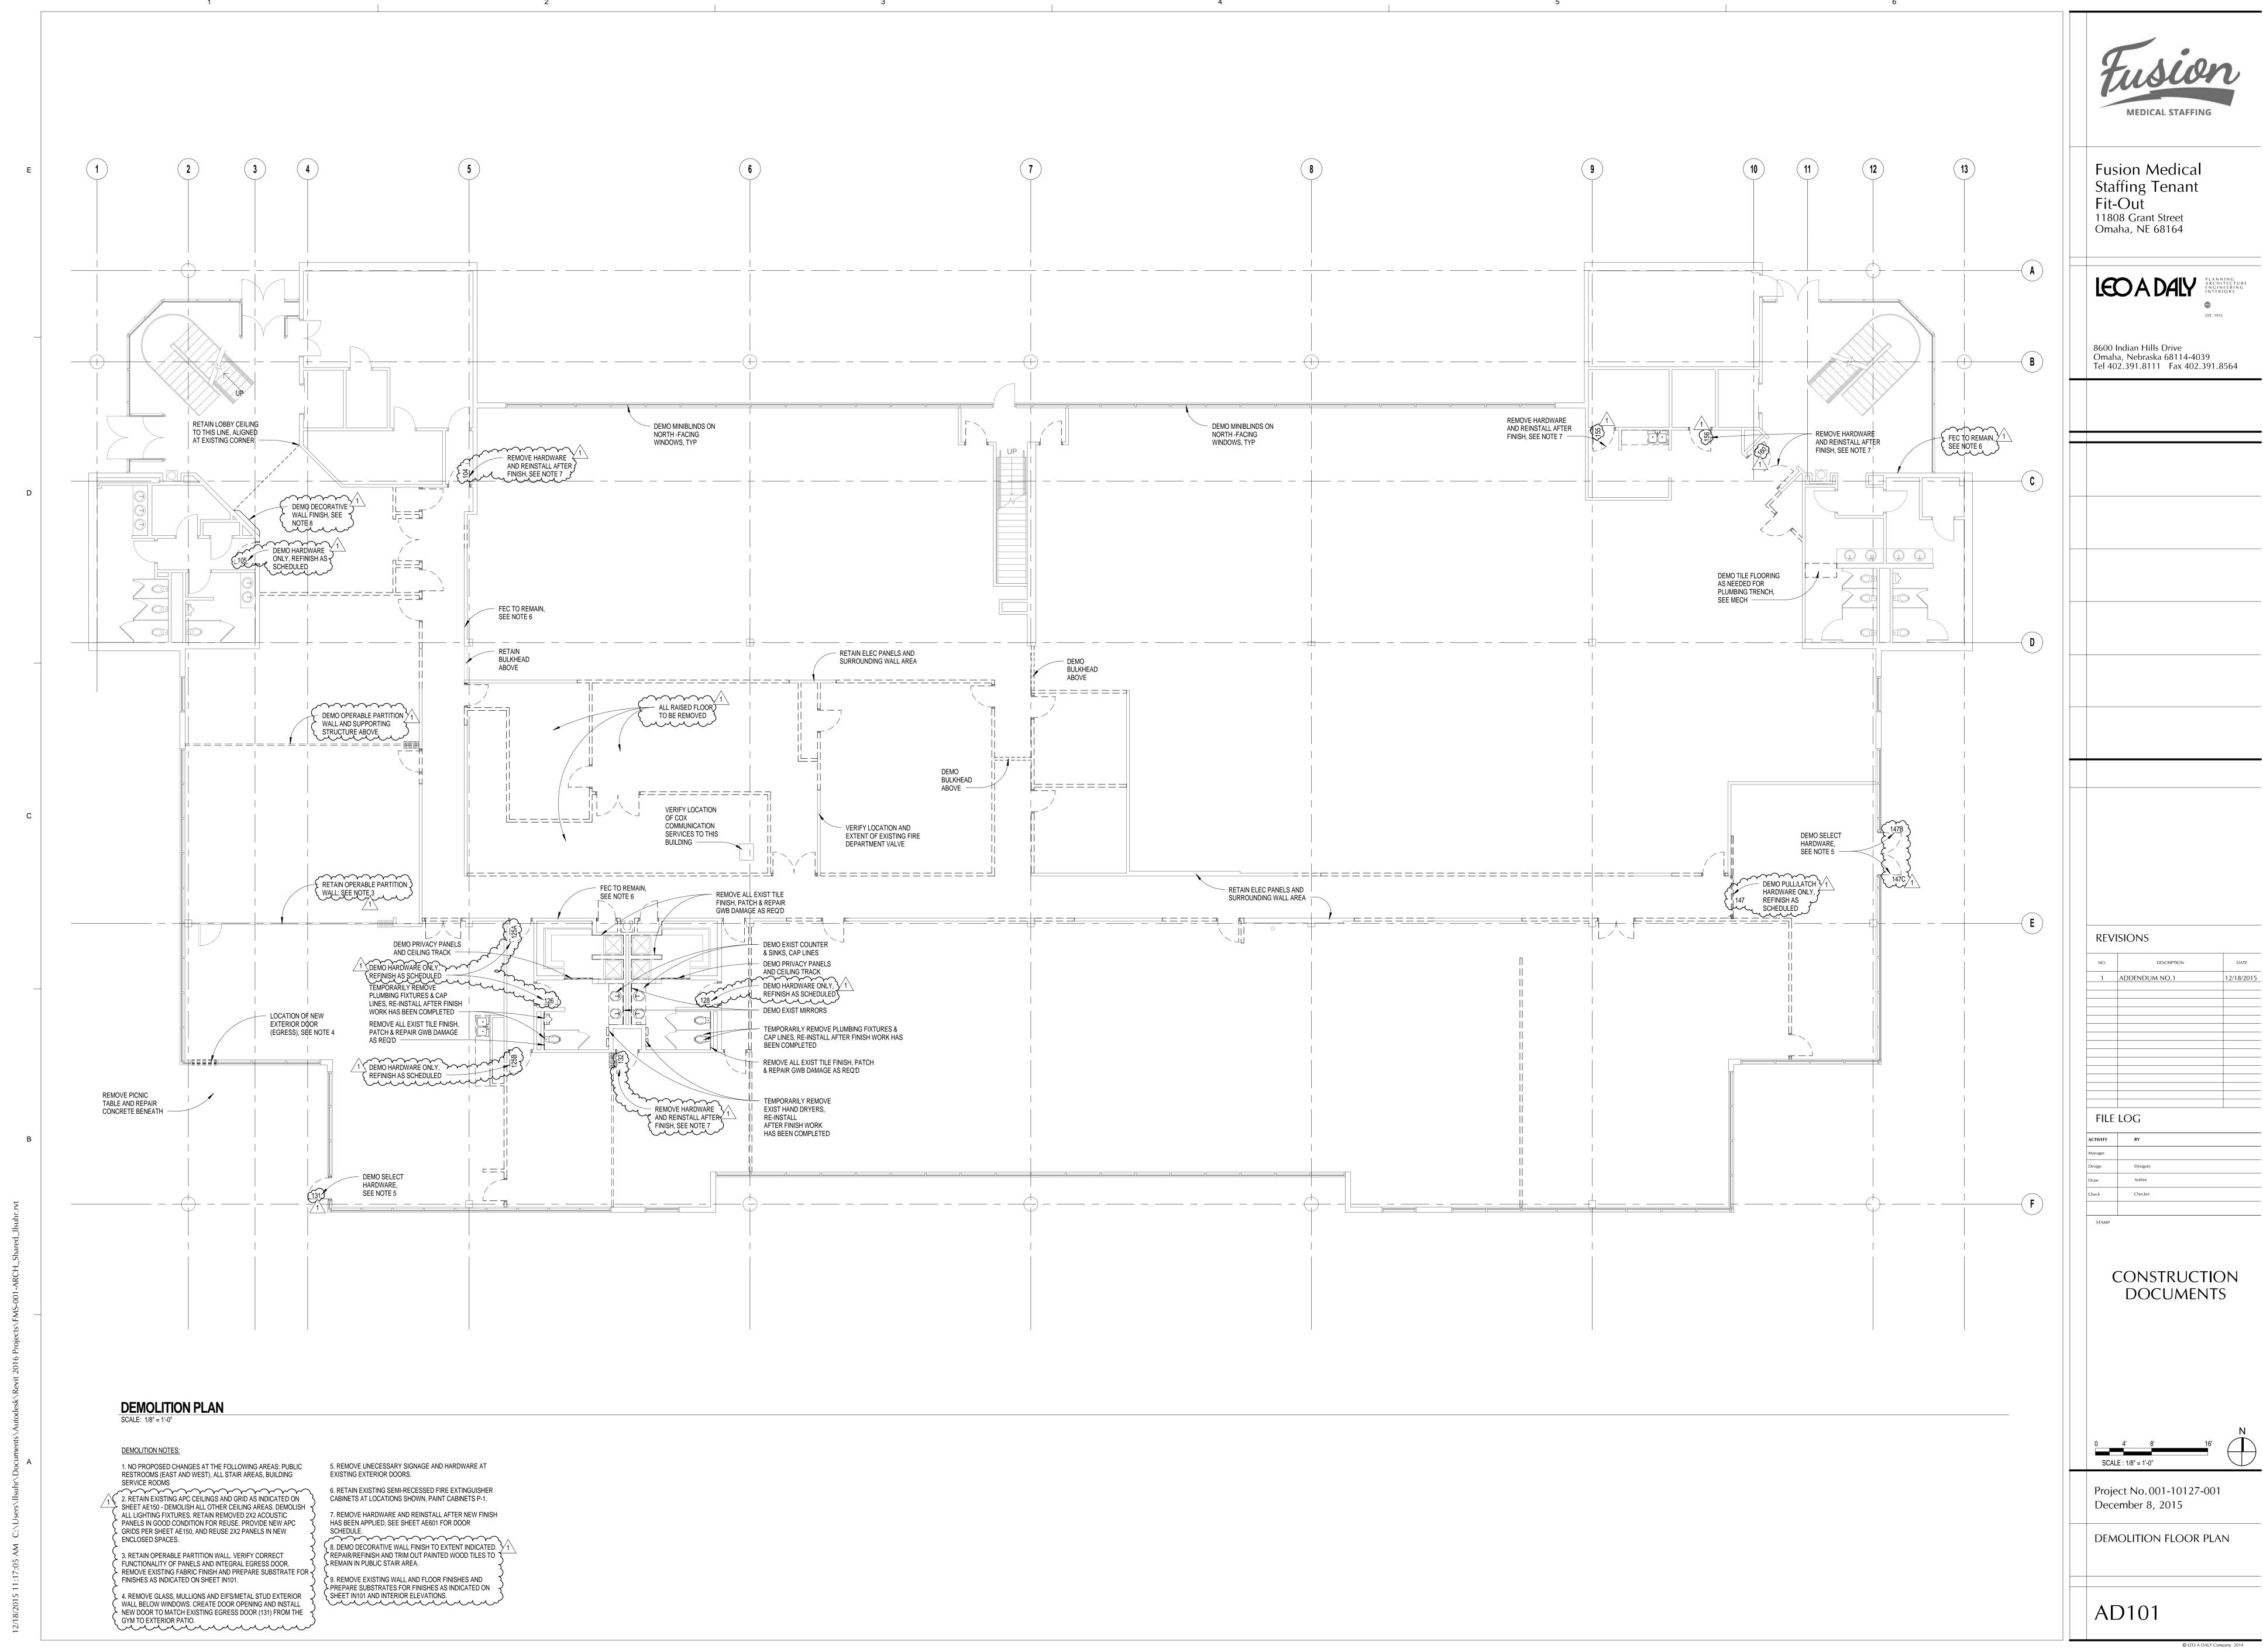

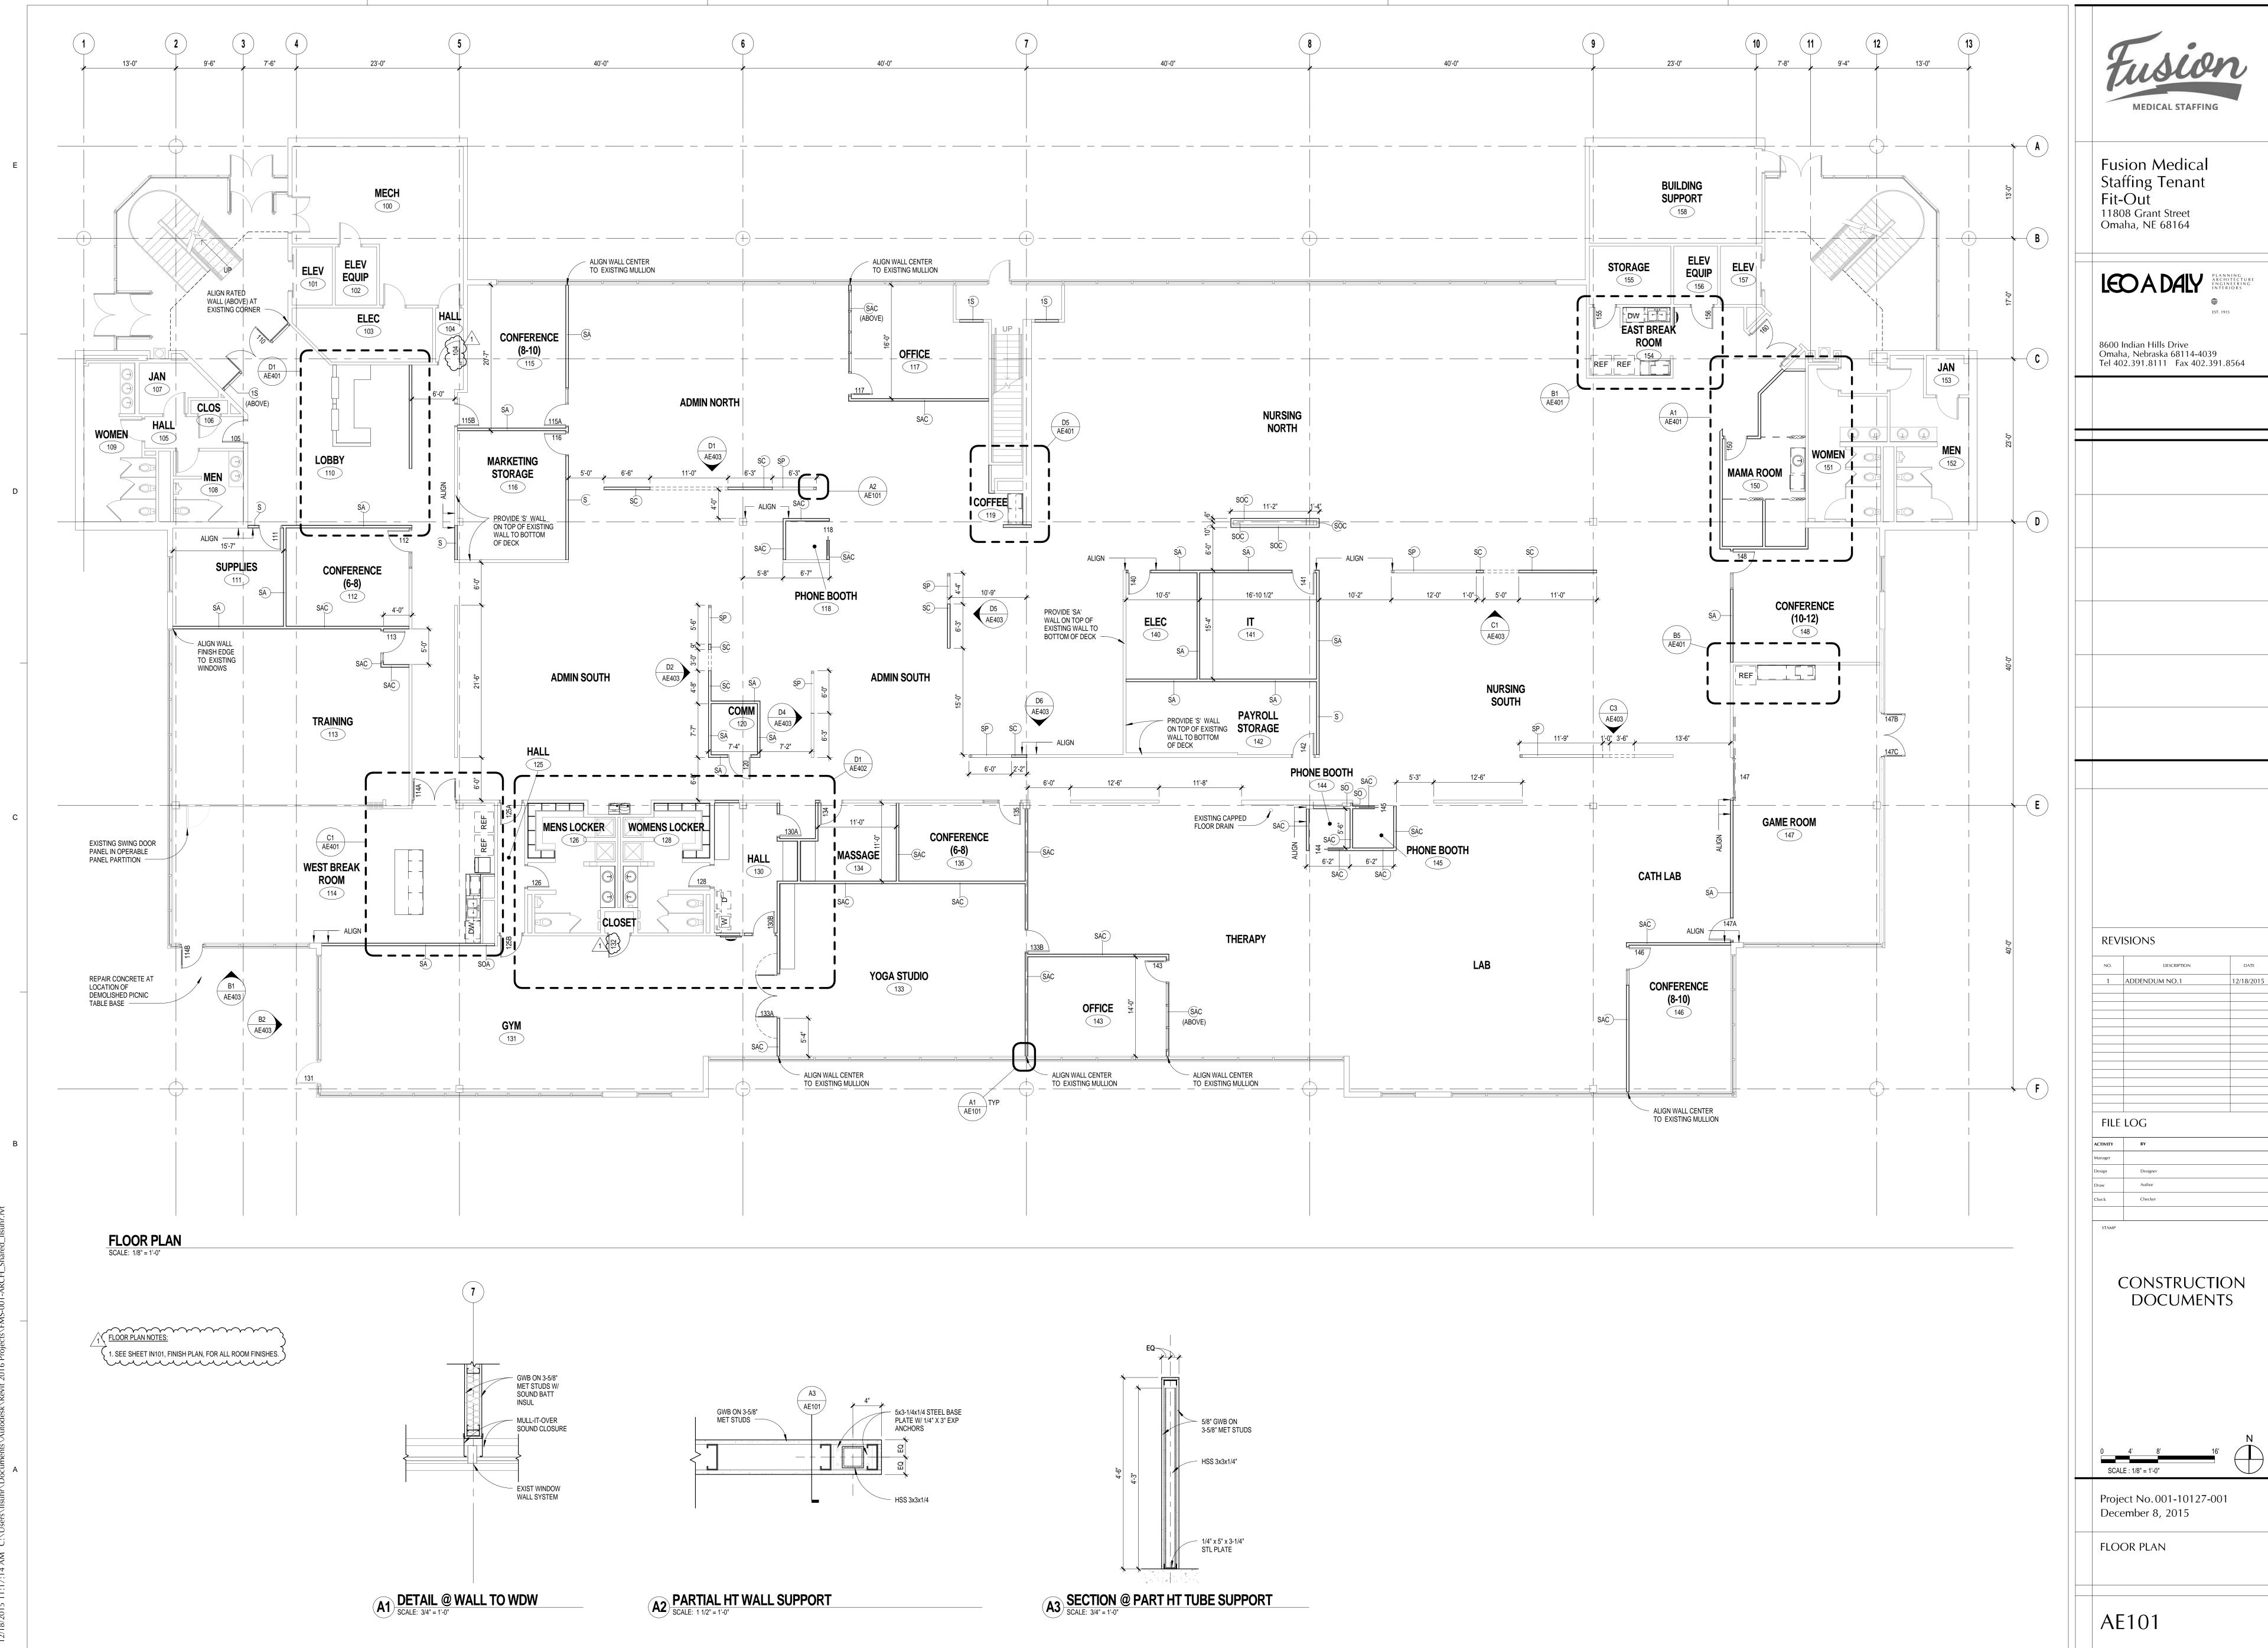

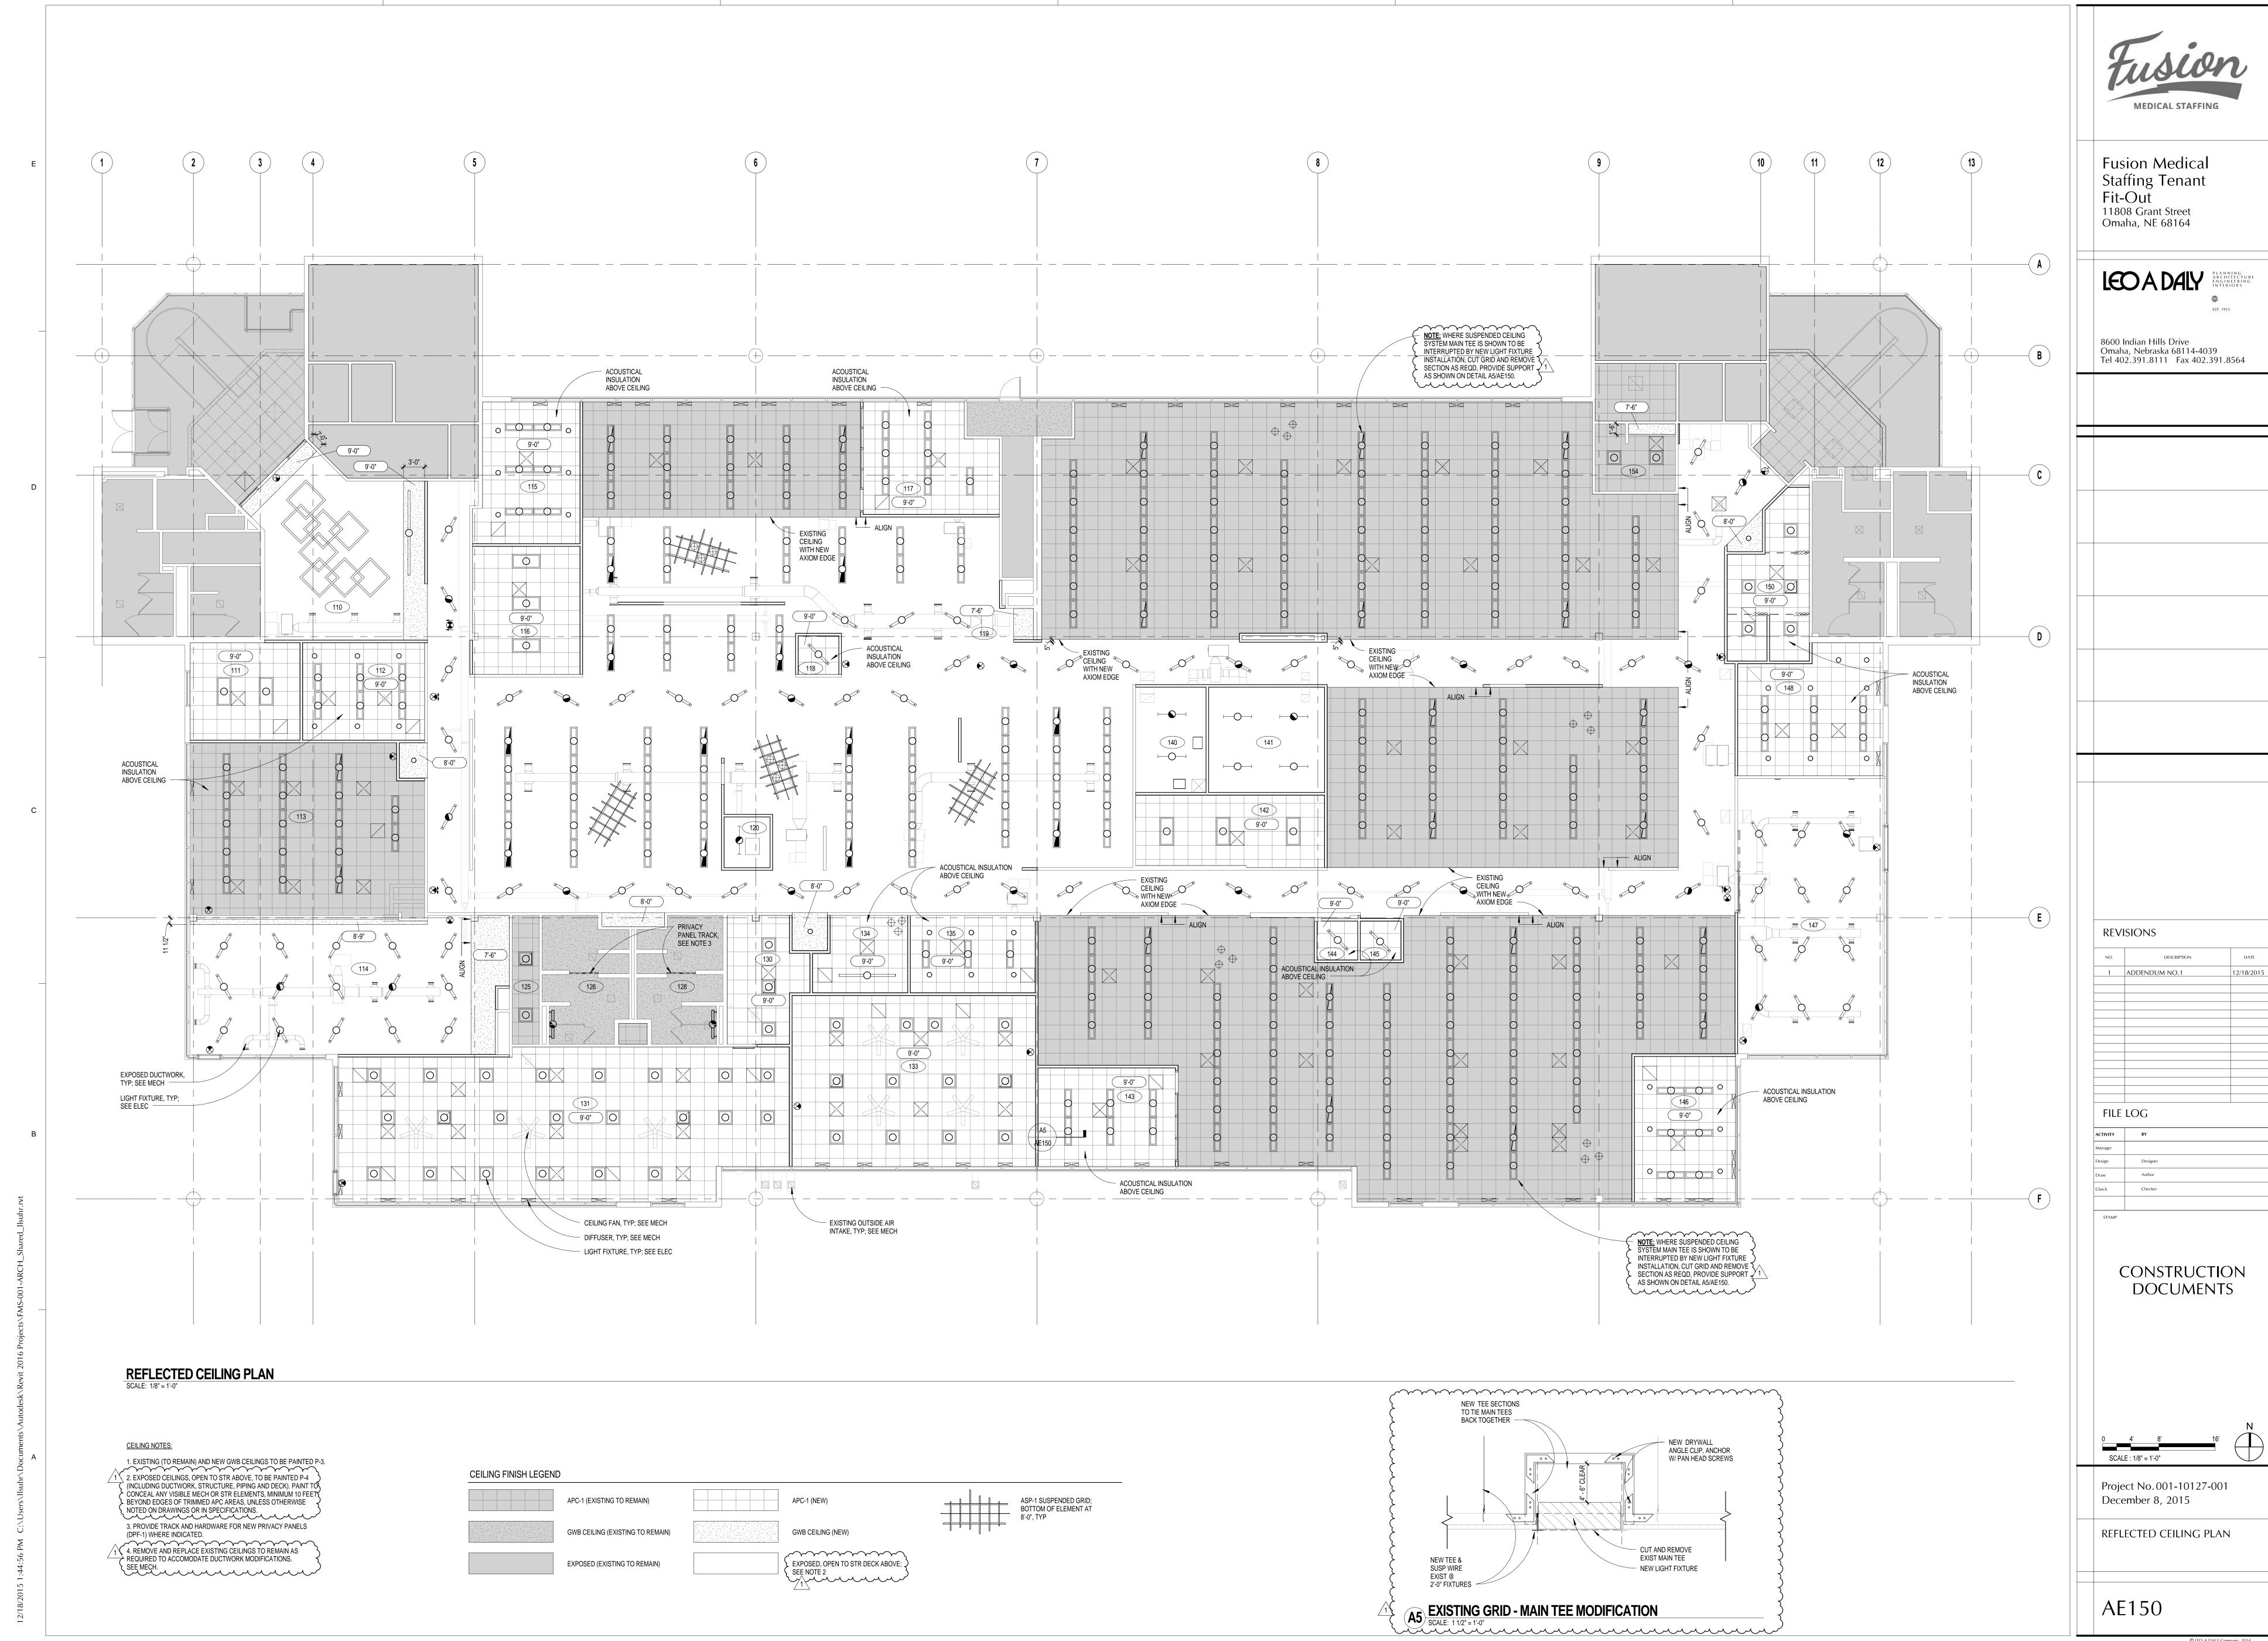


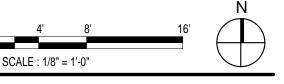

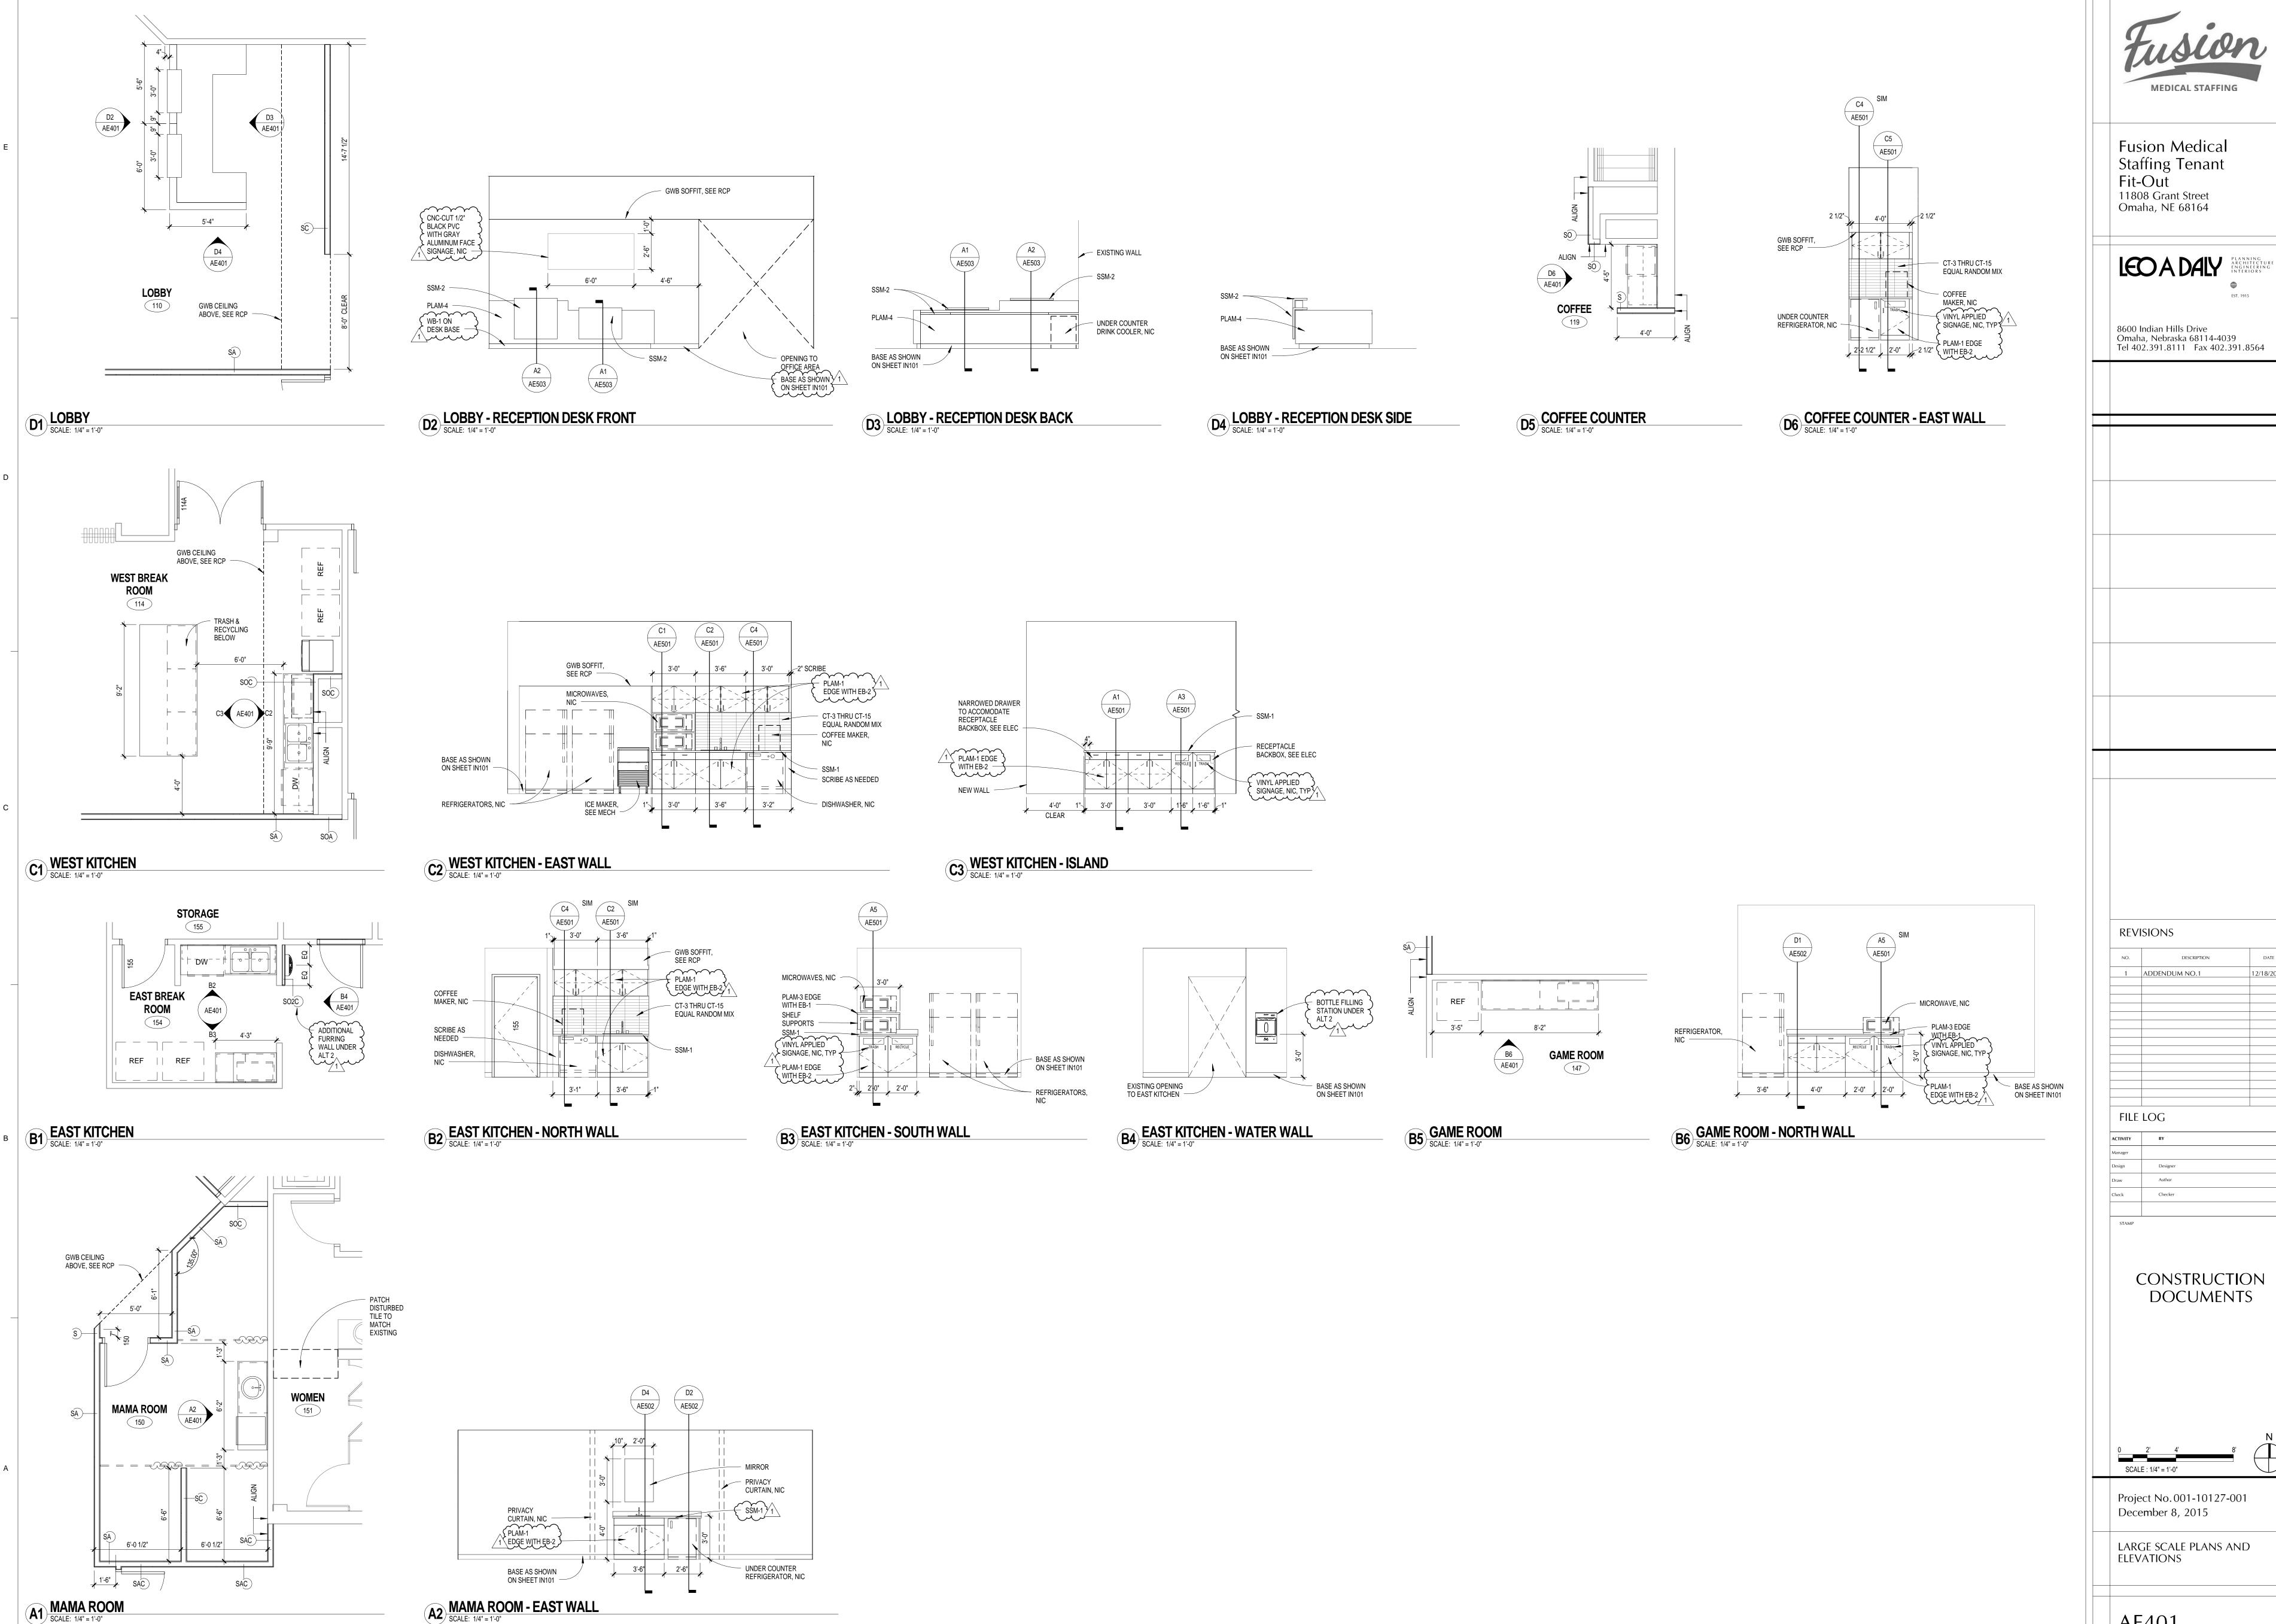

CONSTRUCTION DOCUMENTS Project No. 001-10127-001 December 8, 2015 LARGE SCALE PLANS AND ELEVATIONS AE401

12/18/2015

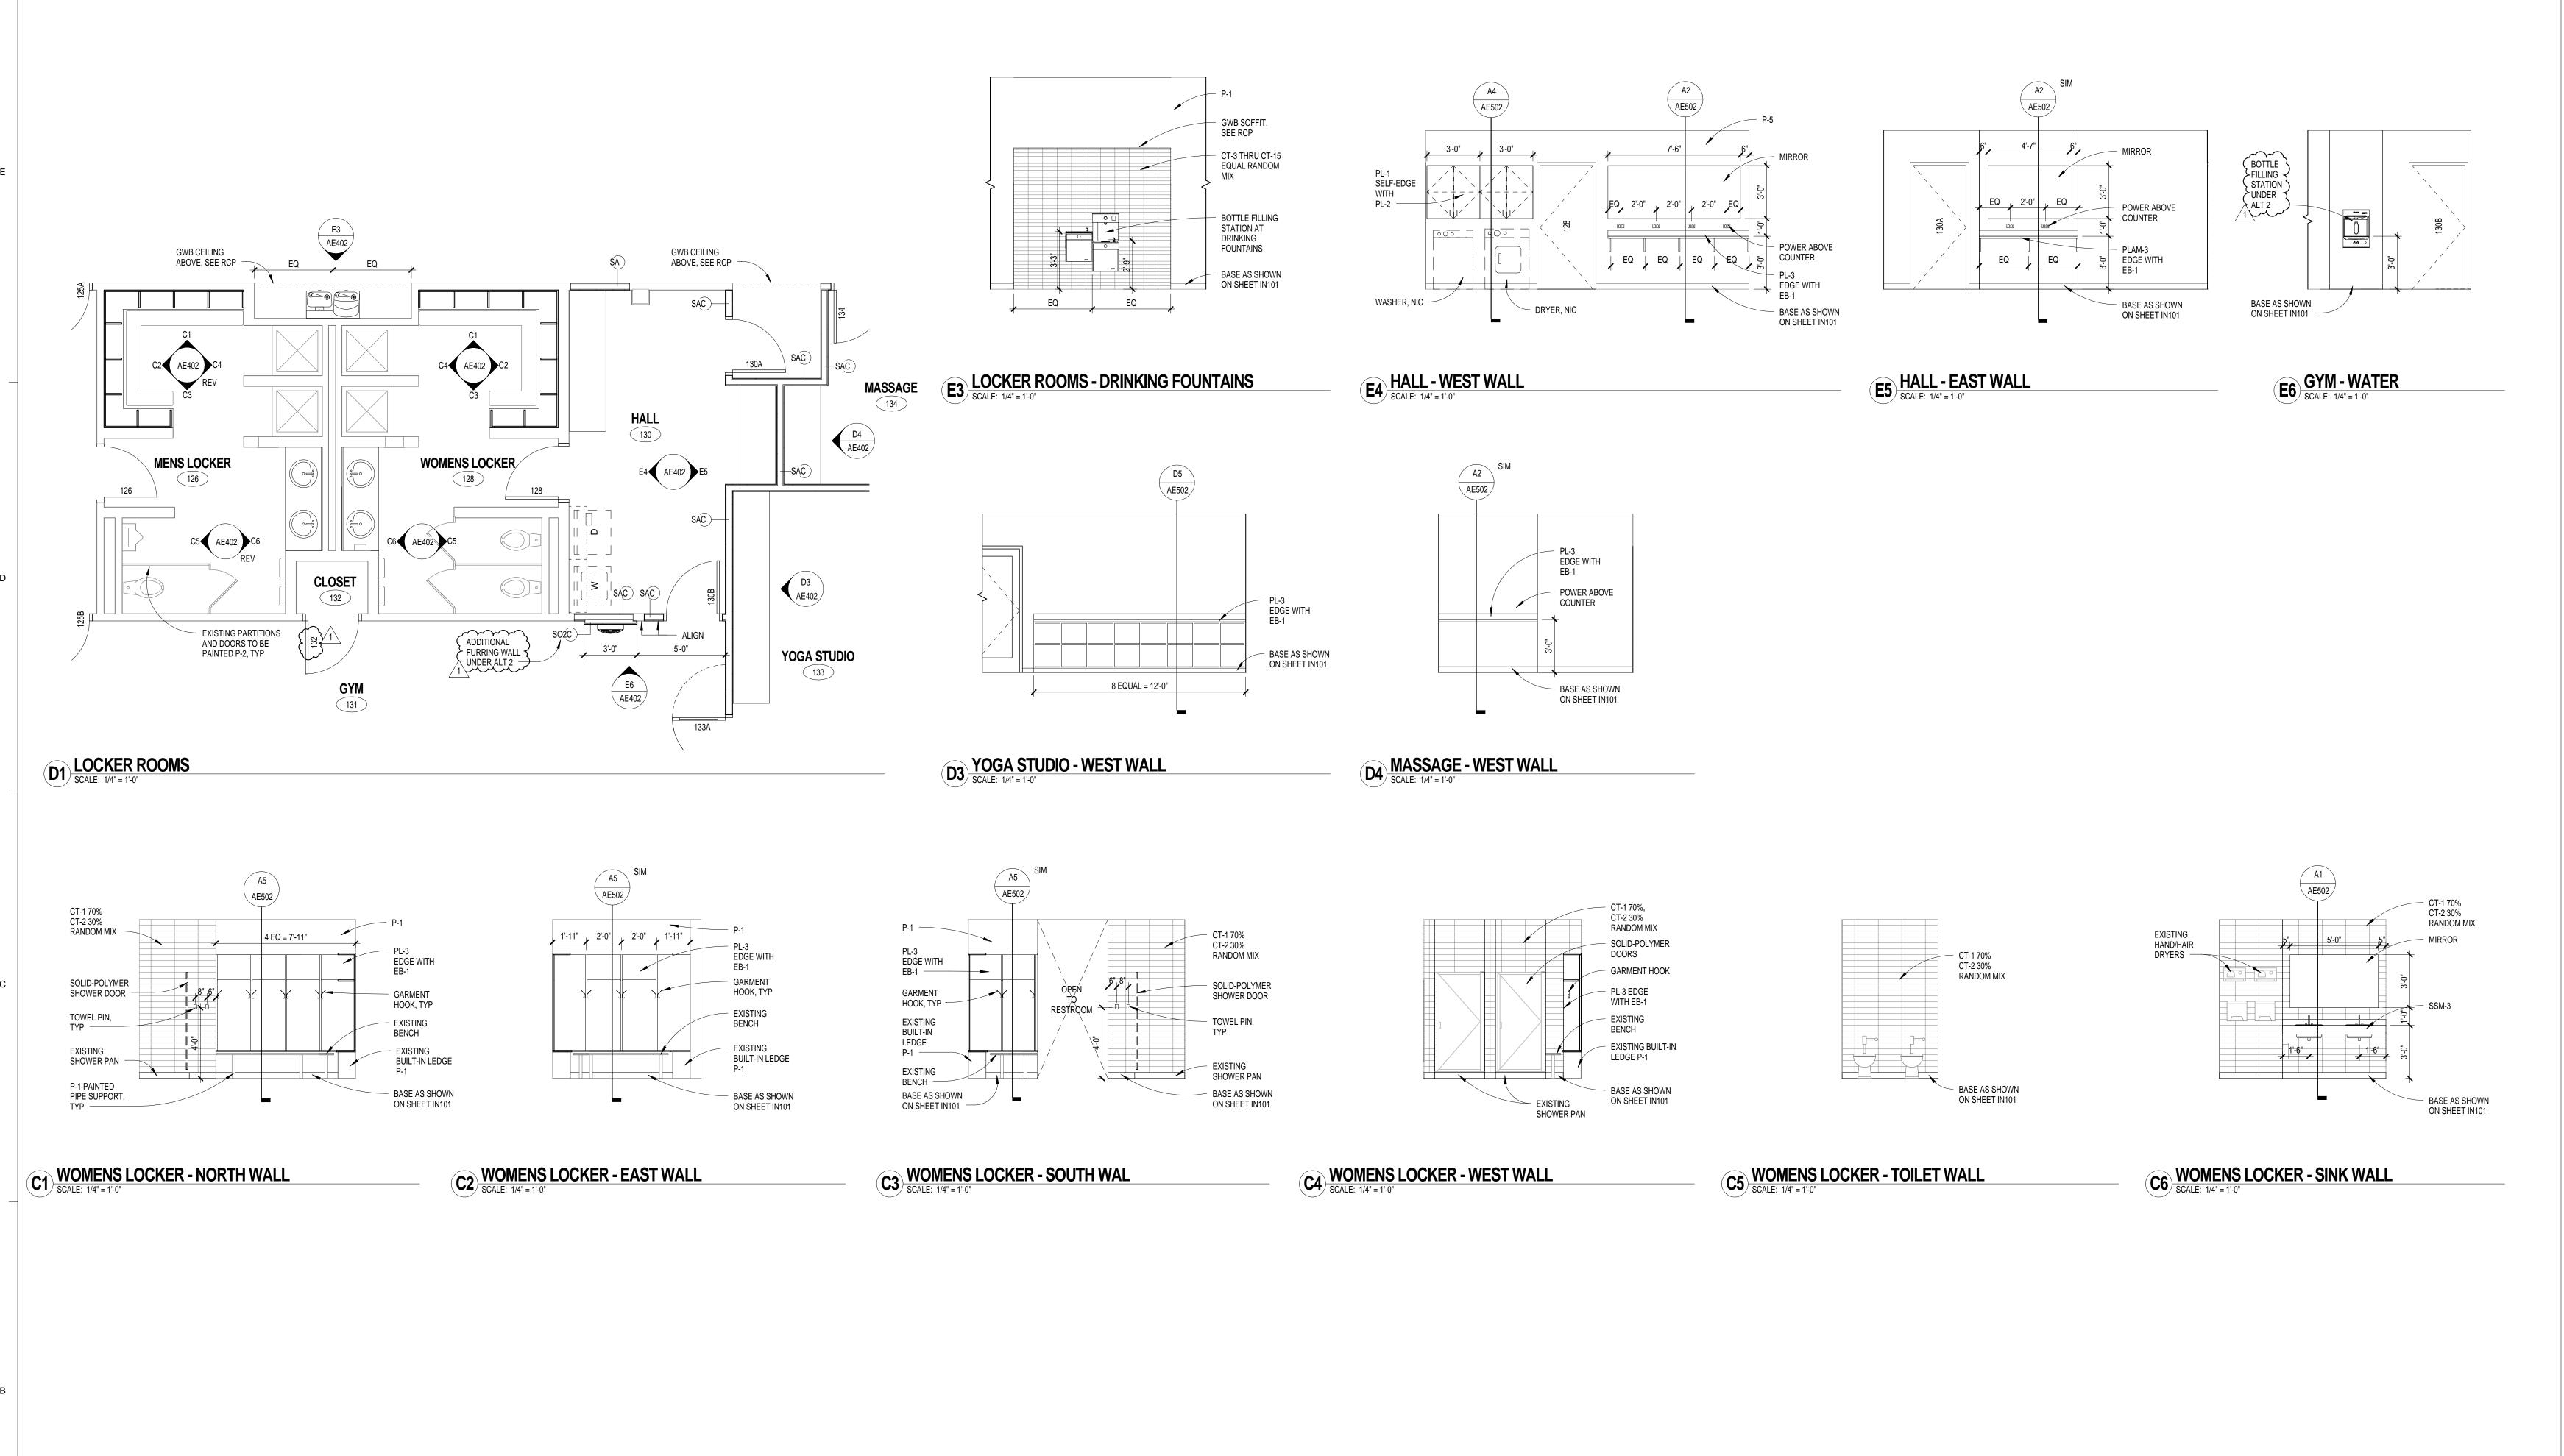



Fusion Medical Staffing Tenant Fit-Out 11808 Grant Street Omaha, NE 68164

LEGADALY PLANNING ARCHITECTURE ENGINEERING INTERIORS

8600 Indian Hills Drive Omaha, Nebraska 68114-4039 Tel 402.391.8111 Fax 402.391.8564

REVISIONS

DATE 12/18/2015 1 ADDENDUM NO.1

FILE LOG

ACTIVITY BY


Manager

Design Designer

Draw Author

Check Checker


CONSTRUCTION DOCUMENTS

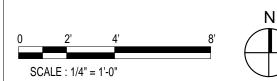


Project No. 001-10127-001 December 8, 2015


LARGE SCALE PLANS AND ELEVATIONS

AE402

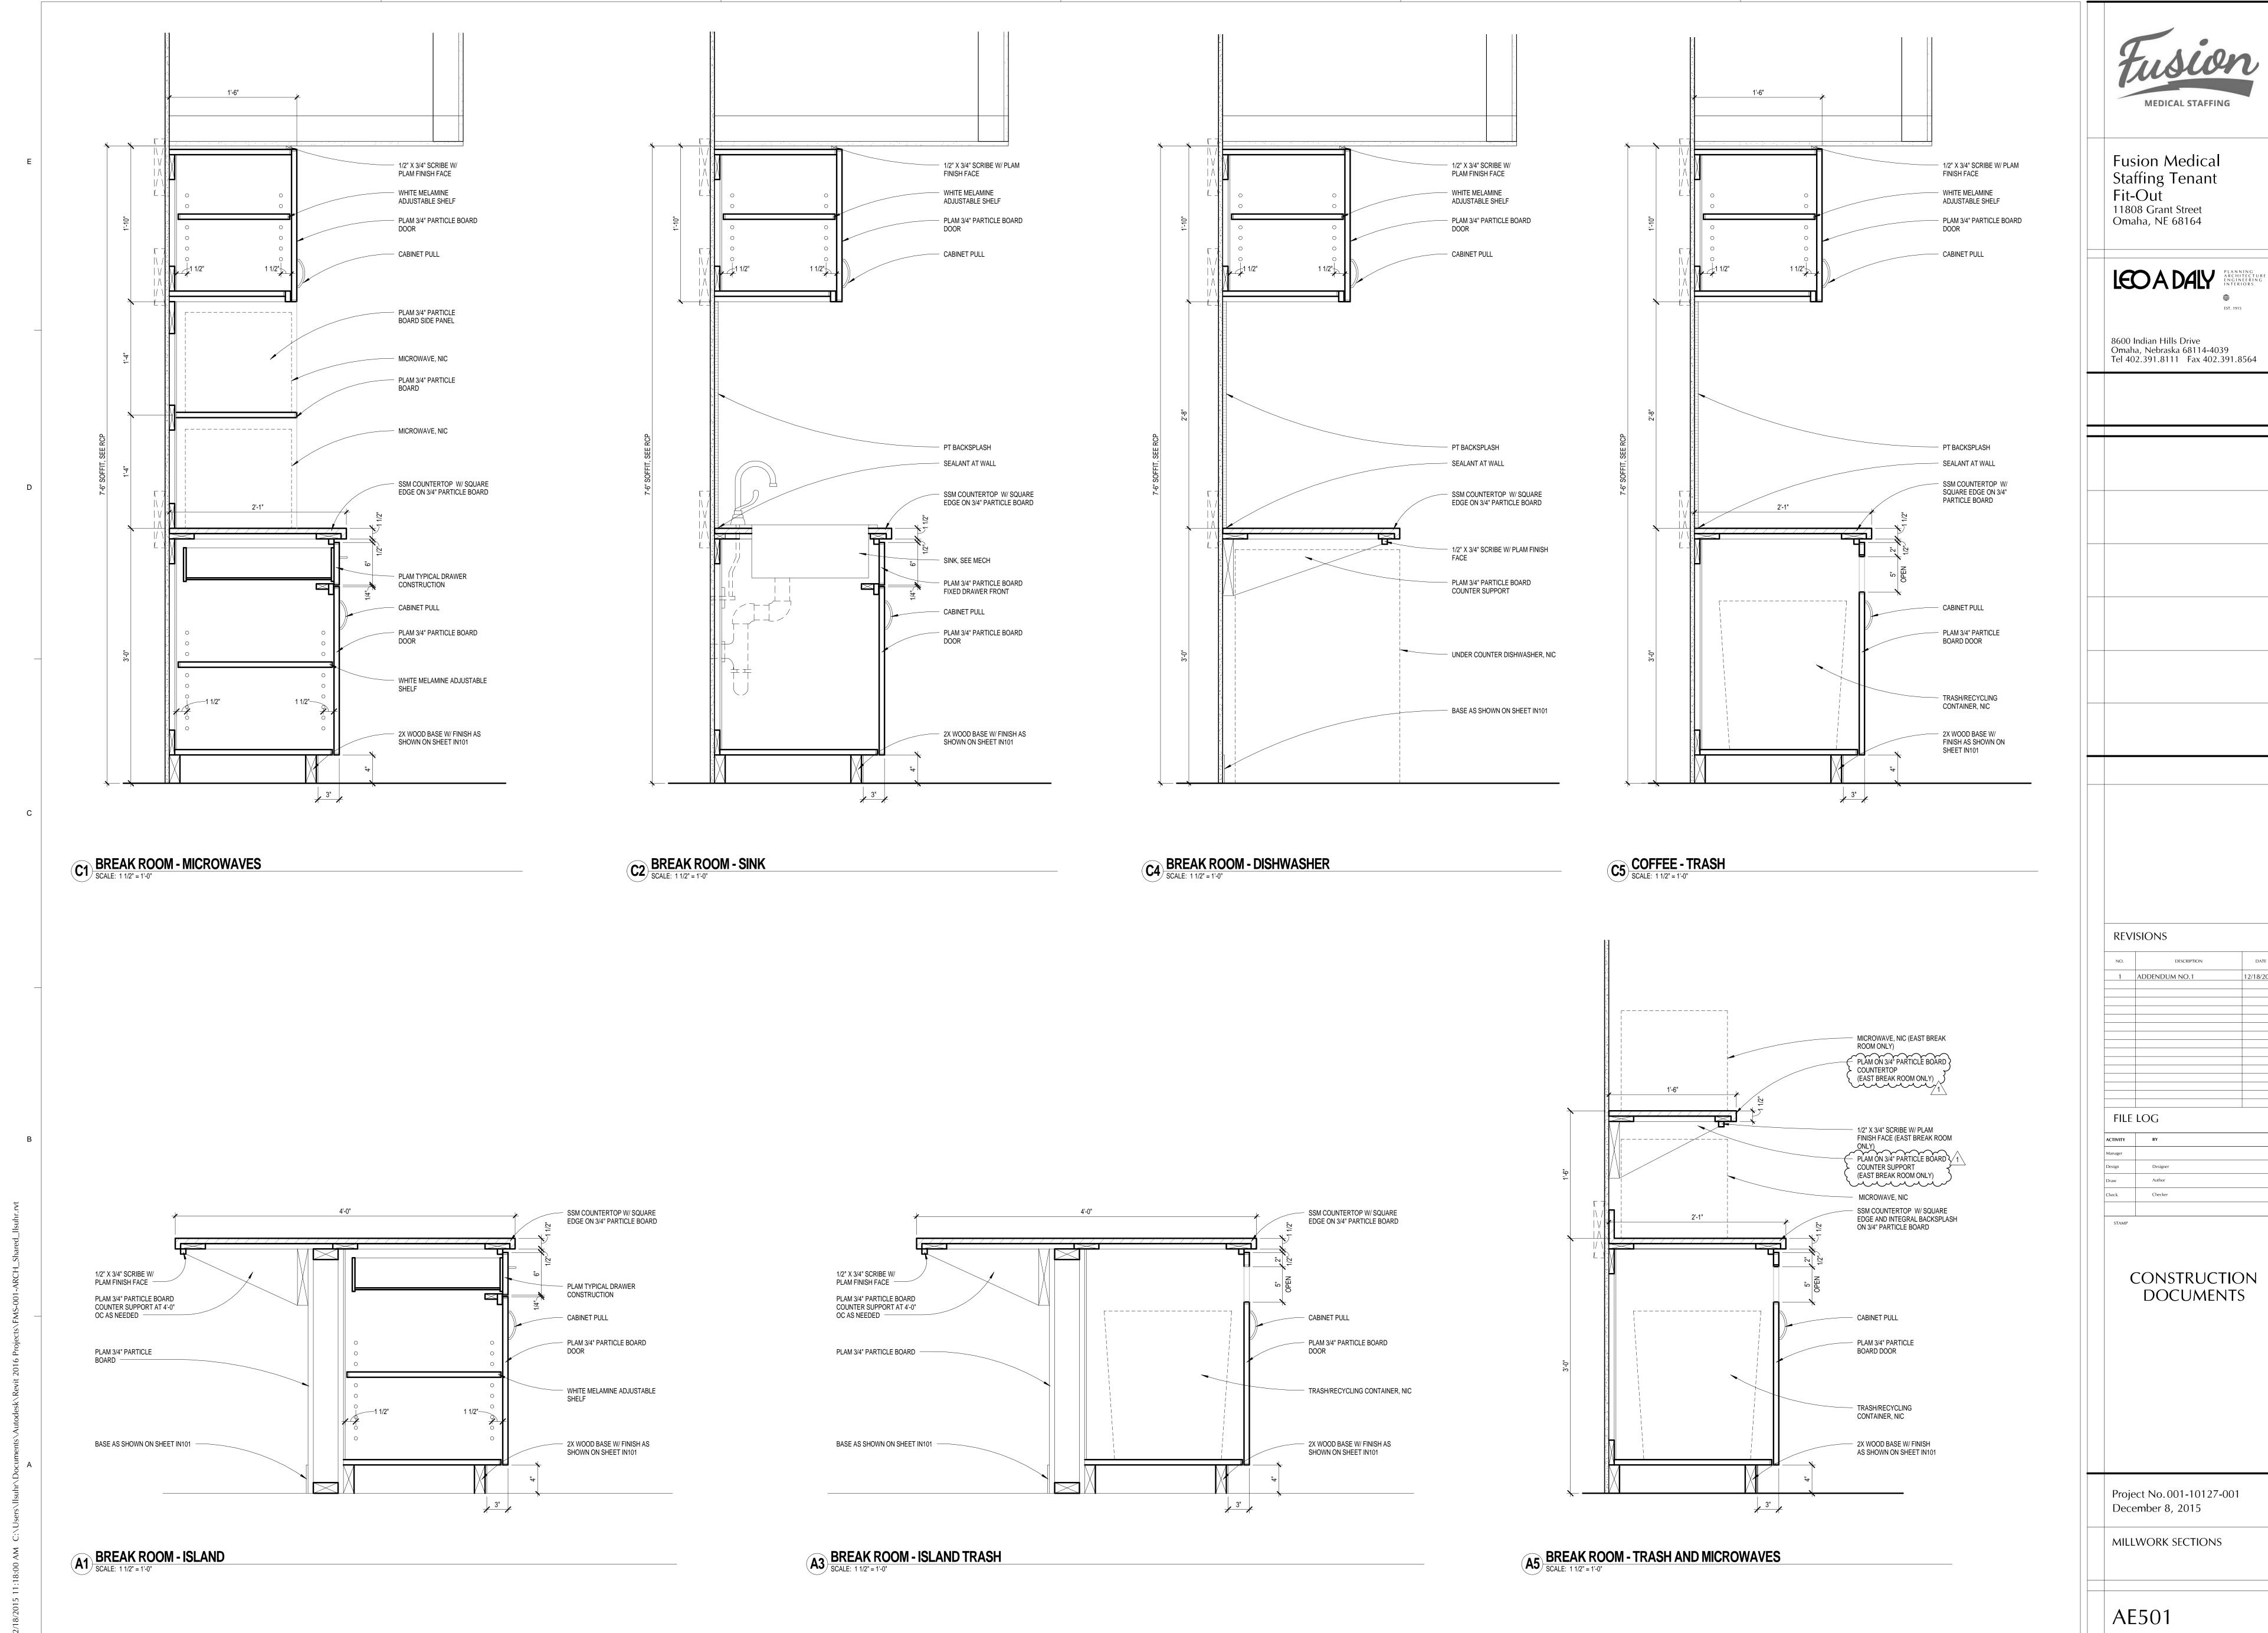

DATE 12/18/2015

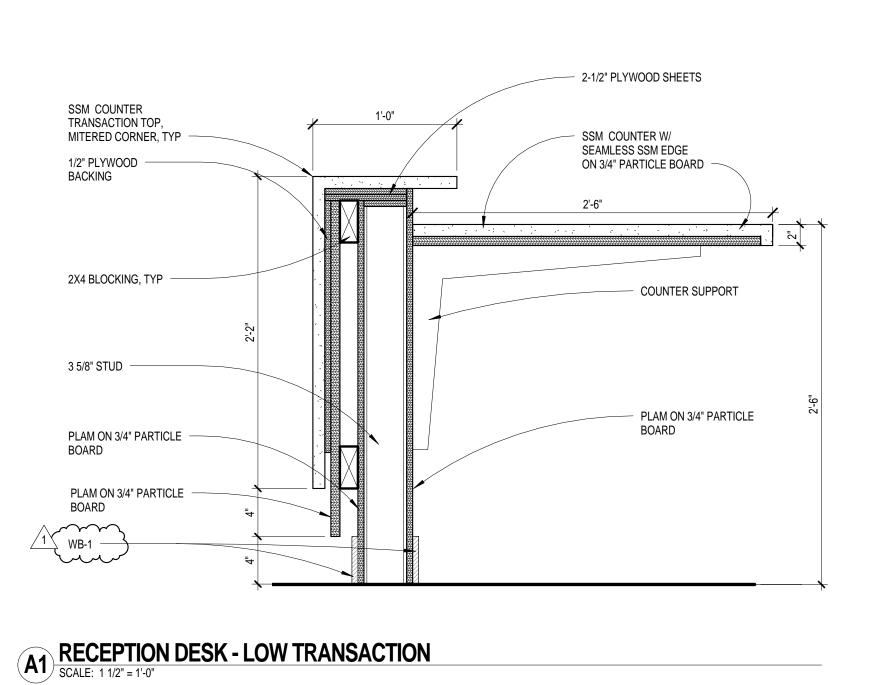

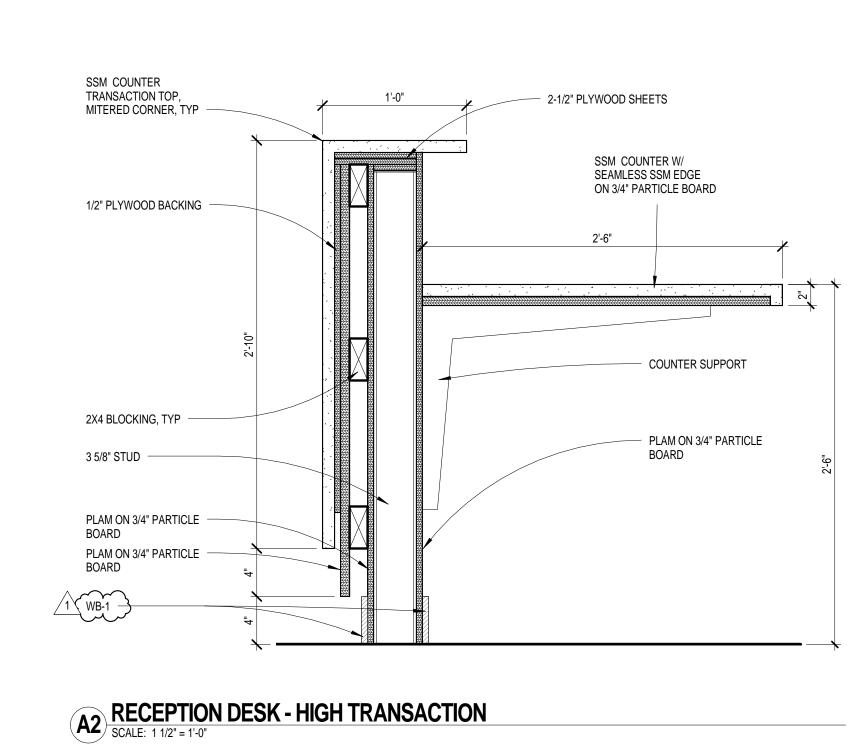

KEY PLAN REVISIONS 12/18/2015 FILE LOG Manager

Design Designer


Draw Author

Check Checker CONSTRUCTION DOCUMENTS Project No. 001-10127-001 December 8, 2015 MILLWORK SECTIONS AE503

Fusion Medical Staffing Tenant Fit-Out 11808 Grant Street Omaha, NE 68164 Fusion Medical
Staffing, LLC
11506 Nicholas St, Suite 110
Omaha, NE 68154 LEOA DALY

PLANNING ARCHITECTURE ENGINEERING INTERIORS 8600 Indian Hills Drive Omaha, Nebraska 68114-4039 Tel 402.391.8111 Fax 402.391.8564

									DOC	OR SCHED	ULE		
DOOR NO	ROOM NAME	DOOF WIDTH	HEIGHT	HDWE SET	TYPE	DOOR MAT'L	FIN	TYPE	FRAMI MAT'L	FIN	SIGN TYPE (NIC)	LABEL HOUR	
~~~											~~~~~~~~~~~~~~~~~~~~~~~~~~~~~~~~~~~~~~	$\sim$	~~~~~~~~~~~~~~~~~~~~~~~~~~~~~~~~~~~~~~
104	HALL	3'-0"	7'-0"	ببتل	ىر بىر بىرل	ىر بىر بىرا		·	\ <u>-</u>	 	~~~~~~~~~~~~~~~~~~~~~~~~~~~~~~~~~~~~~~	,,	EXISTING DOOR; DI-NOC (3M FILM) COVERED, HARDWARE TO BE REINSTALLED EXISTING DOOR; NEW HARDWARE, DI-NOC (3M FILM) COVERED
105	LOBBY	3'-0"	7'-0"	1							A-1, "RESTROOMS"		EXISTING DOOR; NEW HARDWARE, DI-NOC (3M FILM) COVERED
110	LOBBY	PR 3'-0"	7'-9 1/2"	2	FG	HM	P-6	6	HM	P-6		60	
111	SUPPLIES	3'-0"	7'-0"	3	F	WD	S-1	1	HM	P-1			
112	CONFERENCE (6-8)	3'-0"	7'-0"	4	FG	WD	S-1	2	HM	P-1	A-1, "CONFERENCE"		
113	TRAINING	3'-0"	7'-0"	4	FG	WD	S-1	3	HM	P-1	A-1, "TRAINING"		
114A	WEST BREAK ROOM	PR 3'-0"	7'-0"	5	FG	WD	S-1	1	HM	P-1			
114B	WEST BREAK ROOM	3'-0"	7'-9 1/2"	6	HG	*	*	*	*	*			*EXTERIOR DOOR, TO MATCH EXISTING PATIO DOOR
115A	CONFERENCE (8-10)	3'-0"	7'-0"	4	FG	WD	S-1	2	HM	P-1	A-1, "CONFERENCE"		
115B	CONFERENCE (8-10)	3'-0"	7'-0"	4	F	WD	S-1	1	HM	P-1	A-1, "CONFERENCE"		
116	MARKETING STORAGE	3'-0"	7'-0"	8	F	WD	S-1	1	HM	P-1			
117	OFFICE	3'-0"	7'-9 1/2"	4	FG	WD	S-1	4	HM				
118	PHONE BOOTH	2'-8"	7'-0"	9	PD	WD	S-1				A-2, "PHONE BOOTH"		FRAMELESS POCKET DOOR
120	COMM	3'-0"	7'-0"	8	F	WD	S-1	1	НМ	P-1			
125A	HALL	3'-0"	7'-0"	10							A-1, "MEN"		EXISTING DOOR; NEW HARDWARE, DI-NOC (3M FILM) COVERED
125B	HALL	3'-0"	7'-0"	10							A-2, "GYM"		EXISTING DOOR; NEW HARDWARE, DI-NOC (3M FILM) COVERED
126	MENS LOCKER	3'-0"	7'-0"	10							A-2, "LOCKERS"		EXISTING DOOR; NEW HARDWARE, DI-NOC (3M FILM) COVERED
128	WOMENS LOCKER	3'-0"	7'-0"	10							A-1, "LOCKERS"		EXISTING DOOR; NEW HARDWARE, DI-NOC (3M FILM) COVERED
130A	HALL	3'-0"	7'-0"	5	F	WD	S-1	1	НМ	P-1	A-2, "WOMEN"		
130B	HALL	3'-0"	7'-0"	5	F	WD	S-1	1	HM	P-1	A-2, "GYM"		
				6	HG.			*		1 -			*EXISTING DOOR
132	CLOSET	3'-0"	7'-0"	<u> </u>	4. <u>~~</u>	<u></u>	<u></u>	<del></del>	<del></del>	<del></del>	<del></del>	<del></del>	EXISTING DOOR: DI-NOC (3M FILM) COVERED HARDWARE TO BE REINSTALLED
133A	CLOSET YOGA STUDIO	PR 3'-0"	7-0"	11	TEG TO		<u> </u>				<del></del>		EXISTING DOOR; DI-NOC (3M FILM) COVERED, HARDWARE TO BE REINSTALLED \ 180-DEGREE DOOR SWING
133B	YOGA STUDIO	3'-0"	7'-0"	5	F	WD	S-1	1	HM	P-1			TOO BECKEE BOOK GWING
134	MASSAGE	3'-0"	7'-0"	12	F	WD	S-1	1	HM	P-1	A-1, "MASSAGE"		
135	CONFERENCE (6-8)	3'-0"	7'-0"	12	FG	WD	S-1	2	HM	P-1	A-1, "CONFERENCE"		
140	ELEC (0-0)	3'-0"	7'-0"	0	F	WD	S-1	1	HM	P-1	A-1, CONILICE		
141	IT	3'-0"	7'-0"	13	F	WD	S-1	1	HM	P-1	<b></b>		
	PAYROLL STORAGE	3'-0"	7'-0"	0	Г	WD	S-1	1	HM	P-1		<b></b>	
142				0	Г						<del></del>	<b></b>	
143	OFFICE	3'-0"	7'-9 1/2"	4	FG	WD	S-1	5	HM	P-1	A O UDUONE DOOTHU		EDAMELECC DOCKET DOOD
144	PHONE BOOTH	2'-8"	7'-0"	9	PD	WD	S-1				A-2, "PHONE BOOTH"		FRAMELESS POCKET DOOR
145	PHONE BOOTH	2'-8"	7'-0"	9	PD	WD	S-1				A-2, "PHONE BOOTH"		FRAMELESS POCKET DOOR
146	CONFERENCE (8-10)	3'-0"	7'-0"	4	FG	WD	S-1	2	HM	P-1	A-1, "CONFERENCE"		
147	GAME ROOM	6'-0"	8'-6"	14			*				A-1, "GAME ROOM"	(	EXISTING SLIDING DOOR, NEW PULL/LATCH HARDWARE ONLY, SECURE SLIDING GUIDE TO EXISITNG WALL AT THE FLOOR AFTER FINISHES AND WALL BASE ARE INSTALLED, *PAINT GAME ROOM-FACING PANEL P-2, PAINT OFFICE-FACING PANEL P-1 PRIOR TO ARCYLIC GRAPHIC APPLICATION
147A	GAME ROOM	3'-0"	7'-0"	5	F	WD	S-1	1	НМ	P-1			
147B	GAME ROOM	3'-0"	7'-9 1/2"	*	HG	*	*	*	*	*			*EXISTING DOOR
147C	GAME ROOM	3'-0"	7'-9 1/2"	*	HG	*	*	*	*	*			*EXISTING DOOR
148	CONFERENCE (10-12)	3'-0"	7'-0"	4	FG	WD	S-1	2	НМ	P-1	A-1, "CONFERENCE"		
150	MAMA ROOM	3'-0"	7'-0"	4	F	WD	S-1	1	НМ	P-1	A-1, "MAMA ROOM"		
155	STORAGE	3'-0"	7'-0"										EXISTING DOOR; DI-NOC (3M FILM) COVERED, HARDWARE TO BE REINSTALLED
156	ELEV EQUIP	3'-0"	7'-0"										EXISTING DOOR; DI-NOC (3M FILM) COVERED, HARDWARE TO BE REINSTALLED
160	EAST STAIR	PR 3'-0"	7'-0"									60	EXISTING DOOR; DI-NOC (3M FILM) COVERED, HARDWARE TO BE REINSTALLED

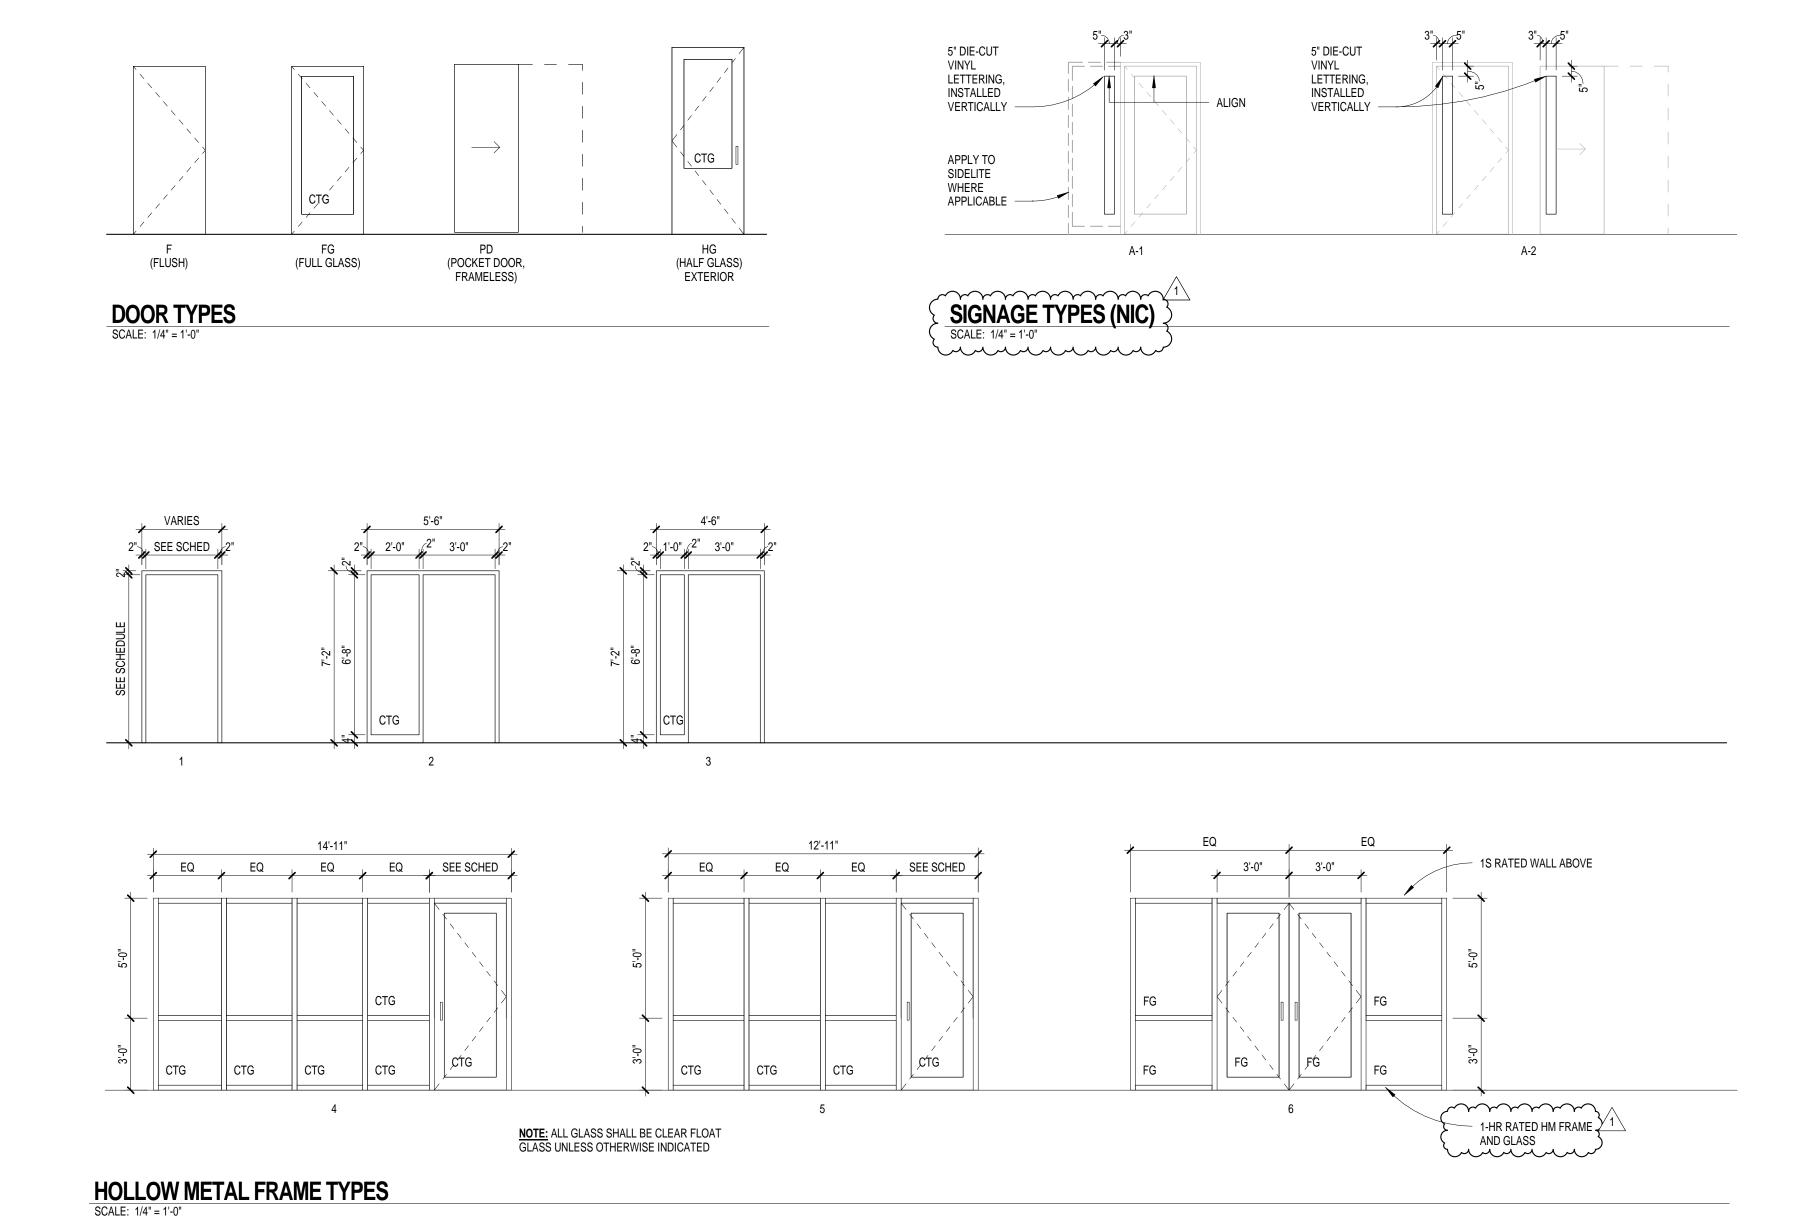



Fusion Medical Staffing Tenant Fit-Out 11808 Grant Street Omaha, NE 68164

LEOA DALY

PLANNING ARCHITECTURE ENGINEERING INTERIORS

8600 Indian Hills Drive Omaha, Nebraska 68114-4039 Tel 402.391.8111 Fax 402.391.8564

REVISIONS								
NO.	DESCRIPTION	DATE						
1	ADDENDUM NO.1	12/18/2015						

FILE LOG

ACTIVITY	ВУ
Manager	
Design	Designer
Draw	Author

STAMP


CONSTRUCTION DOCUMENTS

0 2' 4' 8' SCALE: 1/4" = 1'-0"

Project No. 001-10127-001 December 8, 2015

DOOR SCHEDULE AND TYPES

AE601

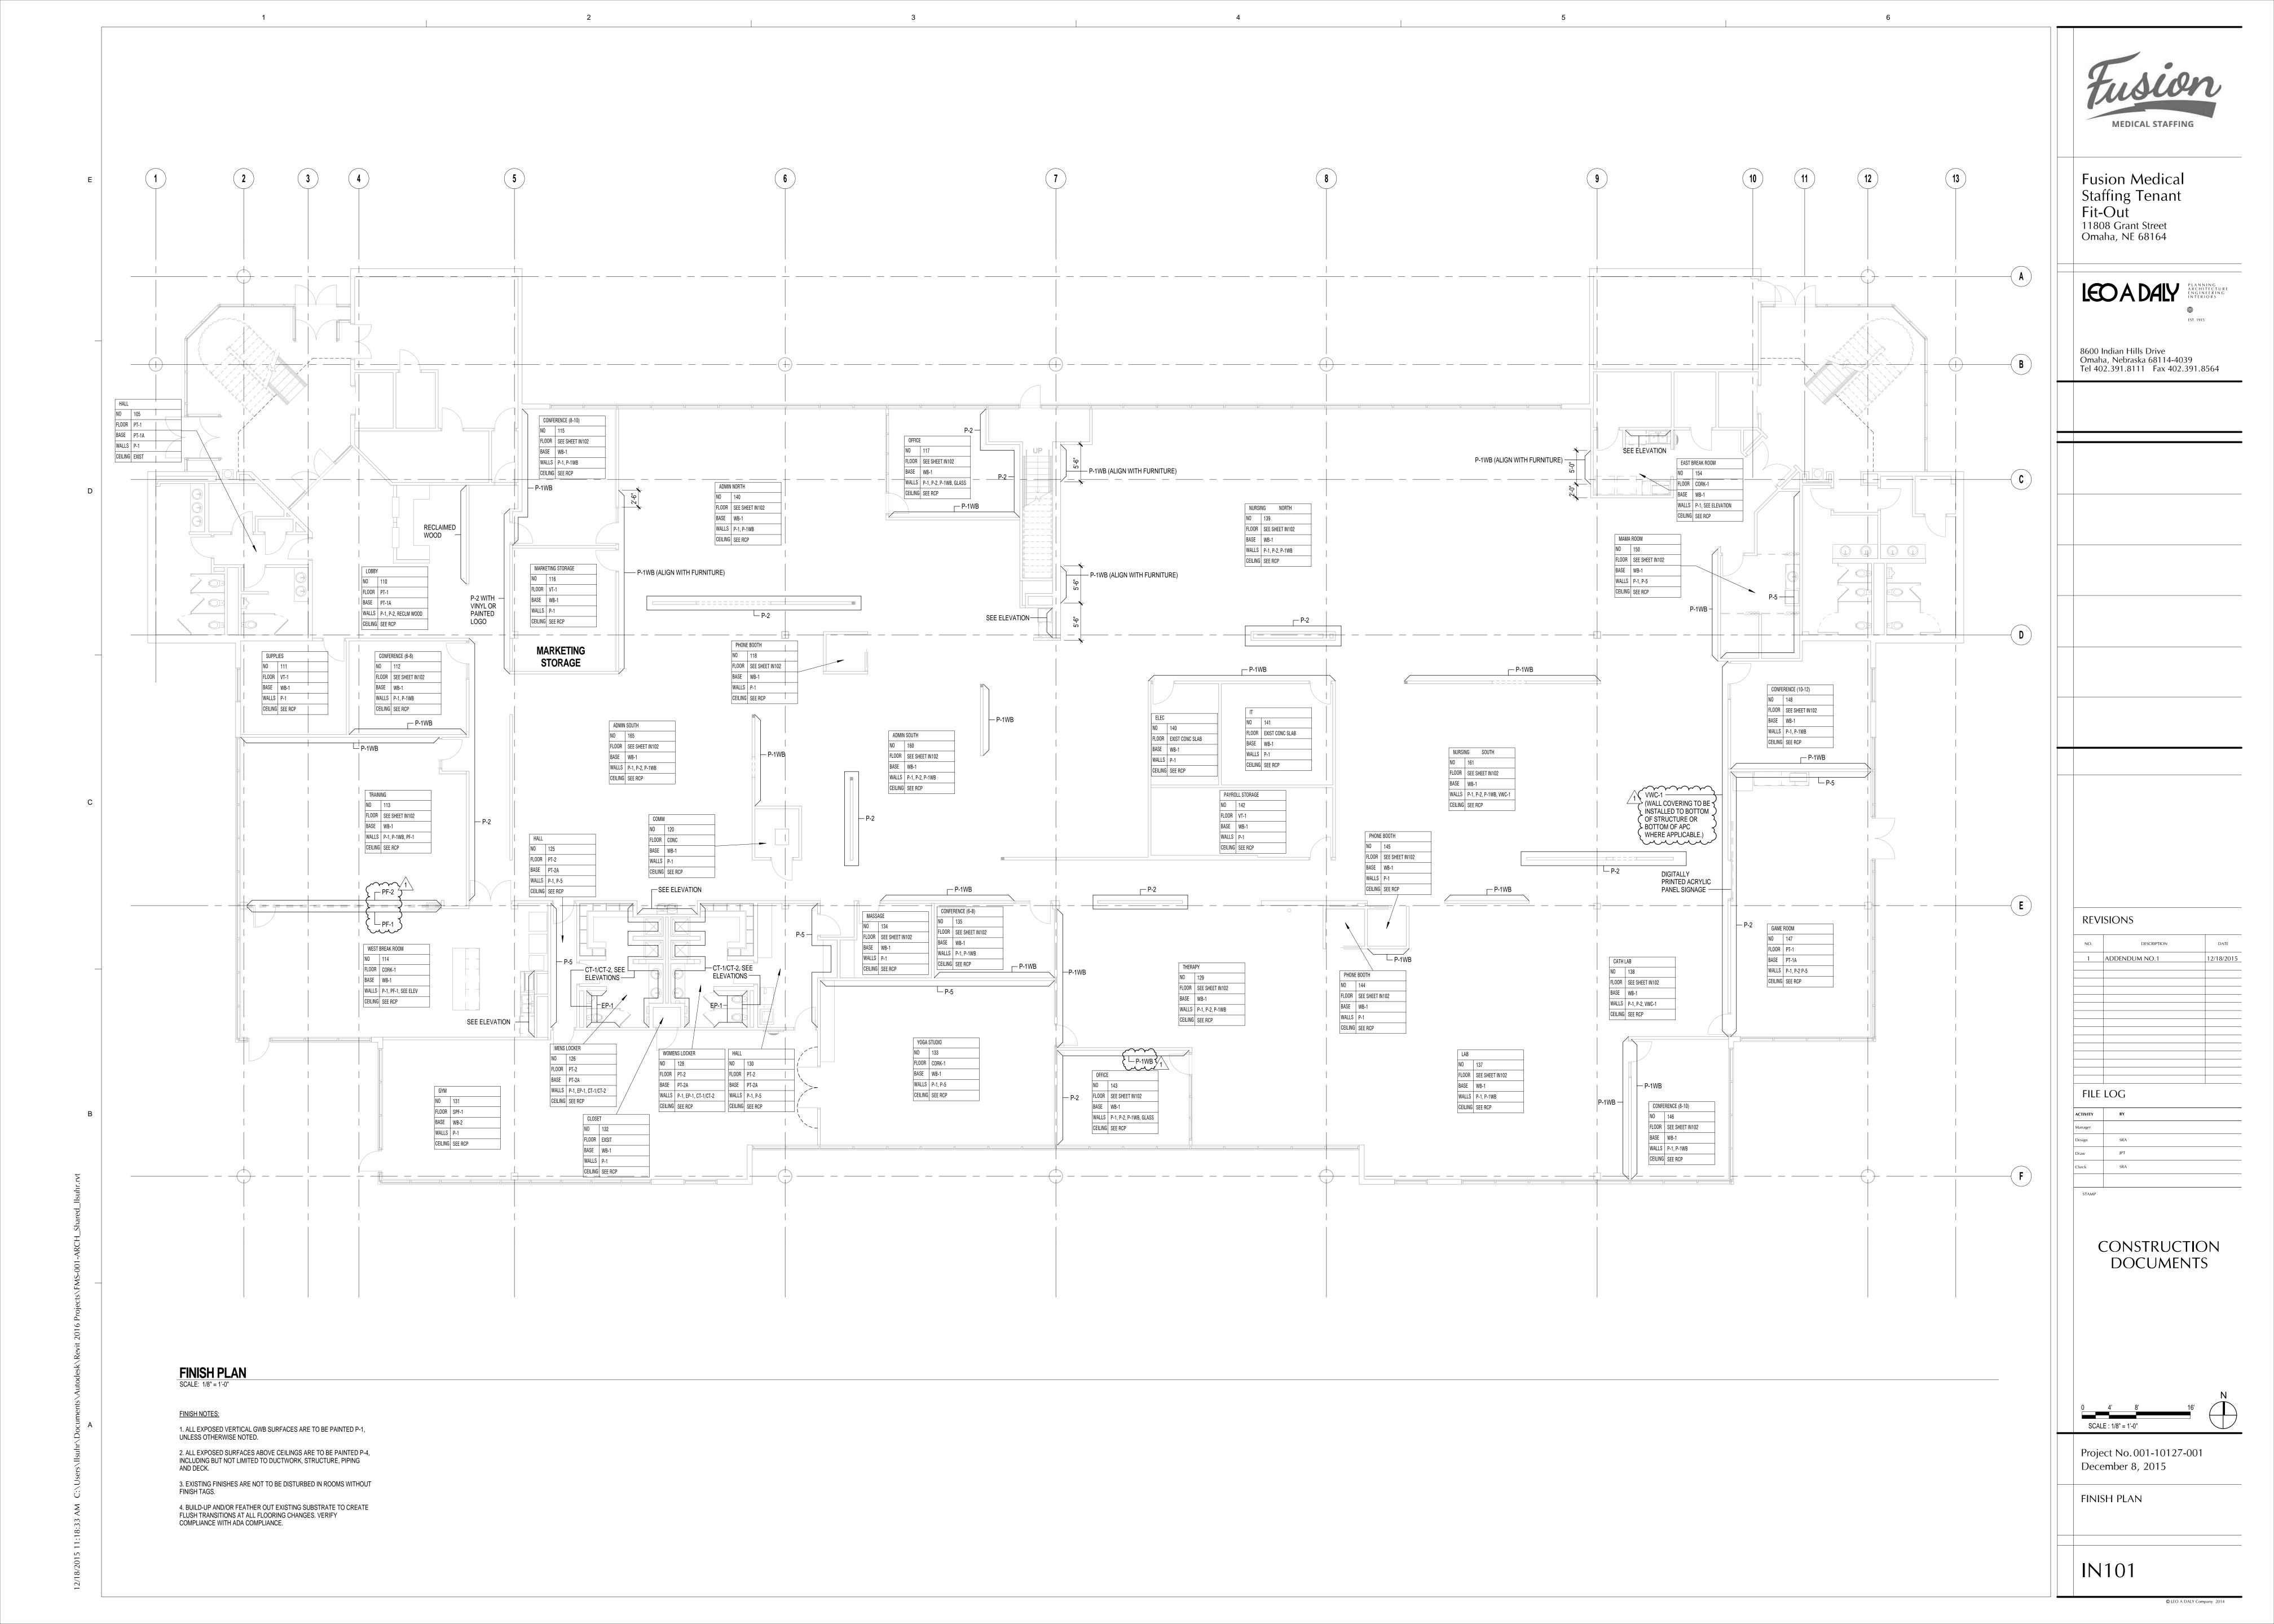



1 ALL WORK AND EQUIPMENT SHALL MEET THE REQUIREMENTS OF THE MOST RECENTLY REVISED VERSION OF ALL APPLICABLE CODES, LAWS, RULES, REGULATIONS AND ORDINANCES OF LOCAL AUTHORITIES. WHETHER INDICATED ON THE DRAWINGS OR NOT 2 CONTRACTOR TO PROVIDE ALL REQUIRED EQUIPMENT, MATERIALS AND LABOR TO

ESTABLISH A COMPLETE AND OPERABLE MECHANICAL SYSTEM AS DESCRIBED ON THE

3 ADHERE TO THE DRAWINGS WHEN REQUIREMENTS ARE STRICTER THAN CODE REQUIREMENTS AND ARE PERMITTED UNDER THE CODE. ALL EQUIPMENT SHALL BE

DRAWINGS AND SPECIFICATIONS.

- INSTALLED PER EQUIPMENT MANUFACTURERS RECOMMENDATIONS. 4 REPORT ANY ALTERATION TO AND/OR DEVIATIONS FROM THE DRAWINGS. AS REQUIRED BY THE ABOVE AUTHORITIES, TO THE ARCHITECT AND SECURE HIS APPROVAL BEFORE
- 5 THE CONTRACTOR SHALL REQUEST SUPPLEMENTARY INSTRUCTIONS FROM THE ARCHITECT IN ALL CASES OF DOUBT, AS TO THE WORK INTENDED, OR IF ADDITIONAL

EQUIPMENT CAN BE REMOVED WITHOUT DISMANTLING ALL PIPING.

- EXPLANATION IS NEEDED. 6 INSTALL FLANGES OR UNIONS AT PIPING CONNECTIONS TO ALL EQUIPMENT SUCH THAT
- 7 ALL CONCEALED PIPING SHALL BE INSULATED. 8 COORDINATE ALL MECHANICAL WORK (HVAC, PLUMBING, FIRE PROTECTION, ETC.) WITH ARCHITECTURAL. STRUCTURAL AND ELECTRICAL WHICH MAY DESIGNATE WORK TO BE ACCOMPLISHED. OFFSETS IN DUCTWORK AND OR PIPING TO BYPASS OBSTRUCTIONS SHALL BE AT NO ADDITIONAL COST TO OWNER. ENSURE LOCATIONS WHICH MAY REQUIRE ACCESS PANELS TO GAIN SERVICE FOR DAMPERS, VALVES, SMOKE
- ELECTRICAL, ETC. 9 ALL THERMOSTATS (AND SIMILAR DEVICES) SHALL BE MOUNTED 48" ABOVE FINISH FLOOR UNLESS NOTED. DO NOT INSTALL THERMOSTAT ABOVE DIMMER. 10 REFER TO BUILDING STANDARD AND SPECIFICATION IF ANY DISCREPANCIES OCCUR. 11 PROVIDE HANGERS TO SUPPORT REQUIRED LOADS (MECH EQUIPMENT, DUCTWORK PIPING, ETC.). WHERE NECESSARY, SUPPORTS SHALL BE DESIGNED TO PERMIT MOVEMENT DUE TO EXPANSION AND CONTRACTION. PROVIDE VIBRATION ISOLATORS WHERE APPLICABLE TO PREVENT TRANSMISSION OF VIBRATION TO BUILDING STRUCTURE. HANGER SUPPORT APPLICATIONS SHALL COMPLY WITH MSS STANDARDS (MANUFACTURERS STANDARDIZATION SOCIETY) AND ANSI (AMERICAN STANDARD CODE FOR PRESSURE PIPING). DIELECTRIC PROTECTION - FURNISH ACCEPTABLE PROTECTION OR COPPER PLATED HANGERS BETWEEN FERROUS AND NONFERROUS METAL PIPE AND
- 12 ALL MECHANICAL AND ELECTRICAL EQUIPMENT INCLUDING BUT NOT LIMITED TO: COMPONENTS ASSOCIATED SUPPORT CONNECTIONS AND BRACING SHALL BE DESIGNED BY THE MANUFACTURER TO MEET THE SEISMIC DESIGN REQUIREMENTS OF CHAPTER 16 OF THE IBC 2003 AND THE APPLICABLE VERSION OF ASCE-7.
- 13 CONTROL WIRING AND CONDUIT SHALL MEET REQUIREMENTS OF THE NATIONAL ELECTRIC CODE (NEC).

HANGERS ON ALL PIPING AND OR DUCTWORK.

- 14 PROVIDE SHOP DRAWING FOR ALL EQUIPMENT ITEMS. 15 ALL PIPE PENETRATIONS THROUGH WALLS AND FLOORS SHALL BE PROVIDED WITH SLEEVES AND ESCUTCHEON PLATES. PIPES SHALL BE CENTERED TO ALLOW FOR EXPANSION AND CONTRACTION. PROVIDE CAULKING AND WATERPROOFING WHERE
- REQUIRED 16 ALL PIPING THAT PENETRATES FLOOR SLAB SHALL BE WATERPROOFED BY A CERTIFIED WATERPROOFING COMPANY.
- 17 PENETRATIONS IN RATED WALLS (DUE TO DUCTWORK, PIPING, ETC.) SHALL BE APPROPRIATELY SEALED TO MAINTAIN WALL INTEGRITY. 18 FULL ACCESS AND MANUFACTURER'S RECOMMENDED CLEARANCES SHALL BE
- PROVIDED TO ALL EQUIPMENT, VALVES, AND OTHER SERVICEABLE ITEMS OF EQUIPMENT. EXAMPLES INCLUDE WATER CONTROL VALVES, SEWERS, TRAPS, FLUID CONNECTIONS, MOTORS, DAMPERS, ELECTRONIS COMPONENTS, OR ANY COMPONENTS
- REQUIRING ADJUSTMENT, SERVICE OR INSPECTION. 19 ALL SCHEDULED EQUIPMENT SHALL BE PROVIDED BY MANUFACTURER NOTED OR

MECHANICAL SYSTEM (EQUIPMENT, MATERIAL, ETC.) SHALL BE WARRANTED AGAINST DEFECTS OR UNUSUAL WEAR FOR A TIME PERIOD OF TWO YEARS FROM SUBSTANTIAL COMPLETION. ALL ITEMS THAT BECOME DEFECTIVE WITHIN THAT PERIOD OF TIME

SHALL BE FIXED OR REPLACED AT NO ADDITIONAL COST TO THE OWNER. WARRANTY

#### **PERMITS**

INCLUDES CORRECTION OF FAULTY WORKMANSHIP

1 CONTRACTOR IS RESPONSIBLE FOR OBTAINING ALL PERMITS, FEES, LICENSES. INSPECTIONS, ETC. AS REQUIRED BY LOCAL AUTHORITIES, REGULATIONS AND UTILITY COMPANIES.

### 1 - DUCTWORK SPECIFICATIONS

- A. ALL HVAC SUPPLY, RETURN, AND EXHAUST AIR DUCTWORK SHALL BE CONSTRUCTED AS FOLLOWS: LOW PRESSURE - CLASS 2" W.G. AND SEALED TO SEAL CLASS A.
- B. DUCTWORK SHALL CONFORM TO NFPA STANDARD 90-A AND THE REQUIREMENTS OF SMACNA. ALL DUCTWORK SEAMS SHALL BE SEALED TO CLASS A. TYPE RE4 ELBOWS AND STRAIGHT TAPS FOR RECTANGULAR DUCTWORK ARE NOT PERMITTED. PROVIDE TURNING VANES IN MITERED DUCT ELBOWS. SUPPLY DUCTWORK SHALL RUN IN MOST DIRECT ROUTE POSSIBLE WITH A MINIMUM NUMBER OF BENDS. TAKEOFFS TO DIFFUSERS SHALL BE MADE WITH A MAXIMUM OF 24 INCHES OF FLEXIBLE DUCT AND HAVE NO GREATER THAN 90 DEGREES TOTAL CHANGE OF DIRECTION. CLEAN ALL DUCT INTERIORS OF DEBRIS. INSIDE RADIUS OF ALL CURVES AND BENDS SHALL NOT BE LESS THAN THE WIDTH OF DUCTS IN PLANE OF BEND, BELOW THIS RADIUS, SQUARE ELBOWS WITH TURNING VANES SHALL BE USED, PROVIDE MANUAL VOLUME DAMPERS IN EACH GRILLE AND DIFFUSER BRANCH DUCT AND WHERE SHOWN ON DRAWINGS. DAMPERS IN ROOM WITH OTHER THAN REMOVABLE TYPE CEILINGS UTILIZE YOUNG NO. 301 CONCEALED DAMPER REGULATORS. ALL DUCT SIZES INDICATED ON THE DRAWINGS ARE THE CLEAR INSIDE NET DIMENSIONS. INTERNALLY LINED DUCTWORK SHALL BE INCREASED IN BOTH DIMENSIONS BY TWICE THE THICKNESS OF THE LINER.
- C. THE FOLLOWING MINIMUM CONSTRUCTION MUST BE PROVIDED WITHOUT EXCEPTIONS: LONGITUDINAL SEAMS SHALL BE PITTSBURGH SEAM WITH SEALANT. DUCT JOINTS UP TO 18" SHALL BE DRIVE SLIP; OVER 18" SHALL BE EITHER STANDING SLIP, STANDING SEAM POINT OR POCKET LOCK, ALL WITH SEALANT. SHEET METAL TRANSITIONS SHALL BE
- D. CONTRACTOR SHALL VERIFY THAT DUCTWORK SHOWN WILL FIT IN THE ALLOTTED SPACE PRIOR TO FABRICATION. CONTACT ARCHITECT WHERE CONFLICTS OCCUR. E. DUCTWORK TO BE FIELD PAINTED WHERE EXPOSED.

MADE WITH SLOPES NOT EXCEEDING ONE (1) TO SEVEN (7).

# 2 - DUCT INSULATION SPECIFICATIONS

- ACCEPTABLE MANUFACTURERS: JOHNS MANVILLE, OWENS-CORNING, CGS AND KNAUFF, UNLESS OTHERWISE NOTED. ADHESIVES AND COATINGS SHALL BE AS MANUFACTURED BY INSULCOUSTIC, BENJAMIN-FOSTER OR APPROVED EQUAL.
- **INSULATE AS FOLLOWS:** 1. ALL EXHAUST DUCTWORK WITHIN 3 FT. OF ROOF. 1-1/2" THICK MINERAL FIBER
- BLANKET WRAP. 2. CONCEALED SUPPLY AIR DUCT: 1-1/2" THICK MINERAL FIBER BLANKET WRAP.
- 3. CONCEALED RETURN AIR DUCT: 1-1/2" THICK MINERAL FIBER BLANKET WRAP. 4. CONCEALED OUTDOOR DUCT: 1-1/2" THICK MINERAL FIBER BLANKET WRAP.
- 5 EXPOSED SUPPLY/RETURN/TRANSFER AIR DUCT: 1-1/2" THICK INTERNAL DUCT LINING, 1-1/2 LB. PER CU. FT. DENSITY. 6 ALL INSULATION SHALL HAVE A COMPOSITE (INSULATION, JACKET OR FACING, AND
- ADHESIVE USED TO ADHERE THE FACING OR JACKET TO THE INSULATION) FIRE AND SMOKE HAZARD RATING AS TESTED BY PROCEDURE ASTM E84, NFPA 255, AND UL 723 NOT EXCEEDING: FLAME
- SMOKE DEVELOPED 50 7 ACCESSORIES SUCH AS ADHESIVES, MASTICS, CEMENTS, AND TAPES SHALL HAVE
- THE SAME COMPONENT RATING AS LISTED ABOVE. 8 DIMENSIONS OF LINED DUCTS SHOWN ON DRAWINGS ARE THE CLEAR INSIDE DIMENSIONS OF THE DUCT AFTER THE LINING HAS BEEN INSTALLED.

## 3 - PACKAGED WATER TO AIR HEAT PUMPS

- FURNISH AND INSTALL ALL SUPPLEMENTARY OR MISCELLANEOUS ITEMS APPURTENANCES AND DEVICES INCEDENTAL TO OR NECESSARY FOR A SOUND, SECURE AND COMPLETE INSTALLATION. HEAT PUMP UNITS PACKAGED FOR SUSPENDED OPERATION, CAPABLE OF STARTING
- IN 40 DEGREE F AMBIENT WITH 55-110 DEGREE F ENTERING WATER, AND PROVIDING FAN DISCHARE IN 2 POSSIBLE CONFIGURATIONS. BASIC UNIT SHALL BE RATED IN ACCORDANCE WITH AHRI/ISO 13256-1. WARRANTIES SHALL CONSIST OF A STANDARD WARRANTY, 1 YEAR LIMITED PRODUCT WARRANTY AND 2-5 YEAR COMPRESSOR WARRANTY.
- FACTORY-TESTED AND ASSEMBLED SINGLE-PIECE PACKAGED HEATING AND COOLING HEAT PUMP UNIT SHALL BE FACTORY WIRED, CHARGED WITH R-410A, CONTAIN REFRIGERANT TO WATER HEAT EXCHANGER, AIR-VALVE, FAN MOTOR ASSEMBLY, COMPRESSOR, METERING DEVICES.
- UNIT SHALL HAVE HEAT PUMP DUTY, FULLY HERMETIC TYPE COMPRESSOR, WITH INTERNAL ISOLATION, AND EXTERNAL RUBBER-GROMMET ISOLATION. A. AIR-TO REGRIGERANT COIL SHALL BE ALUMNINUM/COPPER FINNED-TUBE CONSTRUCTION FULLY DEGREASED AT FACTORY.
- B. WATER-TO REFRIGERANT HEAT EXCHANGER SHALL BE COPPER/COPPER COAXIAL TUBE-IN-TUBE TYPE RATED FOR 450 PSIG REFRIGERANT, 300 PSIG WATER SIDE
- C. THE UNIT CONTROL SYSTEM SHALL PROVIDE CONTROL OF UNIT'S COMPRESSOR, REVERSING VALVE, FAN AND SAFETY LOCKOUT. THE 24-V CONTROLS SHALL BE CONVENIENTLY LOCATED IN A DEDICATED CONTROL BOX FOR MAXIMUM SAFETY AND EASE OF SERVICEABILITY.
- PROVIDE STANDARD 1" THICK THROWAWAY TYPE FILTERS, MOUNTED IN COMBINATION FILTER RACK/RETURN AIR DUCT COLLAR. HEAT PUMPS SHALL RUN CONTINUOUS AND BE PROVIDED WITH ELECTRONIC 7-DAY PROGRAMMABLE THERMOSTAT WITH SETBACK CAPABILITY, SIMILAR TO
- HONEYWELL, TH8321R. A PANEL SHALL BE A DECORATIVE, INDOOR, WALL-MOUNTED PANEL, PROVIDE CLEAR LOCKABLE COVER OVER ALL THERMOSTATS.

#### 4 - AIR DISTRIBUTION EQUIPMENT SPECIFICATIONS

1 PROVIDE FLEXIBLE CONNECTORS AT THE INTAKE AND DISCHARGE SIDES OF ALL AIR CONDITIONING UNITS. FLEXIBLE CONNECTORS SHALL BE MADE OF VINYL COVERED GLASS FIBER MATERIAL. CONNECTORS SHALL BE NOT LESS THAN 6" LONG NOR MORE THAN 10" LONG.

#### 5 - VOLUME CONTROL DAMPER SPECIFICATIONS

A AT EACH NEW MAIN BRANCH TAKE-OFF, PROVIDE VOLUME DAMPERS OF THE OPPOSED BLADE, MULTI LOUVERED TYPE, OPERATED BY INDICATING QUADRANTS AND SET SCREWS. VOLUME DAMPERS AND ALL MANUAL DAMPERS SHALL BE CONSTRUCTED IN ACCORDANCE WITH SMACNA AND ASHRAE STD.

B PROVIDE 45 DEG. CLINCH COLLARS AT MAIN TAKEOFFS.

#### 6 - ACCESS DOORS SPECIFICATIONS

- A PROVIDE SUITABLY SIZED ACCESS DOORS BEFORE AND AFTER IN-DUCT ELECTRIC HEATERS, FIRE DAMPERS AND MOTORIZED DAMPERS. MINIMUM SIZE OF ACCESS DOORS SHALL BE 12" X 12" OR 12" X FULL DEPTH OF DUCT IF SMALLER THAN 12".
- B ACCESS DOORS IN DUCTWORK HANDLING CONDITIONED AIR SHALL BE OF THE DOUBLE PANEL TYPE, WITH INSULATION THICKNESS SAME AS DUCT INSULATION, SET BETWEEN 18 GAGE INTERIOR CASING. SINGLE PANEL ACCESS DOORS SHALL BE FABRICATED OF 18 GAGE UP TO 12" X 12" AND 16 GAGE WHEN LARGER.
- C ACCESS DOORS SHALL BE PROVIDED WITH HEAVY ANGLE IRON FRAMES AND SHALL BE FITTED WITH A MINIMUM OF TWO (2) HINGES AND CAM FASTENERS. ACCESS DOORS ON THE BOTTOM OF DUCTS SHALL HAVE CAM FASTENERS.
  - 7 HANGERS AND SUPPORTS SPECIFICATIONS
- A WHERE HANGER STRAPS ARE USED THEY SHALL BE 1" X 18 GA. MIN., GALVANIZED STEEL. BAND IRONS ARE NOT ACCEPTABLE.
- B PROVIDE INSERTS, FISHPLATES AND OTHER METHODS RECOMMENDED BY SMACNA, AND AS APPROVED, FOR SUPPORTING HANGER STRAPS AND TRAPEZE HANGERS. C TRANSITION PIECES FROM RECTANGULAR TO ROUND AT FAN DISCHARGE SHALL BE 16 GAUGE ALL-WELDED CONSTRUCTION. PROVIDE SUITABLE ANGLE REINFORCEMENT.

#### 8- VIBRATION ISOLATOR SPEDIFICATIONS

A PROVIDE RUBBER VIBRATION ISLOATRS FOR MOUNTING OF ALL EQUIPMENT FROM

### 9 – PIPING SPECIFICATIONS

CONDENSATE PIPING SHALL BE SCHEDULE 40, PVC PIPE WITH SOLVENT-WELDED JOINTS. PROVIDE 1/2" FIBERGLASS INSULATION WITH ALL SERVICE JACKET AT ALL CONDENSATE PIPING LOCATED IN CEILING PLENUM. INSULATION SHALL HAVE A FLAME SPREAD INDEX OF NOT MORE THAN 25 AND A SMOKE-DEVELOPED INDEX OF NOT MORE THAN 50 WHEN TESTED IN ACCORDANCE WITH ASTM E 84. HEAT PUMP WATER PIPING SHALL BE TYPE L DRAWN COPPER PIPE WITH WROUGHT

A PROVIDE PIPE HANGERS TO SUPPORT THE REQUIRED LOADS. WHERE NECESSARY SUPPORTS SHALL BE DESIGNED TO PERMIT MOVEMENT DUE TO EXPANSION AND CONTRACTION. SIZE HANGERS TO FIT ON THE OUTSIDE OF INSULATION. PROVIDE INSULATION SADDLE AT HANGER. HANG PIPE FROM SUBSTANTIAL BUILDING STRUCTURE. DO NOT SUSPEND PIPE FROM ROOF DECK. PIPING SHALL NOT BE HUNG FROM OTHER PIPING. ALL RIGID HANGERS SHALL PROVIDE A MEANS OF VERTICAL ADJUSTMENT AFTER ERECTION. "C" CLAMPS SHALL NOT BE USED TO SUPPORT PIPING, UNLESS PROVIDED WITH PURPOSE MADE RESTRAINING CUPS.

### 11 - PRODUCT DATA SUBMITALS SPECIFICATIONS

- PRODUCT DATA TO BE SUBMITTED SHALL BE PUBLISHED BY THE MANUFACTURER AND SHALL CONTAIN COMPLETE AND DETAILED ENGINEERING AND DIMENSIONAL INFORMATION. THE CONTRACTOR SHALL SUBMIT PRODUCT DATA AS DESCRIBED
- 1. PRODUCT DATA SUBMITTED SHALL CONTAIN ONLY INFORMATION RELEVANT TO THE PARTICULAR EQUIPMENT OR MATERIAL TO BE FURNISHED. THE CONTRACTOR SHALL NOT SUBMIT CATALOGS WHICH DESCRIBE SEVERAL DIFFERENT ITEMS IN ADDITION TO THOSE ITEMS TO BE USED, UNLESS ALL IRRELEVANT INFORMATION IS MARKED OUT OR UNLESS RELEVANT INFORMATION IS CLEARLY MARKED. PRODUCT DATA FROM EACH MANUFACTURER SHALL BE IDENTIFIED AND SUBMITTED SEPARATELY.

### 12 - OPERATING INSTUCTIONS AND MAINTENANCE

- THE CONTRACTOR SHALL PROVIDE OPERATING INSTRUCTION AND MAINTENANCE DATA BOOKS FOR ALL NEW EQUIPMENT AND MATERIALS FURNISHED. MAINTENANCE INSTRUCTION MANUALS SHALL INCLUDE COMPLETE OILING, CLEANING AND SERVICING DATA COMPILED IN CLEAR AND EASILY UNDERSTANDABLE FORM. PROVIDE LIST OF REPLACEMENT PARTS, MOTOR RATINGS AND ACTUAL LOADS.
- INCLUDE THE FOLLOWING WHERE APPLICABLE: 1. IDENTIFYING NAME AND MARK NUMBER.
- 2. LOCATIONS (WHERE SEVERAL SIMILAR ITEMS ARE USED, PROVIDE A LIST) 3. COMPLETE NAMEPLATE DATA
- PARTS LIST PERFORMANCE CURVES AND DATA
- WIRING DIAGRAMS
- 7. LUBRICATION CHARTS 8. MANUFACTURERS RECOMMENDED OPERATING AND MAINTENANCE INSTRUCTIONS

COPPER FITTINGS.

WITH ALL NON-APPLICABLE INFORMATION DELETED.

# 13 – SHOP DRAWING SUBMITALS

- SUBMIT SHOP DRAWINGS FOR REVIEW PRIOR TO COMMENCING ANY WORK. SHOP DRAWINGS SHALL INCLUDE COMPLETE DATA AND APPLICABLE PROCEDURES FOR THE FOLLOWING EQUIPMENT AND MATERIALS (WHERE APPLICABLE):
- ALL VALVES 2. VIBRATION ISOLATORS (MOUNTING, HANGERS, AND BASES)
- 3. ALL INSULATION MATERIALS ALL PLUMBING FIXTURES AND TRIM
- 4. ALL FANS 6. PUMPS, EXPANSION TANKS, WATER HEATERS, HEAT PUMPS, GLYCOL SOLUTION, GLYCOL FEED TANK
- 7. AIR DISTRIBUTION SPECIALTIES (FILTERS, VOLUME DAMPERS, FIRE DAMPERS, GRILLES, REGISTERS, DIFFUSERS AND LOUVERS).

## 14 - BALANCING - ADJUSTING AND TESTING

- AFTER DUCT SYSTEM HAS BEEN INSTALLED, COMPLETE WITH ALL GRILLES, DAMPERS, DUCTS, AND OTHER ITEMS SPECIFIED OR SHOWN ON THE DRAWINGS, THE CONTRACTOR SHALL MAKE ADJUSTMENTS. AS REQUIRED. TO DELIVER THE VOLUME OF AIR AT EACH AIR OUTLET WITHIN 10% OF DESIGN FLOWS AS SHOWN ON THE DRAWINGS. AFTER THE FINISHED AREA IS OCCUPIED, THE AIR VOLUMES SHALL BE READJUSTED, IF REQUIRED, TO PROPERLY BALANCE THE COOLING ANDHEATING LOADS THROUGHOUT THE CONDITIONED SPACE.
- AIR OUTLETS SHALL BE BALANCED WITH AIR PATTERN AS SHOWN ON THE DRAWING. CONTRACTOR SHALL SUBMIT A CERTIFIED AIR BALANCING REPORT TO THE PROJECT ARCHITECT FOR REVIEW AND APPROVAL PRIOR TO TURNING OVER THE HVAC SYSTEM TO THE OWNER.
- BALANCING OF SYSTEMS GENERAL 1. THE CONTRACTOR SHALL PROVIDE ALL LABOR, MATERIAL AND EQUIPMENT SERVICES NECESSARY FOR TESTING AND REBALANCING THE AIR CONDITIONING SYSTEMS. HE CONTRACTOR SHALL BE A MEMBER OF EITHER ASSOCIATED AIR BALANCE COUNSEL (AABC), OR NATIONAL ENVIRONMENTAL BALANCING BUREAU (NEBB) AND PROCEDURES SHALL BE IN ACCORDANCE WITH THOSE PUBLISHED BY
- 2. SUBMIT NAME OF TEST AND BALANCE AGENCY, WITHIN 15 DAYS AFTER RECEIPT OF CONTRACT APPROVAL, FOR APPROVAL BY THE ARCHITECT. 3. BALANCING RESULT SHALL BE GUARANTEED FOR 90 DAYS. BALANCING CONTRACTOR SHALL BE SUBJECT TO RECALL TO THE SITE TO VERIFY RESULTS BFFORE APPROVAL OF BALANCING REPORT BY OWNER. CONTRACTOR SHALL SUBMIT CERTIFICATION WITH BALANCE REPORT.
- FINAL REPORT: CONTRACTOR SHALL SUBMIT FOUR COPIES OF FINAL BALANCE AND TEST REPORT. REPORT TO INCLUDE LISTING OF APPARATUS USED, CALIBRATION DATES, AND CERTIFICATION OF TEST TECHNICIAN. ALSO INCLUDED SHALL BE REPRODUCIBLE AS-BUILT DRAWINGS WHICH INDICATE THE TEST POINTS AND ASSOCIATED REFERENCE POINTS NOTED IN THE BALANCE REPORT. FINAL REPORT SHALL BE SUBMITTED TWO WEEKS AFTER COMPLETING THE BALANCING. NO FINAL PAYMENTS WILL BE MADE UP TO RECEIPT OF FINAL REPORT.

## 15 - CLEANING - DUCT AND EQUIPMENT

- A THOROUGHLY CLEAN ALL DUCTWORK OF ALL FOREIGN SUBSTANCES, INSIDE AND OUT, BEFORE BEING TESTED AND PUT INTO OPERATION. B IF PART OF A SYSTEM SHOULD BE STOPPED BY FOREIGN MATTER, AFTER BEING PLACED IN OPERATION, THAT PART SHALL BE DISCONNECTED, CLEANED, AND RECONNECTED, WHEREVER NECESSARY, TO LOCATE AND REMOVE OBSTRUCTION. ANY WORK DAMAGED
- IN THE COURSE OF REMOVING OBSTRUCTION SHALL BE REPAIRED OR REPLACED WHEN THE SYSTEM IS RECONNECTED, AT NO ADDITIONAL COST TO THE OWNER. C DURING THE COURSE OF CONSTRUCTION, ALL DUCTS, SHALL BE CAPPED IN AN APPROVED MANNER TO INSURE ADEQUATE PROTECTION AGAINST THE ENTRANCE OF
- FOREIGN MATTER. D THE SYSTEM WILL NOT BE BROUGHT INTO OPERATION FOR TESTING PURPOSES WITHOUT NEW FILTERS. PRIOR TO ACCEPTANCE OF THE SYSTEM BY THE OWNER, THE HVAC CONTRACTOR SHALL PROVIDE COMPLETE NEW SETS OF FILTERS.

#### 17 – FIRE PROTECTION

- THE EXISTING SPRINKLER SYSTEM SHALL BE MODIFIED TO SUIT THE FINISHED ROOM CONFIGURATION. THE SYSTEM SHALL BE HYDRAULICALLY DESIGNED AND MEET ALL THE REQUIREMENTS OF NFPA 13, STATE OF NEBRAKSA INSPECTION BUREAU AND THE CITY OF OMAHA FIRE INSPECTOR. SUBMIT PLANS FOR APPROVAL TO THE AUTHORITY HAVING JURISDICTION BEFORE EQUIPMENT IS INSTALLED. ROOMS WITH SUSPENDED CEILINGS SHALL HAVE CONCEALED HEADS. SPRINKLER HEADS SHALL BE ROUGH BRASS WITH FACTORY-PAINTED COVER PLATE. COVER PLATE SHALL BE PAINTED WHITE. INSTALL SPRINKLERS IN SUSPENDED CEILINGS IN CENTER OF ACOUSTICAL CEILING PANELS. ROOMS WITHOUT CEILINGS SHALL HAVE UPRIGHT HEADS. UPRIGHT SPRINKLERS SHALL BE FACTORY PAINTED BLACK IN SPACES EXPOSED TO VIEW
- THE EXISTING SPRINKLER SYSTEM SHALL BE MODIFIED TO SUIT THE FINISHED ROOM CONFIGURATION. THE SYSTEM SHALL BE HYDRAULICALLY DESIGNED AND MEET ALL THE REQUIREMENTS OF NFPA 13, STATE OF NEBRAKSA INSPECTION BUREAU AND THE CITY OF OMAHA FIRE INSPECTOR. SUBMIT PLANS FOR APPROVAL TO THE AUTHORITY HAVING JURISDICTION BEFORE EQUIPMENT IS INSTALLED. ROOMS WITH SUSPENDED CEILINGS SHALL HAVE CONCEALED HEADS. SPRINKLER HEADS SHALL BE ROUGH BRASS WITH FACTORY-PAINTED COVER PLATE. COVER PLATE SHALL BE PAINTED WHITE. INSTALL SPRINKLERS IN SUSPENDED CEILINGS IN CENTER OF ACOUSTICAL CEILING PANELS. ROOMS WITHOUT CEILINGS SHALL HAVE UPRIGHT HEADS. UPRIGHT SPRINKLERS SHALL BE FACTORY PAINTED BLACK IN SPACES EXPOSED TO VIEW.

17 – FIRE PROTECTION

### PLUMBING SPECIFICATIONS

- 1 UNDERGROUND DOMESTIC WATER SERVICE SHALL BE DUCTILE IRON WITH MECHANICAL OR PUSH-ON JOINT OR TYPE K COPPER WITH WROUGHT COPPER SOLDER JOINTS. 2 ABOVEGROUND DOMESTIC WATER PIPING SHALL BE TYPE L HARD DRAWN COPPER
- TUBING WITH WROUGHT COPPER SOLDER JOINTS. 3 UNDERGROUND SANITARY DRAINAGE PIPING SHALL BE CAST IRON SOIL PIPE OR COPPER DRAINAGE TUBE (DWV).
- 4 ABOVEGROUND SANITARY DRAINAGE AND VENT PIPING SHALL BE CAST IRON SOIL PIPE WITH CAST IRON FITTINGS. STANDARD WEIGHT GALVANIZED STEEL PIPE WITH BLACK CAST IRON DRAINAGE FITTINGS, OR COPPER DRAINAGE TUBE (DWV) WITH WROUGHT COPPER DRAINAGE FITTINGS. 5 DOMESTIC WATER PIPING SHALL BE INSULATED WITH FIBERGLASS OR TYPE 1 OR 2
- PRE-MOLDED COVER. ALL CONCEALED INSULATION SHALL HAVE TAPE AND VAPOR BARRIER OR PRE-MOLDED COVER. THICKNESS: CW 1", HW 1". ALL DOMESTIC WATER SHUTOFF VALVES SHOWN ARE BALL VALVES UNLESS NOTED OTHERWISE. BALL VALVES SHALL BE BRONZE OR BRASS BODY, FULL PORT, 2-PIECE

FLEXIBLE ELASTOMERIC PIPE INSULATION. ALL EXPOSED INSULATION SHALL HAVE

- CONSTRUCTION WITH SCREWED ENDS, DESIGNED FOR 600 PSI AT 150 DEG F CHROME PLATED OR STAINLESS STEEL BALL, STEEL HANDLE WITH VINYL GRIP AND REPLACEABLE TEFLON SEATS 7 PROVIDE PLUMBING FIXTURES AND PLUMBING SPECIALTIES AS SCHEDULED ON THE DRAWINGS. WATER CLOSETS SHALL BE PROVIDED WITH WHITE SOLID PLASTIC SEATS.
- SINKS SHALL BE PROVIDED WITH CHROME PLATED TRAPS AND TAILPIECES. INSULATE ALL EXPOSED PIPING UNDER LAVATORIES. WALL HYDRANTS AND HOSE BIBS SHALL BE PROVIDED WITH AN ACCESSIBLE BALL VALVE IN THE HEATED PORTION OF BUILDING TO ALLOW WINTER DRAINAGE OF PIPING SUBJECT

ALL FIXTURES SHALL BE PROVIDED WITH STOPS IN SUPPLY LINES. ALL LAVATORIES AND

9 PROVIDE WATER HAMMER ARRESTORS DESIGNED IN ACCORDANCE WITH P.D.I. STANDARD WH201. LOCATE ABOVE CEILING LINE FOR ACCESS. ZURN Z-1700 "SHOKTROL", WADE "SHOKSTOP" OR JOSAM "ABSORBO-TRON" 10 THE ENTIRE DOMESTIC WATER SYSTEM SHALL BE DRAINABLE THROUGH THE USE OF

TO FREEZING.

- DRAIN VALVES AND OPENING FIXTURE SUPPLY FITTINGS. PROVIDE DRAIN VALVES AS REQUIRED TO PREVENT ANY TRAPPED WATER. 11 WORK IS TO BE ACCEPTABLE UNDER OMAHA PLUMBING CODE OR ACCEPTED AS SUITABLE FOR PROPOSED USE UNDER AUTHORITY HAVING JURISDICTION. WHERE EXISTING UTILITIES ARE SHOWN TO BE ABANDONED, REMOVED, OR CONNECTED TO,
- PERFORM WORK AS REQUIRED BY LOCAL CODES AND CODE AUTHORITIES. 12 PROVIDE PIPE HANGERS TO SUPPORT THE REQUIRED LOADS. WHERE NECESSARY SUPPORTS SHALL BE DESIGNED TO PERMIT MOVEMENT DUE TO EXPANSION AND CONTRACTION. SIZE HANGERS TO FIT ON THE OUTSIDE OF INSULATION. HANG PIPE FROM SUBSTANTIAL BUILDING STRUCTURE. DO NOT SUSPEND PIPE FROM ROOF DECK. PIPING SHALL NOT BE HUNG FROM OTHER PIPING. ALL RIGID HANGERS SHALL PROVIDE A MEANS OF VERTICAL ADJUSTMENT AFTER ERECTION. "C" CLAMPS SHALL NOT BE USED TO SUPPORT PIPING. UNLESS PROVIDED WITH PURPOSE MADE RESTRAINING CUPS. WHERE NONINSULATED PIPES, IN WHICH VIBRATIONS MAY OCCUR, PASS THROUGH WALLS, FLOORS, OR PARTITIONS, ENCASE PIPE WITHIN ACOUSTICAL WALL SLEEVE.

### PROJECT CLOSE OUT

- THE HVAC CONTRACTOR SHALL PERFORM THE FOLLOWING TASKS UPON PROJECT COMPLETION. ALL REQUIRED REPORTS AND AS-BUILTS SHALL BE SUBMITTED WITHIN TWO WEEKS OF DATE OF SUBSTANTIAL COMPLETION OR TENANT
- OCCUPANCY 1. SUBMIT "AS-BUILT" RECORD DRAWINGS INDICATING ACTUAL AS-BUILT CONDITIONS TO THE ARCHITECT/ENGINEER FOR REVIEW. RECORD DRAWINGS SHALL BE STAMPED "AS BUILT" AND SHALL HAVE THE NAME, ADDRESS AND TELEPHONE NUMBER OF THE CONTRACTOR. ALL ENGINEER'S SEALS SHALL BE REMOVED FROM THE DRAWINGS. PROVIDE TWO (2) BLUE LINES AND ONE (1) PAPER SEPIA TO OWNER. 2. SUBMIT TWO COPIES OF OWNER'S MAINTENANCE MANUALS. THE MANUALS SHALL

INCLUDE RATINGS, CAPACITIES, PARTS LISTS, WIRING DIAGRAMS, SERVICE/

- MAINTENANCE RECOMMENDATIONS, AND WARRANTIES. 3. SUBMIT WRITTEN RESPONSE TO ALL FIELD REPORTS INDICATING CORRECTIVE ACTIONS TAKEN AND DATE CORRECTIVE ACTION WAS TAKEN TO THE ARCHITECT/ENGINEER FOR REVIEW.
- THE PLUMBING CONTRACTOR SHALL PERFORM THE FOLLOWING TASKS UPON PROJECT COMPLETION. ALL REQUIRED REPORTS AND "AS-BUILTS" SHALL BE SUBMITTED WITHIN TWO WEEKS OF DATE OF SUBSTANTIAL COMPLETION OR OWNER OCCUPANCY 1. SUBMIT "AS-BUILT" RECORD DRAWINGS INDICATING ACTUAL AS-BUILT CONDITIONS TO THE ARCHITECT/ENGINEER FOR REVIEW. RECORD DRAWINGS SHALL BE STAMPED "AS-BUILT" AND SHALL HAVE THE NAME, ADDRESS AND TELEPHONE NUMBER OF THE CONTRACTOR. ALL ENGINEER'S SEALS SHALL BE REMOVED FROM

THE DRAWINGS. PROVIDE TWO (2) BLUE LINES AND ONE (1) PAPER SEPIA TO OWNER.

2. SUBMIT TWO COPIES OF OWNER'S MAINTENANCE MANUALS. THE MANUALS SHALL INCLUDE RATINGS, CAPACITIES, PARTS LISTS, WIRING DIAGRAMS, SERVICE/ MAINTENANCE RECOMMENDATIONS, AND WARRANTIES. 3. SUBMIT WRITTEN RESPONSE TO ALL FIELD REPORTS INDICATING CORRECTIVE ACTIONS TAKEN AND DATE CORRECTIVE ACTION WAS TAKEN TO THE

ARCHITECT/ENGINEER FOR REVIEW.

		ME	CHANICAL SYMBOLS		
SYMBOL	DESCRIPTION	SYMBOL	DESCRIPTION	SYMBOL	DESCRIPTION
⟨ss⟨	SANITARY SEWER (BELOW FLOOR)	——————————————————————————————————————	GATE VALVE GLOBE VALVE	· Cws— ·	CHILLED WATER SUPPLY (COOLING)
	STORM DRAIN (BELOW FLOOR)  STORM DRAIN OVERFLOW (BELOW FLOOR)		CHECK VALVE		CHILLED WATER RETURN (COOLING) HOT WATER SUPPLY (HEATING)
ssp	SUBSOIL DRAIN (BELOW FLOOR)		BUTTERFLY VALVE	\$	HOT WATER RETURN (HEATING)
	SANITARY SEWER (ABOVE FLOOR)	——————————————————————————————————————	ECCENTRIC PLUG VALVE		CONDENSER WATER SUPPLY
<u></u> SD───	STORM DRAIN (ABOVE FLOOR)	————	BALL VALVE	\$CR\$	CONDENSER WATER RETURN
SDO → SD	STORM DRAIN OVERFLOW (ABOVE FLOOR)		STRAINER	<u></u>	EQUIPMENT DRAIN
SSD——	SUBSOIL DRAIN (ABOVE FLOOR) SANITARY VENT		UNION FLANGE	\LPS\	LOW PRESSURE STEAM MEDIUM PRESSURE STEAM
<b>∀AW</b>	ACID WASTE (BELOW FLOOR)	——————————————————————————————————————	CAP	\( \rightarrow \text{MPS} \rightarrow \rightarrow \text{HPS} \rightarrow \text{}	HIGH PRESSURE STEAM
	ACID WASTE (ABOVE FLOOR)		BLIND FLANGE	\$	LOW PRESSURE CONDENSATE
	ACID VENT	——————————————————————————————————————	BALANCING VALVE	\$MPC\$	MEDIUM PRESSURE CONDENSATE
<del></del>	DOMESTIC COLD WATER		GAS COCK	5 — — HPC — — - 5	HIGH PRESSURE CONDENSATE
<u> </u>	DOMESTIC HOT WATER	<del></del>	PRESSURE REGULATING VALVE	<u></u>	PUMP CONDENSATE
<u> </u>	DOMESTIC HOT WATER RECIRCULATING TERMPERED WATER	——————————————————————————————————————	SOLENOID VALVE	RS	REFRIGERANT SUCTION REFRIGERANT LIQUID
	TEMPERED WATER RECIRCULATING		CONTROL VALVE (2-WAY) CONTROL VALVE (3-WAY)	\( \square \ \ \ \ \ \ \ \ \ \ \ \ \ \ \ \ \ \ \	REFRIGERANT LIQUID REFRIGERANT HOT GAS DISCHARGE
SSO——	DRINKING WATER SUPPLY	<u> </u>	THERMOMETER		CHEMICAL FEED
	DRINKING WATER RECIRCULATING	<u> </u>	PRESSURE GAGE	→ EGS →	ETHYLENE GLYCOL SUPPLY
<b>├</b> IRM	IRRIGATION WATER MAIN	<b>\$</b>	SAFETY RELIEF VALVE	\$EGR\$	ETHYLENE GLYCOL RETURN
	NATURAL GAS		COCK (GAGE, AIRVENT, DRAIN)	├──HPWS	HEAT PUMP WATER SUPPLY
<del></del>	FIRE LINE	\$ × \$	PIPE ANCHOR	Ş — — +HPWR- — — - Ś	HEAT PUMP WATER RETURN
SM	SPRINKLER MAIN  COMPRESSED AIR	\$ — \$   \$ — \\\ \ \ \ \ \ \ \ \ \ \ \ \ \ \ \ \	PIPE GUIDE PIPE EXPANSION COMPENSATOR		HIGH TEMP WATER SUPPLY (HEATING) HIGH TEMP WATER RETURN (HEATING)
V——V——	VACUUM	\$ \\ \\ \\ \\ \\ \\ \\ \\ \\ \\ \\ \\ \\	VACUUM BREAKER	→ HCS →	HOT OR CHILLED WATER SUPPLY
<u> </u>	MEDICAL COMPRESSED AIR	, is ,	SUPERVISED O S & Y VALVE	\$HCR\$	HOT OR CHILLED WATER RETURN
	MEDICAL VACUUM	T	THERMOSTAT		
<u></u> ∽ ох —	OXYGEN	Н	HUMIDISTAT	DOUBLE LINE	
<u> </u>	NITROUS OXIDE	<u>\$</u>	TEMPERATURE SENSOR	SINGLE	DUCTWORK
N	NITROGEN	P	PRESSURE SENSOR		DOLIND FACE CLIDDLY DIFFLICED
C20————————————————————————————————————	CARBON DIOXIDE FUEL OIL SUPPLY	<b></b> FE	FLOW MEASURING ELEMENT TEST PLUG		ROUND FACE SUPPLY DIFFUSER
FOR—	FUEL OIL RETURN		SIGHT GLASS (FLOW TYPE)		SQUARE FACE SUPPLY DIFFUSER
FOV————————————————————————————————————	FUEL OIL VENT	<u> </u>	AIR ELIMINATOR		
Ş—	FUEL OIL FILL	<b>≱</b> -	TEMP. & PRESS. RELIEF VALVE	\ <del>\\\\\\\\\\\\\\\\\\\\\\\\\\\\\\\\\\\\</del>	RECTANGULAR REGISTER RETURN OR EXHAUST
⊱—FOG——	FUEL OIL GAGE	——————————————————————————————————————	STEAM TRAP		
				$\rightarrow$	RECTANGULAR REGISTER OR DIFFUSER-SUPPLY
• WC-	WATER CLOSET (WALL HUNG)	——————————————————————————————————————	PIPE ELBOW UP PIPE ELBOW DOWN	12/6 Ø	DOLIND DUCT
Wo-	WATER CLOSET (WALL HONG)		PIPE TEE UP		ROUND DUCT
wc-	WATER CLOSET (TANK TYPE)		PIPE TEE DOWN	12/6 0	FLAT OVAL DUCT - FIRST NUMBER IS SIDE SHOWN
	1771 E 1781 E	- 5 7 co	CLEANOUT		
₩C-	WATER CLOSET (FLOOR MOUNTED)	<b>∫</b> FLCO	FLOOR CLEANOUT		SUPPLY AIR DUCT
	·	<b>-</b>	GRADE CLEANOUT		
UR-	URINAL	Ş wco	WALL CLEANOUT		RETURN OR EXHAUST DUCT
		(DRAINS)	FLOOR - FD TRENCH - TD AREA - AD		OUTSIDE AIR DUCT
L-	LAVATORY (WALL HUNG)	(DRAINS)	ROOF DRAIN OR OVERFLOW ROOF DRAIN		SOTOIDE AIR DOOT
					FLEXIBLE CONNECTION
	LAVATORY (COUNTER TOP)	HB-	HOSE BIBB	VO VO	
SK-	CED/I/CE CINIV	─────────────────────────────────────	WALL HYDRANT	VD VD	VOLUME DAMPER
	SERVICE SINK	-\$	FIRE DEPARTMENT CONNECTION		MODIODIZED DAMPED OD CONTROL DAMPED, OD
° MS-	FLOOR MOP SINK	FS M	FLOW SWITCH WATER METER	₩WW	MORTORIZED DAMPER OR CONTROL DAMPER - CD FLEXIBLE DUCT
	TEOOR WITH	- M)	BACKFLOW PREVENTER		FIRE DAMPER - FD
SK-	SINK (COUNTERTOP SINGLE BOWL)	FHC	FIRE HOSE CABINET		SMOKE DAMPER - SD
	, , , , , , , , , , , , , , , , , , ,	FVC	FIRE VALVE CABINET	->	COMBINATION FIRE & SMOKE DAMPER - FD/SD
SK-	SINK (COUNTERTOP DOUBLE BOWL)				
			PLUMBING RISER NUMBER		DUCT PRESSURE CLASS DESIGNATION
BT-	BATH TUB	•	CONNECT TO EXISTING		RETURN GRILLE WITH ACOUSTIC BOOT
				<u> </u>	TRANSFER DUCT ABOVE CEILING
SH-	DRINKING FOUNTAIN				
FMC	ELECTRIC WATER COOLER				
EWC-	ELECTRIC WATER COOLER				
SH-	SHOWER HEAD				



Fusion Medical Staffing Tenant Fit-Out 11808 Grant Street Omaha, NE 68164

LEO A DALY	PLANNING ARCHITECTURE ENGINEERING INTERIORS
	EST. 1915
8600 Indian Hills Drive, Om	naha, NE 68114

REVI	SIONS	
NO.	DESCRIPTION	DATE
1	ADDENDUM NO. 1	12/18/201
FILE	LOG	1
CTIVITY	ВУ	
lanager		

CONSTRUCTION

Draw

Check


MDB

DLA

Project No. 001-10127-001 December 8, 2015

MECHANICAL SPECIFICATIONS

M-000

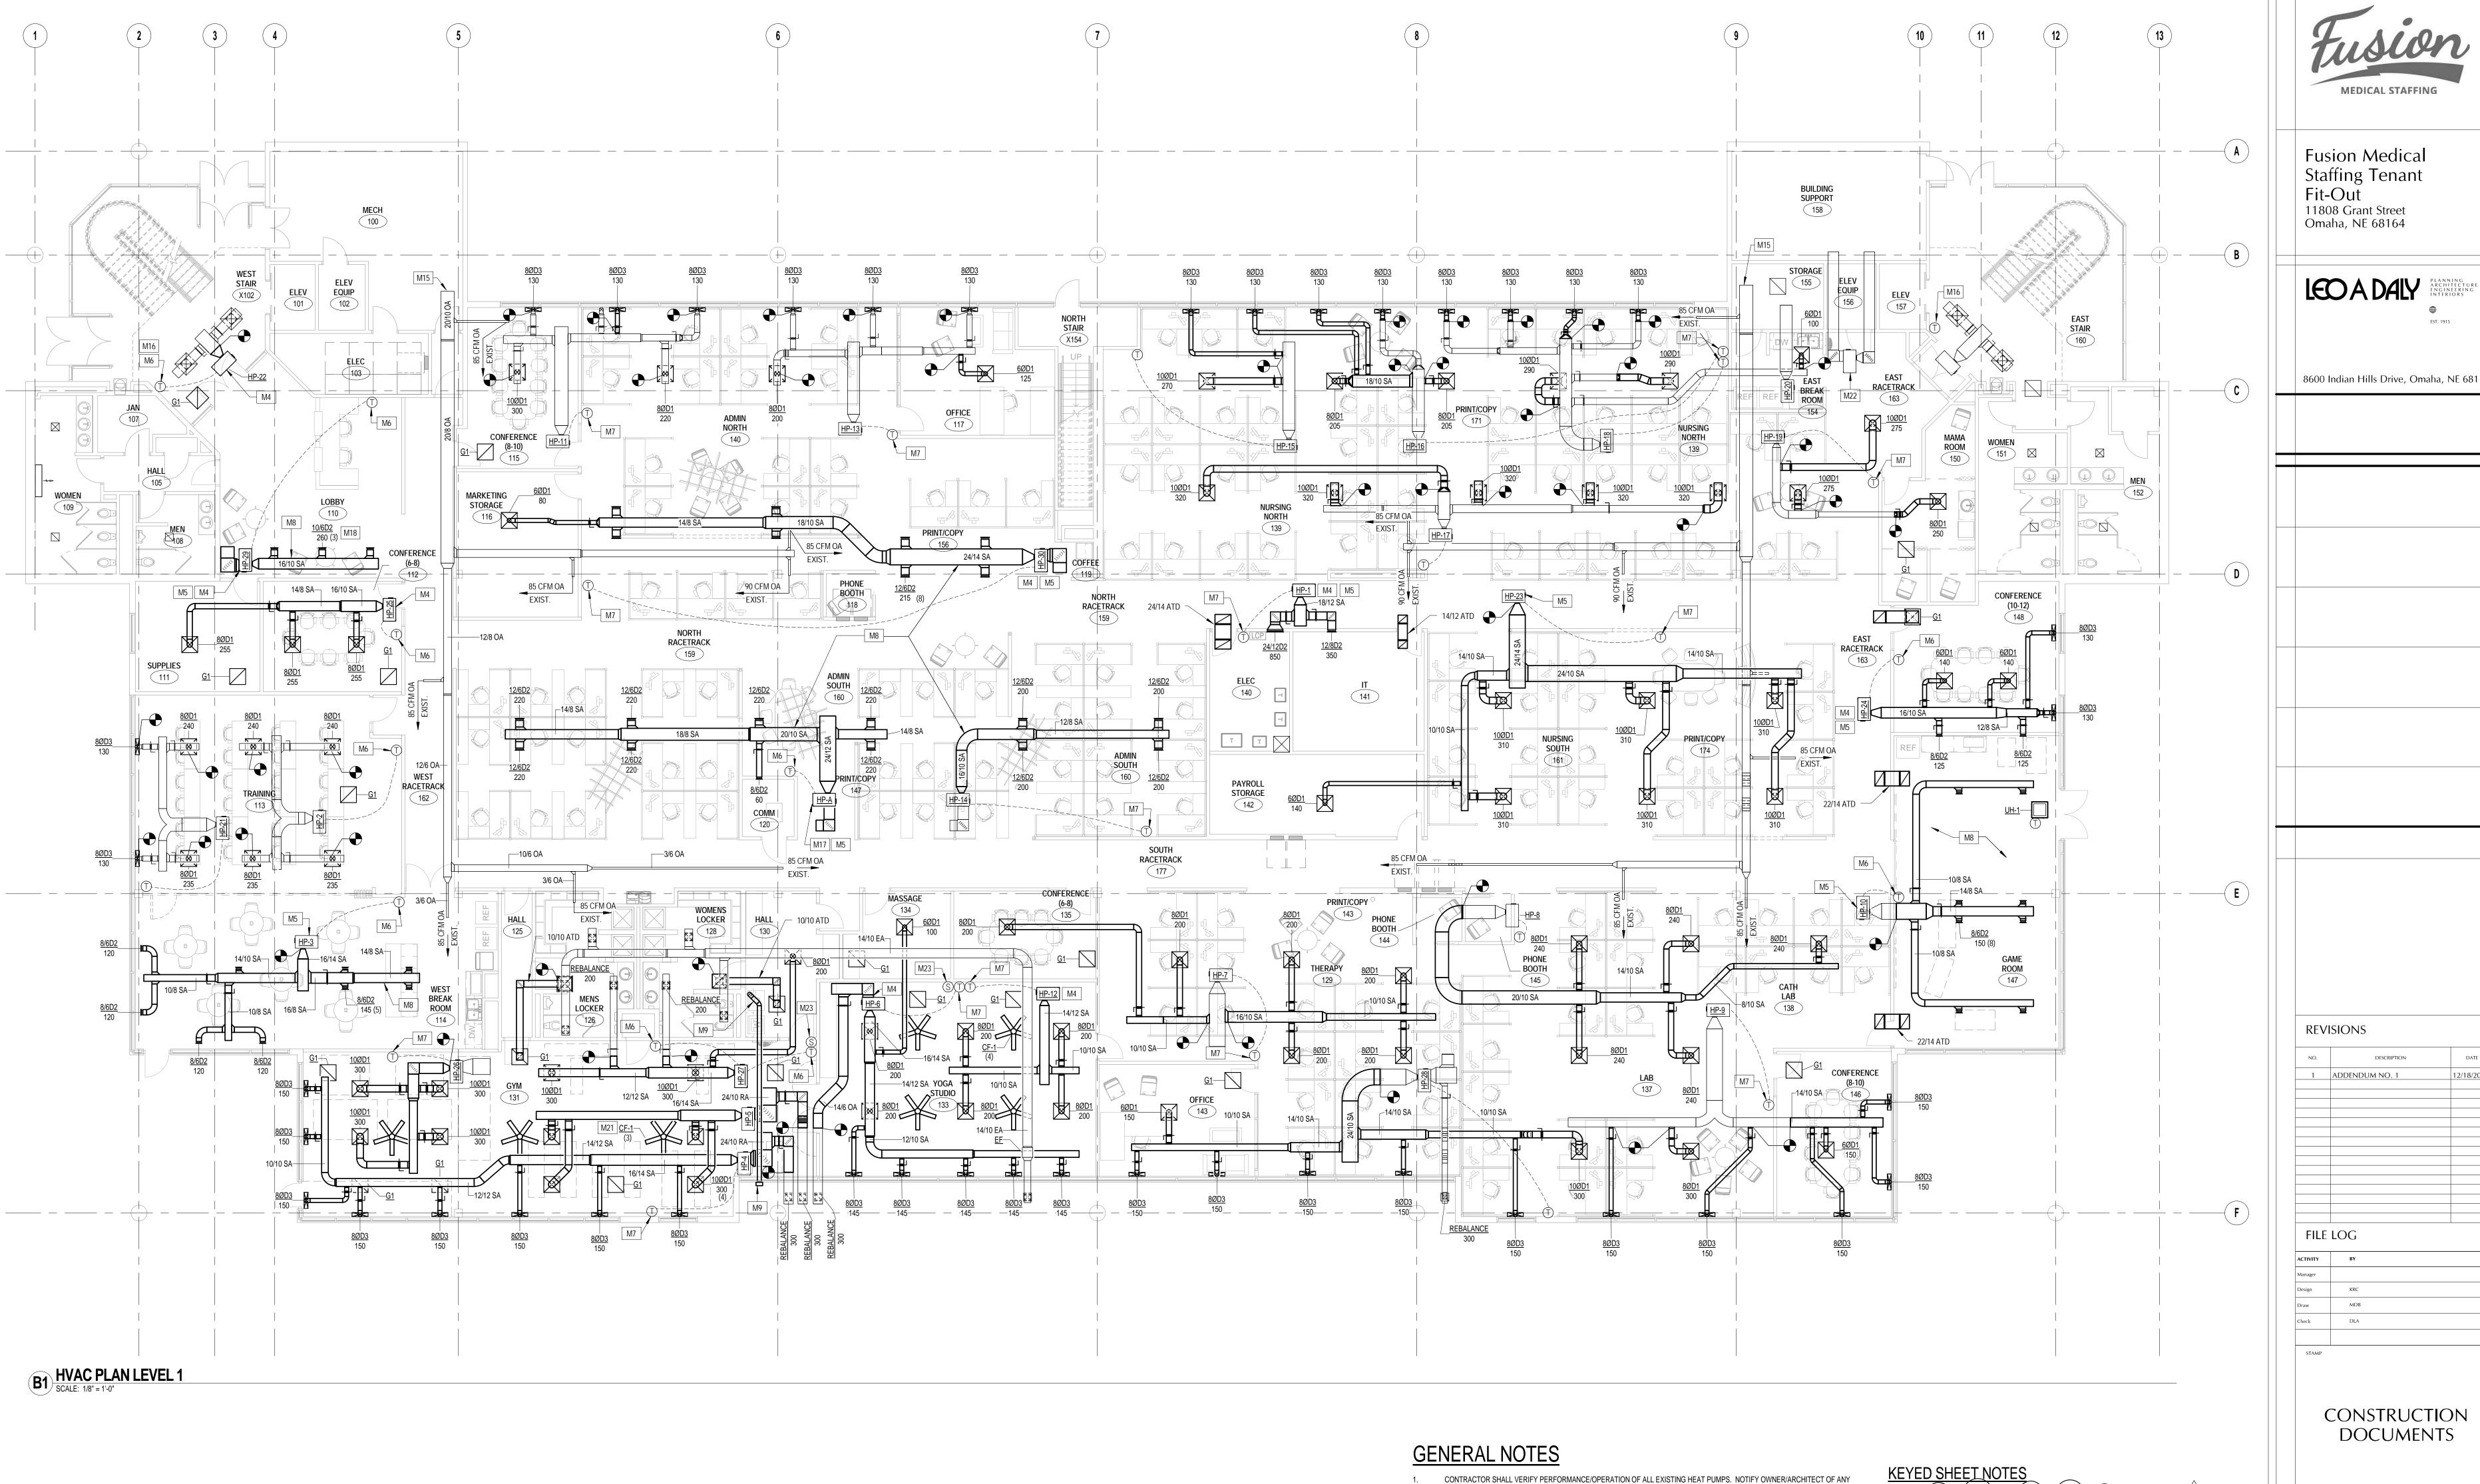

MALFUNCTIONING HEAT PUMPS.
REPLACE ALL FILTERS AT ALL HEAT PUMPS AT COMPLETION OF CONSTRUCTION.. ALL DIFFUSER DUCT BRANCH CONNECTIONS SHALL MATCH DIFFUSER NECK SIZE UNLESS OTHERWISE NOTED. 4. ALL EXPOSED DUCTWORK, PIPING, GRILLES, EQUIPMENT SHALL BE PAINTED BLACK. HEAT PUMP LABELS, ACCESS

OPENINGS, EHTERS SHALL NOT BE PAINTED:

5. ALL EXISTING SPRINKLER HEADS SHALL BE REPLACED. PIPIING SHALL BE MODIFIED AND HEADS LOCATED AS REQUIRED TO MEET THE NEW SPACE CONFIGURATION AND COMPLY WITH NFPA 13 REQUIREMENTS. ALL SPRINKLER HEADS LOCATED IN AREAS WITH REMOVED CEILINGS SHALL BE REPLACED AND RECONFIGURED TO DISCHARGE UP AND SPACED PER NFPA 13 REQUIREMENTS. ALL SPRINKLER HEADS LOCATED IN AREAS WITH NEW AND EXISTING CEILINGS SHALL BE REPLACED WITH CONCEALED TYPE HEADS. ALL SPRINKLERS LOCATED IN AREAS WITH CEILING CLOUDS OPEN TO ADJACENT NON-CEILING AREAS SHALL BE PROVIDED WITH SPRINKLER HEADS BOTH ABOVE AND BELOW LAY-IN CEILING PER NFPA 13

REQUIREMENTS. THIS PROJECT UTILIZES A PLENUM RETURN AIR CEILING DESIGN. ALL EQUIPMENT AND MATERIALS INSTALLED IN THE PLENUM RETURN CEILING MUST MEET THE FLAME SPREAD AND SMOKE DEVELOPED RATINGS OF 25/50 WHEN TESTED IN ACCORDANCE WITH ASTM E 84 AND BE APPROVED FOR USE IN PLENUM RETURN CEILING. ALL EXISTING EQUIPMENT/MATERIALS INSTALLED IN PLENUM, INCLUDING EXISTING PVC CONDENSATE PIPING, SHALL BE INSULATED AS

REQUIRED TO MEET THE FLAME/SMOKE INDEX PER IMC 2006.

PROVIDE CLEAR-PLASTIC LOCKABLE COVERS OVER ALL THERMOSTATS UNLESS OTHERWISE NOTED. ALL NON-DIGITAL, NON-PROGRAMMABLE THERMOSTATS SHALL BE REPLACED WITH NEW PROGRAMMABLE THERMOSTAT. ALL EXISTING AND NEW HEAT PUMP PVC CONDENSATE PIPING LOCATED ABOVE CEILING PLENUMS SHALL BE WRAPPED TO MEET A FLAME SPREAD INDEX OF 25 AND A SMOKE-DEVELOPED INDEX OF NOT MORE THAN 50 WHEN TESTED IN ACCORDANCE WITH ASTME E 84 PER IMC 2006 REQUIREMENTS.

RELOCATED HEAT PUMP. REUSE EXISTING HOSE KIT WHERE POSSIBLE PROVIDE COMPRESSOR SOUND SHELL AT HEAT PUMP.

EXPOSED DUCTWORK SHALL BE PROVIDED WITH INTERNAL INSULATION/LINER. DUCT DIMENSIONS SHOWN SHALL BE CLEAR INSIDE DIMENSION.

M16

M18

PROVIDE DRYER VENT DUCT TO BUILDING EXTERIOR WITH WALL CAP. SIZE PER DRYER MANUFACTURER RECOMMENDATION. EXISTING VENTILATION AIR DUCTWORK AND AIR FLOWS TO REMAIN. THERMOSTAT SHALL NOT BE PROVIDED WITH LOCKABLE COVER. M17

HEAT PUMP PROVIDED IN BASE BID ONLY. ADJUST AIR FLOW DISTRIBUTION AS REQUIRED TO PREVENT ANY SWAY OR MOTION AT SUSPENDED LIGHT FIXTURE DUE TO AIR VELOCITY. CEILING FAN LOCATION SHALL BE COORDINATED WITH FINAL GYM EQUIPMENT LAYOUT

FOR HEAD CLEARANCE COORDINATION. CONTRACTOR TO VERIFY EXISTING HEAT PUMP THERMOSTAT LOCATION. EXISTING M22 THERMOSTAT TO REMAIN. PROVIDE CEILING FAN CONTROLLER. CONTROLLER SHALL CONTROL ALL FANS LOCATED

IN ROOM AT SAME SPEED.

December 8, 2015

Project No. 001-10127-001

CONSTRUCTION DOCUMENTS

Fusion Medical

8600 Indian Hills Drive, Omaha, NE 68114


Fit-Out


HVAC PLAN LEVEL 1


MH101

	1				2		
		F	USION TENA	ANT FIT OUT VENTIL	ATION CALCULATION		
ZONE	HEAT PUMP UNIT	ROOM NUMBER	SQ.FT.	NO. OF PEOPLE	ZONE TYPE PER ASHRAE 62.1-2004	SUPPLY	ASHRAE 62.1-2004 REQUIRED OUTSIDE AIR
							·
1	HP-1						
		140	149	0	NA / IT CLOSET	850	0
		141	246	0	NA / ELECTRICAL CLOSET	350	0
2	HP-2 & HP-21						
		113	803	24	CONFERENCE/MEETING	1690	168
3	HP-3						
		114	856	24	OFFICE/BREAK ROOM	1205	171
4	UD 4 UD 5 UD 26 UD 27		030		OTTICL BILLIAN NOON	1203	1,1
4	HP-4, HP-5, HP-26, HP-27						
		131	1326	30	HEALTH CLUB	4200	680
		130	70	0	HALLWAY		4.2
		125	178	0	HALLWAY	200	7.8
5	HP-6, HP-12						
		133	841	20	HEALTH CLUB	1905	451
_		134	135	2	OFFICE/MASSAGE	100	18.1
6	HP-7, HP-8, HP-9, HP-28						
<u> </u>		420	4257	40	OFFICE	1200	474
		129	1357	18	OFFICE	1300	171
		135	195	8	CONFERENCE/MEETING	200	52
		137	1370	15	OFFICE	2010	157
		143	273	1	OFFICE	450	21
		146	297	10	CONFERENCE/MEETING	600	68
		138	486	8	OFFICE	480	69
7	HP-10, HP-24						
		147	808	20	CONFERENCE/MEETING	1450	148
		148	360	12	CONFERENCE/MEETING	540	82
•	up as	140	300	12	CONTENENCE/INICETING	340	02
8	HP-23						
		161	1328	20	OFFICE	1860	180
		142	272	0	STORAGE	140	33
9	HP-15, HP-16, HP-17, HP-18, HP-19						
		139	4583	47	OFFICE	4450	510
		154	109	2	OFFICE/BREAK ROOM	100	17
		150	229	3	OFFICE/BREAK ROOM	250	29
10	HP-A, HP-11, HP-13, HP-14, HP-30						
		140	F 47F	F0	OFFICE	F04F	C24
		140	5475	59	OFFICE	5015	624
		117	284	1	OFFICE	255	22
		115	286	10	CONFERENCE/MEETING	430	67
		116	277	0	STORAGE	80	33
11	HP-25						
		112	240	8	CONFERENCE/MEETING	510	54
		111	216	0	STORAGE	216	26
12	HP-29						
14	III ~ £ J				LODDY		
		110	705	6	LOBBY	780	72
		ZONE F	POPULATION:	348	UNCORRECTED OUT	DOOR AIR INTAKE (CFM):	3935.1
		SYSTEM I	POPULATION:	163	CORRECTED OUT	DOOR AIR INTAKE (CFM):	2048
		OCCUPAN	IT DIVERSITY:	0.47	ACTUAL SUPPLIED OU	ITSIDE AIR INTAKE (CFM):	2580

NOTE: PROVIDE BALANCE REPORT SHOWING COMPLIANCE WITH VENTILATION AIRFLOWS AT FINAL INSPECTION.

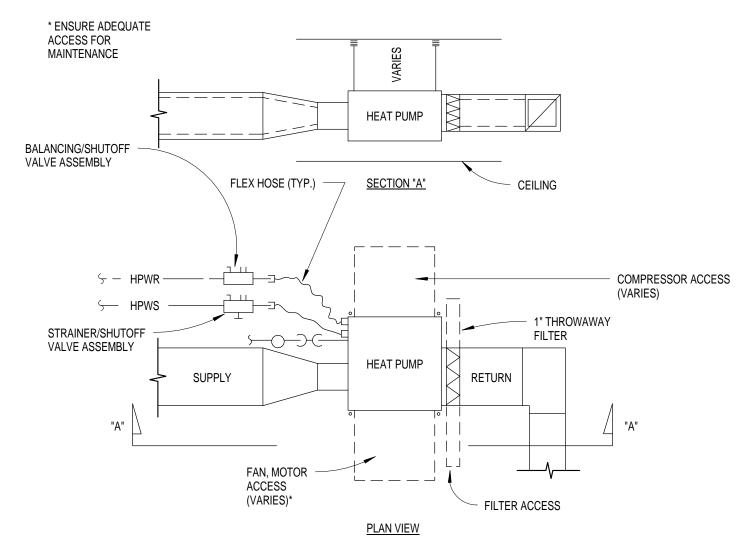


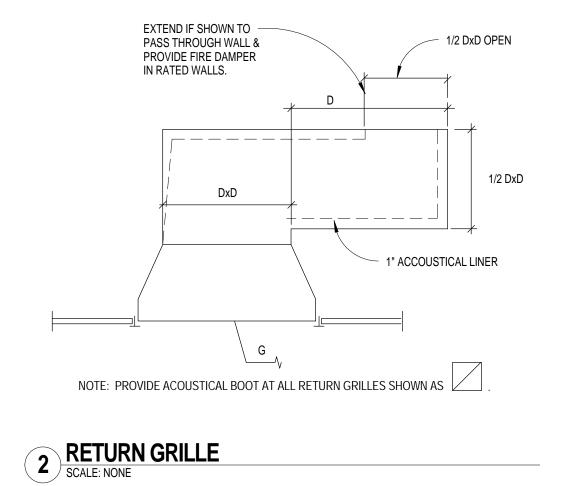

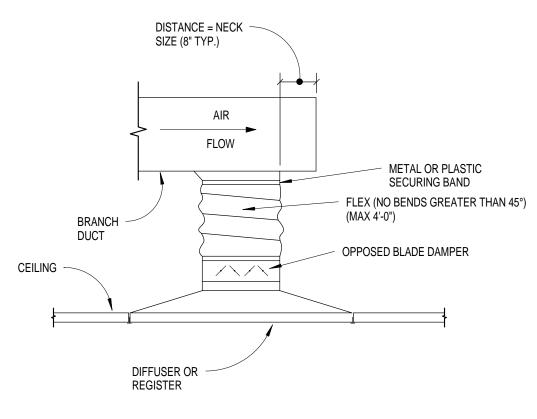

3 DIFFUSER CONNECTION
SCALE: NONE

1 HEAT PUMP SCALE: NONE

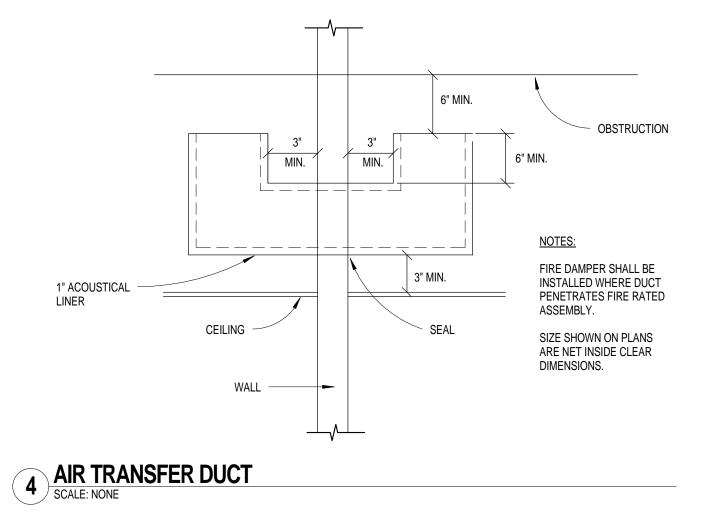

	ELECTRIC UNIT HEATER SCHEDULE									
MARK	LOCATION	TYPE	YPE MIN CAP MBH	KW	ELECT	TRICAL DATA		MANUFACTURER	MODEL	
IVIARK					VOL	PH	HZ			NOTES
UH-1	SEE PLANS	CEILING	16.3	4.8	480	3	60	QMARK	EFF48483	

PROVIDE UNIT MOUNTED THERMOSTAT.
PROVIDE WITH 277V PRIMARY TRANSFORMER / 24V SECONDARY CONTROL RELAY; CATALOG NO. EFFTR7.

DIFFUSER, REGISTER AND GRILLE SCHEDULE								
MARK	SERVES	TYPE	NECK SIZE	FINISH	MAX PD INCH WG	MANUEACTUBER AND MODEL NO.	NOTES	
D1	SUPPLY	24x24 FACE	SEE PLANS	WHITE	0.10	KRUEGER PLQ 1		
D2	SUPPLY	SUPPLY REGISTER	SEE PLANS	WHITE	0.08	KRUEGER 580	1	
D3	SUPPLY	LINEAR SLOT 1.5" SLOT WIDTH, 2-SLOT	SEE PLANS	WHITE	0.10	KRUEGER DFB	2	
G1	RETURN	RETURN GRILLE	18x18	WHITE	0.05	KRUEGER 6490	3	

PROVIDE WITH OPPOSED BLADE DAMPER AT REGISTER FOR AIRFLOW BALANCING.
 PROVIDE WITH SUPPLY AIR PLENUM BOOT.
 ALL RETURN GRILLES SHALL BE PROVIDED WITH ACOUSTICAL PLENUM BOOT PER DETAIL 2/MH501.

	CEILING FAN SCHEDULE												
						MOTO	R DATA			FAN WHEEL			
MARK	LOCATION	SERVES	TYPE	MOTOR TYPE	AMPS	RPM	VOL	PH	HZ	DIAMETER	MANUFACTURER	MODEL	NOTES
					AIVIPS	KPIVI	VOL	PH		IN			
CF-1	SEE PLANS	YOGA AND GYM	CEILING FAN WITHOUT LED	EC MOTOR WITH DIGITAL INVERTER DRIVE	0.34	179	120	1	60	52	BIG ASS FANS	HAIKU MATRIX COMPOSITE SHORT MOUNT K3127	1

1. PROVIDE SHORT MOUNT. MOUNT FAN 12" BELOW CEILING. PROVIDE WITH WALL MOUNTED CONTROL. PROVIDE STANDARD WHITE FINISH.

												HEAT PUM	SCHEDULE										
			STAT PRESS IN WG			CONDE	NSER DATA					COOLING			HEATING		Е	LECTRI	CAL DA	ATA			
MARK	TYPE	AIR FLOW CFM	TOTAL	COOL	EWT°F HTG	GPM	PD FT WG	REFRIG	DB EA	AT°F WB	TOTAL MBH	SENS MBH	EER @ DESIGN	EAT°F DB	TOTAL HEAT OUTPUT MBH	COP @ DESIGN	FLA	VOL	PH	l HZ	MANUFACTURER	MODEL	NOTES
HP-A	HEAT PUMP	1600	0.6	86	68	12	15.23	R-410A	80.6	66.2	47.5	37	12	68	59	4.65	19	208	3	60	DAIKIN	WCCH5048	1
HP-B	HEAT PUMP	310	0.5	86	68	2.1	7.69	R-410A	80.6	66.2	7.6	6.9	13	68	10	4.75	4.4	208	3	60	DAIKIN	WCCH5007	2
HP-C	HEAT PUMP	500	0.6	86	68	3.8	4.27	R-410A	80.6	66.2	15.6	12.2	14	68	18.3	4.87	6.6	208	3	60	DAIKIN	WCCH4015	2
HP-D	HEAT PUMP	330	0.2	86	68	3	10.13	R-410A	80.6	66.2	12.2	8.8	12	68	15.6	4.1	6.6	208	3	60	DAIKIN	WCCH5012	2
HP-E	HEAT PUMP	650	0.51	86	68	4.5	5.82	R-410A	80.6	66.2	20.5	16.6	12	68	24.2	4.47	8.2	208	3	60	DAIKIN	WCCH4019	2

UNIT PROVIDED IN BASE BID ONLY.
 UNIT PROVIDED AS PART OF BID ATLERNATE NO. 2.

		PLUMBING FIXTURE CONNEC	TION S	SCHE	DULE			
				PIPE SIZE	- INCHES			
MARK	FIXTURE	FITTING	WASTE	VENT	. COLD WATER	HOT WATER	MANUFACTURER AND MODEL	NOTES
		-						
SK-1	SINK, STAINLESS STEEL DROP IN, DOUBLE BOWL, EACH 13 1/2" x 16" x 7 7/8" DEEP	DECK MOUNTED 8" L TYPE SWING SPOUT, 8" FIXED CENTERS, LEVER HANDLES, 2.2 GPM AERATOR	1-1/2	1-1/2	1/2	1/2	ELKAY GOURMET SINK MODEL LR3321PD, CHICAGO FAUCET 1100369ABCP	1
SK-2	SINK, STAINLESS STEEL DROP IN, SINGLE BOWL, 16" x 11 1/2" x 7 5/8" DEEP	DECK MOUNTED 5" GOOSENECK SPOUT, 4" FIXED CENTERS, LEVER HANDLES, 1.0 GPM AERATOR	1-1/2	1-1/2	1/2	1/2	ELKAY GOURMET SINK MODEL LR1918, AMERICAN STANDARD 6500.140 CENTERSET FAUCET, V10 AERATOR	2
1	COUNTERTOP LAVATORY, VITREOUS CHINA, 15" x 12 1/8" x 5 3/4" DEEP	DECK MOUNTED 3 3/4" CONVENTIONAL SPOUT, 4" FIXED CENTERS, LEVER HANDLES, 1.0 GPM AERATOR	1-1/2	1-1/2	1/2	1/2	AMERICAN STANDARD 0419.019 AND 5502.170 CENTERSET FAUCET, V10 AERATOR	2
BF-1	BOTTLE FILLING STATION, FILTERED IN WALL RECESSED	-	1-1/2	1-1/2	1/2	-	ELKAY EZH2O LZWS(M)DK	3, 8
EWC-1	BI-LEVEL ELECTRIC WATER COOLER, FILTERED, BOTTLE FILLING STATION	-	1-1/2	1-1/2	1/2	-	ELKAY EZH2O LZSTL8WS(VR)*K	3
WB-1	RECESSED WALL DRAIN/VALVE BOX	1/2" QUARTER TURN VALVES WITH HAMMER ARRESTER	2	1-1/2	1/2	1/2	GUY GRAY WASHING MACHINE OUTLET BOX "MWB" SERIES	4, 7
WB-2	RECESSED WALL DRAIN/VALVE BOX	1/2" QUARTER TURN VALVE WITH HAMMER ARRESTER	2	1-1/2	1/2	-	GUY GRAY OUTLET BOX "MWB" SERIES	5, 7
VB-1	RECESSED WALL VALVE BOX	1/2" QUARTER TURN VALVE WITH HAMMER ARRESTER	-	-	1/2	-	GUY GRAY OUTLET BOX "MIB" SERIES	6, 7

PROVIDE WYE CONNECTION IN TAIL PIECE FOR DISHWASHER DISCHARGE CONNECTION.
LESS DRAIN AND POP-UP HOLE, ACCESSIBLE MOUNTING HEIGHT AND PROTECTION ON EXPOSED WATER SUPPLIES, "P" TRAP, AND PIPING. DRAIN, HOT AND COLD WATER VALVE BOX FOR WASHER.
DRAIN AND COLD WATER VALVE BOX FOR ICE MACHINE.
COLD WATER VALVE BOX FOR COFFEE MACHINE.
METAL WHITE POWERED COATED.
PROVIDE UNDER BID ALTERNATE NO. 2.

**MEDICAL STAFFING** 

Fusion Medical Staffing Tenant Fit-Out 11808 Grant Street Omaha, NE 68164

LEOA DALY PLANNING ARCHITECTURE ENGINEERING INTERIORS

8600 Indian Hills Drive, Omaha, NE 68114

REVISIONS

FILE LOG


12/18/2015

CONSTRUCTION DOCUMENTS

Project No.001-10127-001 December 8, 2015

MECHANICAL DETAILS AND SCHEDULES

MH501

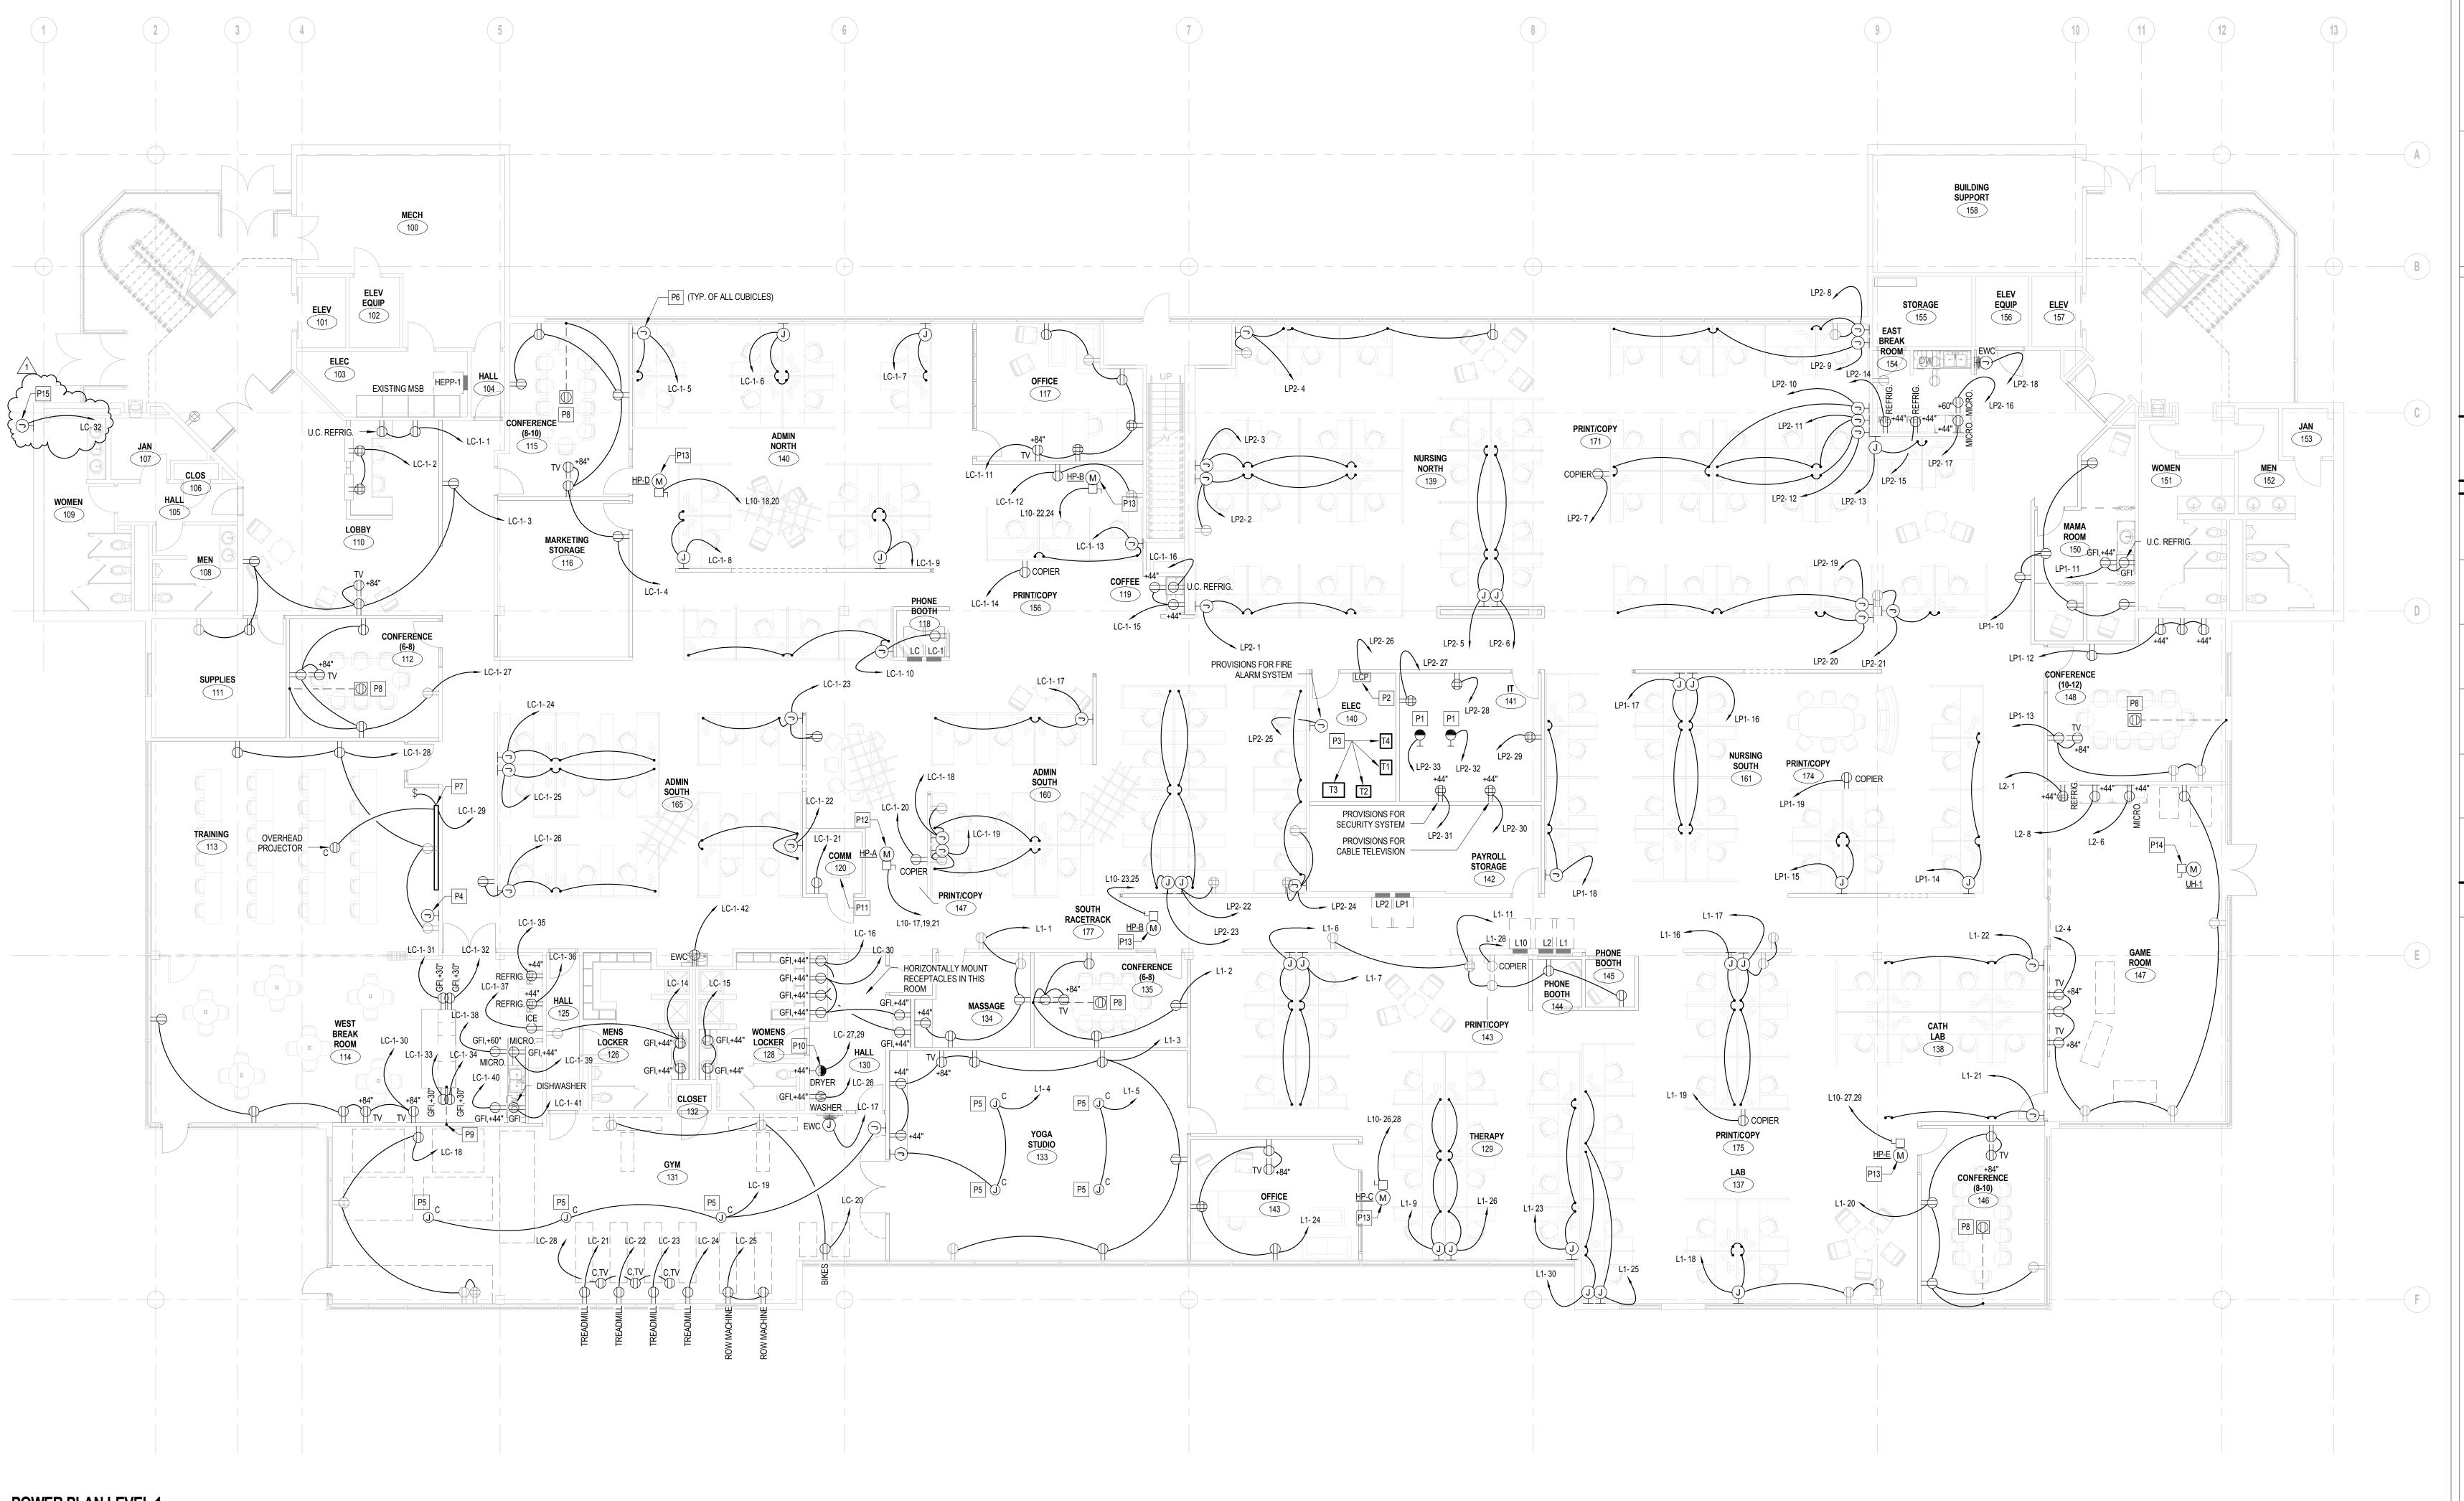

POWER PLAN LEVEL 1
SCALE: 1/8" = 1'-0"

# **GENERAL NOTES**

- 1. EXTEND EXISTING CIRCUITS FOR RELOCATED HEAT PUMPS TO NEW LOCATIONS AND RECONNECT. CONTRACTOR SHALL FIELD VERIFY EXISTING BRANCH CIRCUIT CONDUCTORS AND CONDUIT.
- 2. CONTRACTOR SHALL BE RESPONSIBLE FOR MAINTAINING CIRCUIT CONTINUITY TO ALL CIRCUITS SERVING LEVEL 2. IF AN OUTAGE NEEDS TO OCCUR, NOTIFY OCCUPANT AND CONSTRUCTION MANAGER NO FEWER THAN TWO (2) WEEKS PRIOR TO SCHEDULED OUTAGE.
- 3. PROVIDE ALL NEW TYPED PANEL DIRECTORIES IN EXISTING PANELS WITHIN ALL TELEVISIONS AND ASSOCIATED SUPPORTS, BRACKETS, AND ACCESSORIES 4 CONTRACTOR OF THE PARTY OF TH

# **KEYED SHEET NOTES**

P1 PROVIDE ONE (1) L5-30R RECEPTACLE MOUNTED TO SIDE OF CABLE TRAY FOR CONNECTION TO NEW DATA RACK POWER AND UPS (UPS FURNISHED BY OWNER).

CONNECT TO CIRCUIT AS INDICATED VIA 2#10, #10G, ÎN 1/2"C.

P5 CONNECT CEILING FAN AND CONTROLS AS REQUIRED.

- P2 PROVIDE NEW 24 RELAY LIGHTING CONTROL PANEL, WATTSTOPPER LI24 115/277 24 115, OR EQUAL. PROVIDE ALL NECESSARY CABLING, GROUP SWITCH CARDS, LOW-VOLTAGE SWITCHES, ETC. FOR COMPLETE AND FUNCTIONAL SYSTEM.
- P3 RELOCATED EXISTING TRANSFORMERS (TYP. OF 4). FLOOR-MOUNT UNITS ON NEW 4"
- AND NEW SECONDARY FEEDERS TO EXISTING PANEL LOCATIONS. CONTRACTOR TO FIELD VERIFY EXISTING CONDUIT AND CONDUCTOR SIZES.
- P4 PROVIDE ONE (1) 4-11/16" SQUARE X 4" DEEP BOX WITH 2"C WITH PULLSTRING TO PROJECTOR LOCATION IN CEILING FOR A/V CABLING.
- P6 CONNECT POWERED SYSTEMS FURNITURE AS REQUIRED. CIRCUIT INDICATED SHALL PROVIDE POWER TO QUANTITY OF CUBICLES AS SHOWN. COORDINATE EXACT
- INSTALLATION WITH FURNITURE SUPPLIER. P7 CONNECT RELOCATED MOTORIZED PROJECTOR SCREEN AND CONTROLS AS REQUIRED. P8 PROVIDE SURFACE-STYLE FLOOR BOX FOR POWER AND DATA CONNECTIONS TO TABLE. CONNECTRAC SYSTEM OR EQUAL. PROVIDE DUPLEX RECEPTACLE AS INDICATED AND

REQUIREMENTS AND LOCATION OF BOX WITH FURNITURE SUPPLIER.

SEE SHEET ET101 FOR QUANTITY OF DATA CABLES TO PROVIDE. COORDINATE EXACT

# KEYED SHEET NOTES

P9 SAW-CUT AND TRENCH CONCRETE FLOOR FOR INSTALLATION OF CONDUITS TO KITCHEN

ISLAND CIRCUITS. PATCH, REPAIR AND LEVEL FLOORING TO MATCH EXISTING

- SURROUNDING SURFACES. P10 PROVIDE NEMA 6-30R FOR CONNECTION TO ELECTRIC DRYER. CONNECT TO CIRCUIT AS INDICATED VIA 2#10, #10G, IN 1/2"C.
- P11 COORDINATE POWER REQUIREMENTS WITH COX COMMUNICATIONS AND RECONNECT EXISTING EQUIPMENT TO NEAREST PANELBOARD AS REQUIRED.
- P12 CONNECT NEW HEAT PUMP AS REQUIRED AS PART OF BASE BID ONLY. HEAT PUMP IS NOT INCLUDED IF ADD. ALTERNATE NO. 1 IS ACCEPTED. PROVIDE 208V, 30A/3P
- DISCONNECT ADJACENT TO UNIT. CONNECT TO CIRCUIT AS INDICATED VIA 3#12,#10G. IN P13 ADD. ALTERNATE NO. 1: CONNECT NEW HEAT PUMP AS REQUIRED AS PART OF ADD.
- ALTERNATE ONLY. HEAT PUMP IS NOT INCLUDED IF ADD. ALTERNATE NO. 1 IS NOT ACCEPTED. PROVIDE 208V, 30A/2P DISCONNECT ADJACENT TO UNIT. CONNECT TO CIRCUIT AS INDICATED VIA 2#12,#12G. IN 1/2°C.
- P14 CONNECT NEW ELECTRIC UNIT HEATER AS REQUIRED. PROVIDE 480V, 30A/3P DISCONNECT FUSED AT 10A ADJACENT TO UNIT. CONNECT TO NEW 15A/3P CIRCUIT BREAKER IN PANEL HEPP-1 VIA 4#12,#12G, IN 1/2"C. PROVIDE RECESSED FLUSH-MOUNT
- AND WEATHER RESISTANT J-BOX ON SECOND LEVEL OF BUILDING AND CIRCUIT TO PANEL AS INDICATED. COORDINATE EXACT LOCATION AND MOUNTING HEIGHT, CONTROL METHOD (PHOTOCELL/TIMECLOCK), AND POWER REQUIREMENTS WITH SIGNAGE PROVIDER. unimum minum

MEDICAL STAFFING

Fusion Medical Staffing Tenant Fit-Out 11808 Grant Street Omaha, NE 68164



8600 Indian Hills Drive, Omaha, NE 68114

REVISIONS

1 ADDENDUM NO. 1 FILE LOG


> CONSTRUCTION DOCUMENTS



Project No. 001-10127-001 December 8, 2015

POWER PLAN LEVEL 1

EP101

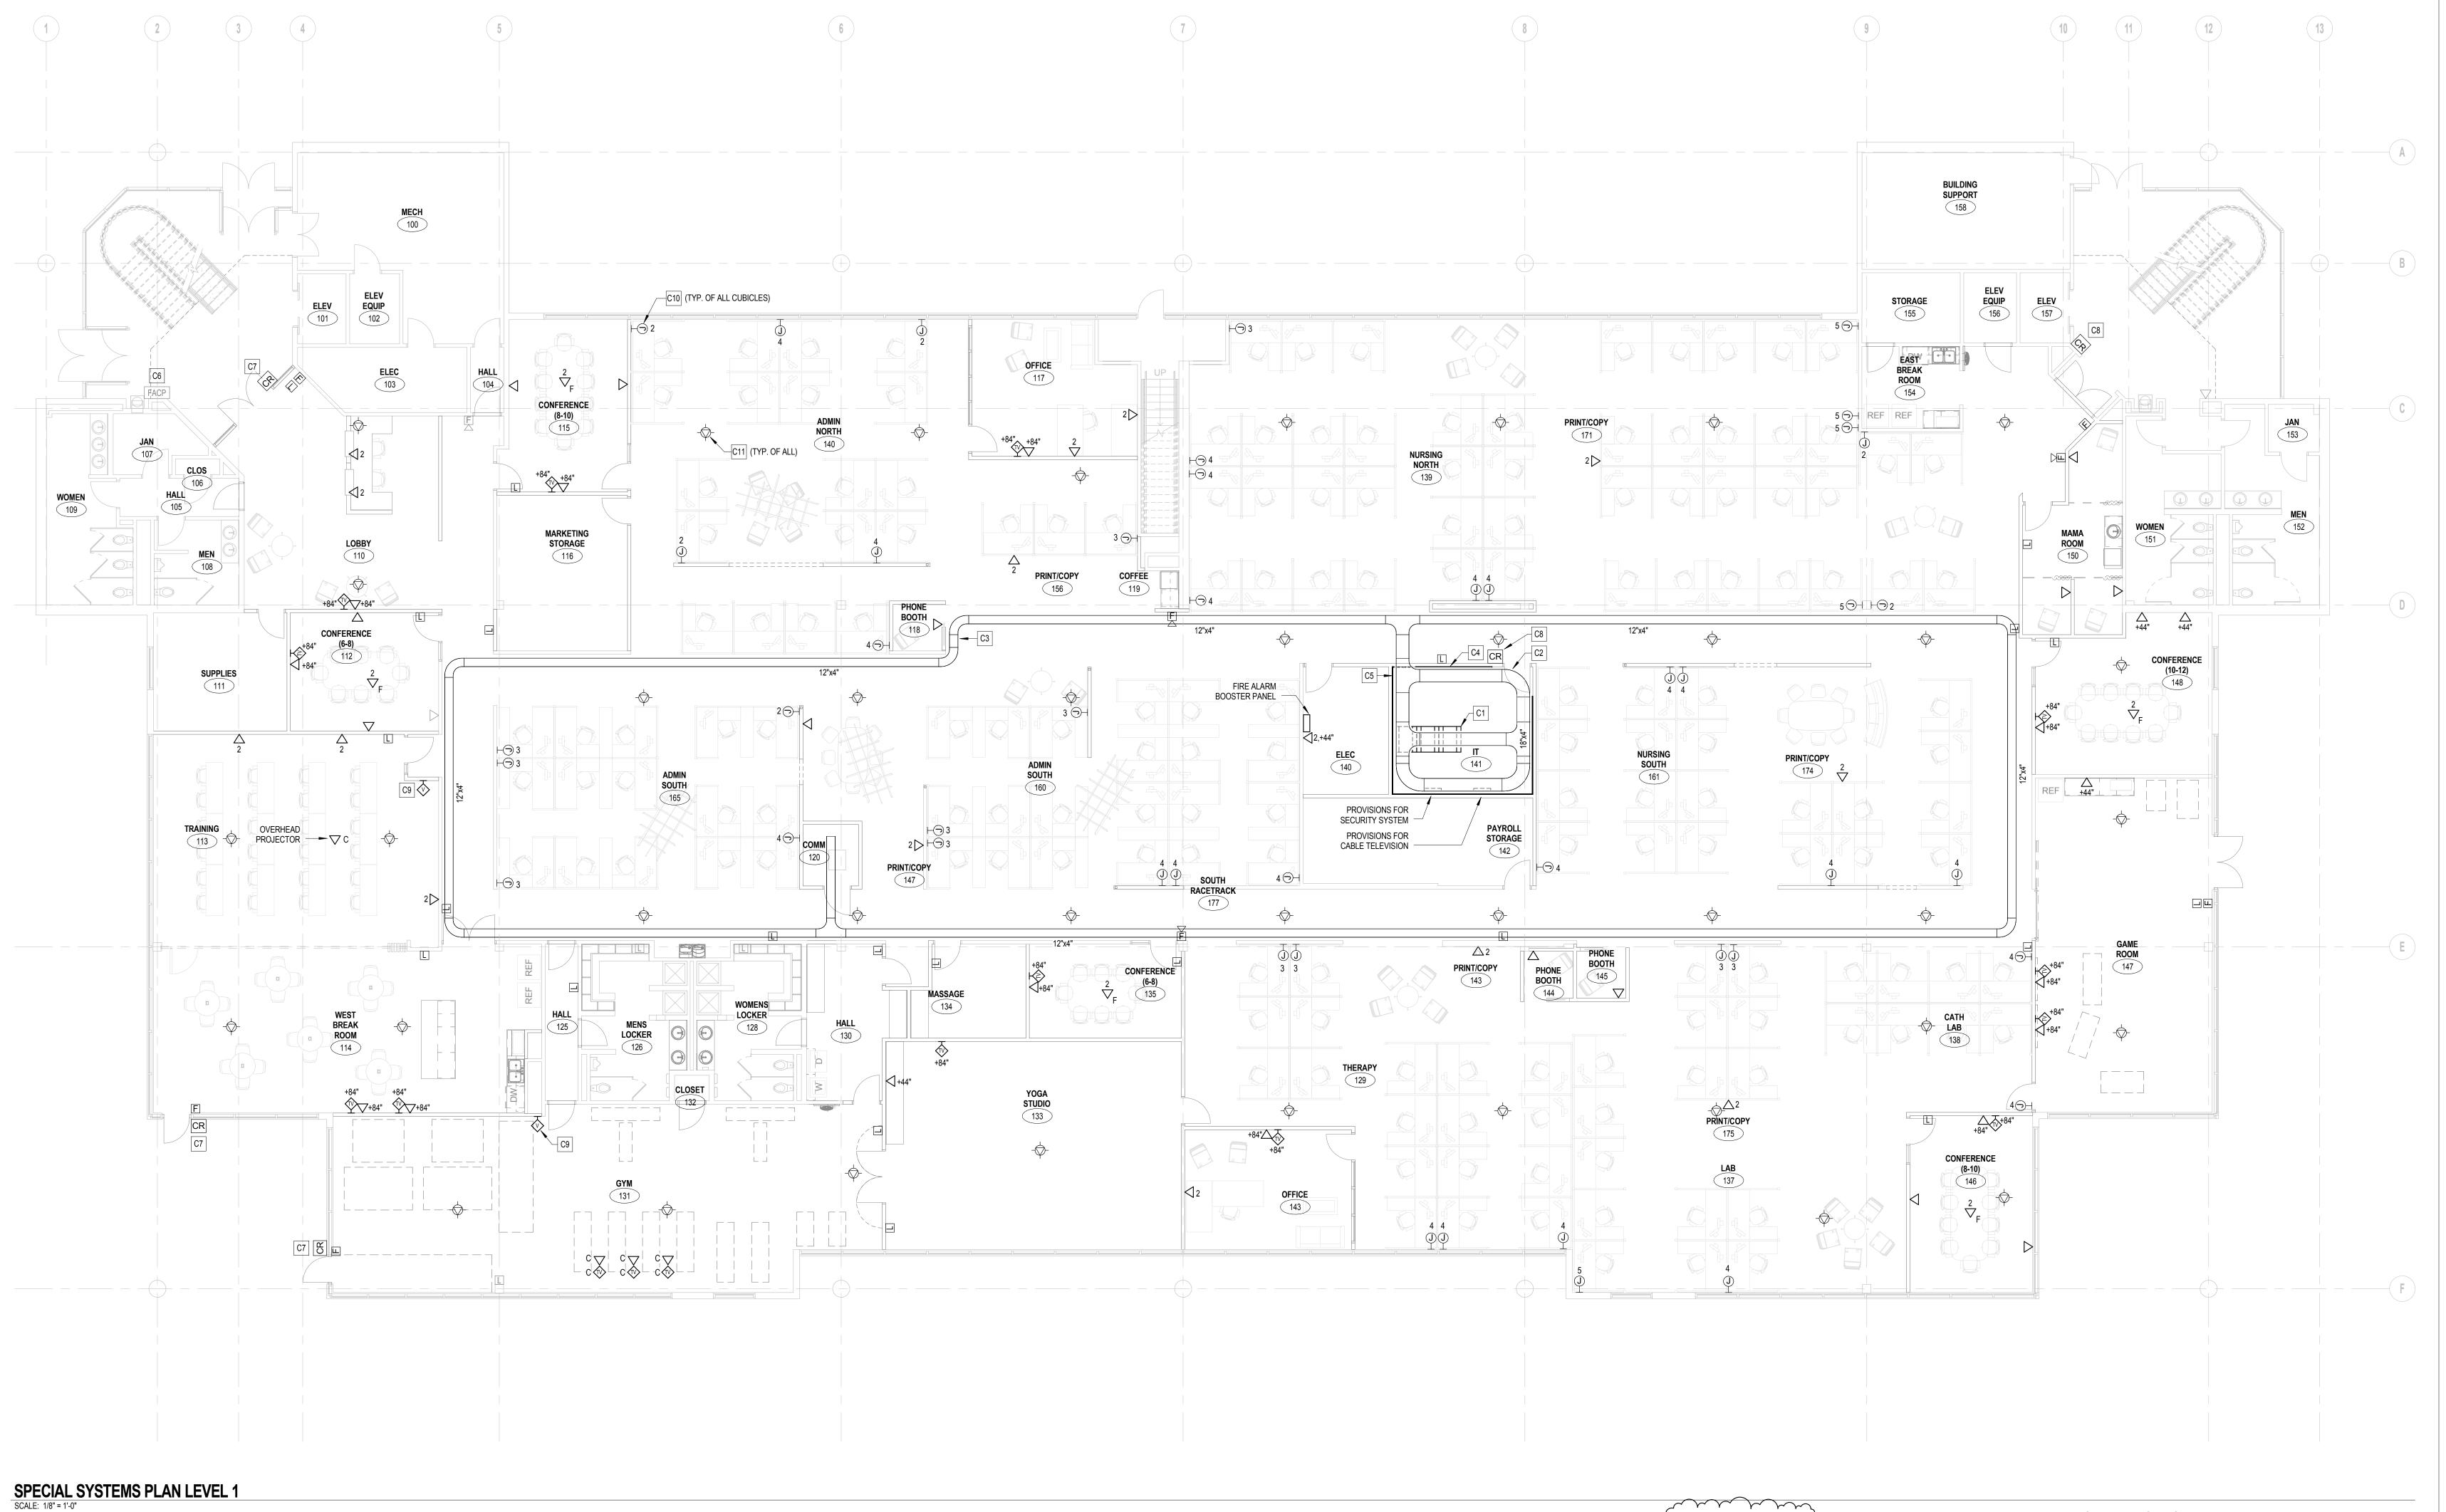

KEYED SHEET NOTES

ALL TELEVISIONS AND ASSOCIATED SUPPORTS, BRACKETS, AND ACCESSORIES SHALL BE PROVIDED BY OTHERS.

- C1 PROVIDE 84"H X 19"W X 36"D, 44U, 4-POST RACK WITH 6" VERTICAL CABLE MANAGEMENT ON BOTH SIDES (TYPICAL OF 3).
- C2 PROVIDE 18"W X 4"H LADDER-TYPE CABLE TRAY IN TELECOMMUNICATIONS ROOM ONLY. PROVIDE FIRE STOPPING AT WALL PENETRATIONS AS REQUIRED.
- C4 PROVIDE 3/4" X 8'H, AC-GRADE, VOID-FREE, FIRE-RATED PLYWOOD BACKBOARD PAINTED WITH TWO (2) COATS OF WHITE FIRE-RETARDANT PAINT (TYPICAL). DO NOT PAINT OVER THE PLYWOOD FIRE-RATED LABEL. C5 TELECOMMUNICATIONS GROUND BUS (TGB), SEE D3/EP501 FOR DETAIL. PROVIDE ONE
- (1) #3/0 COPPER GROUND CONDUCTOR TO MAIN TELECOMMUNICATIONS GROUNDING BUS (TMGB). CONTRACTOR TO VERIFY EXACT LOCATION OF TMGB. PROVIDE ONE (1) #6
- COPPER GROUND CONDUCTOR TO BUILDING STEEL. C6 EXISTING FIRE ALARM CONTROL PANEL IS EXISTING TO REMAIN. SYSTEM IS A ZONED GE FIRESHIELD PLUS. ALL NEW DEVICES SHALL MATCH AND BE FULLY COMPATIBLE WITH EXISTING SYSTEM.
- C7 PROVIDE MULLION-STYLE J-BOX FOR CARD READER. PROVIDE 1/2" FLEXIBLE CONDUIT WITH PULLSTRING TO ABOVE ACCESSIBLE CEILING J-BOX FOR CONTROL WIRING. PROVIDE RELAY TO FIRE ALARM SYSTEM AS REQUIRED AND COORDINATE EXACT REQUIREMENTS WITH SECURITY CONTRACTOR.

C8 PROVIDE J-BOX FOR CARD READER WITH 1/2" CONDUIT WITH PULLSTRING TO ABOVE

- ACCESSIBLE CEILING J-BOX FOR CONTROL WIRING. PROVIDE RELAY TO FIRE ALARM SYSTEM AS REQUIRED AND COORDINATE REQUIREMENTS WITH SECURITY CONTRACTOR. C9 PROVIDE J-BOX FOR VOLUME CONTROL OF ASSOCIATED SOUND SYSTEM WITHIN THE
- GYM. PROVIDE 1/2" CONDUIT WITH PULLSTRING TO ABOVE ACCESSIBLE CEILING J-BOX FOR CONTROL WIRING. COORDINATE REQUIREMENTS WITH A/V CONTRACTOR. C10 PROVIDE J-BOX FOR DATA CABLING TO SYSTEMS FURNITURE. TYPICAL CUBICLE REQUIRES ONE (1) CABLE. NUMBER ADJACENT TO JUNCTION BOX DENOTES QUANTITY OF CABLES REQUIRED FOR EACH CLUSTER OF CUBICLES. PROVIDE 1"C FOR EACH J-BOX
- INDICATED TO ABOVE NEAREST ACCESSIBLE CEILING. COORDINATE REQUIREMENTS WITH LOW-VOLTAGE SYSTEMS CONTRACTOR. C11 PROVIDE J-BOX FOR WIRELESS ACCESS POINT. COORDINATE FINAL LOCATION OF J-BOX WITH LOW-VOLTAGE SYSTEMS CONTRACTOR, MECHANICAL EQUIPMENT, AND LIGHTING. IN SPACES WITH ATC CEILINGS, CENTER J-BOX WITHIN 2'X2' CEILING TILE.



Fusion Medical Staffing Tenant Fit-Out 11808 Grant Street Omaha, NE 68164

LEOADALY PLANNING ARCHITECTURE ENGINEERING INTERIORS


8600 Indian Hills Drive, Omaha, NE 68114

REVISIONS

NO.	DESCRIPTION	DATI
1	ADDENDUM NO. 1	12/18/2
FILE	LOG	
ACTIVITY	ВУ	

Design DWN
Draw BSM
Check GNR

CONSTRUCTION DOCUMENTS

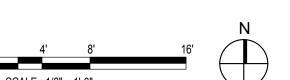

Project No. 001-10127-001 December 8, 2015

SPECIAL SYSTEMS PLAN LEVEL 1

ET101

PANEL NO. LC

**LIGHTING & APPLIANCE LOCATION:** PHONE BOOTH 118 MAIN BREAKER SIZE: 225 A PHASE BUS RATING: 225A MOUNTING: RECESSED SERVICE VOLTAGE: 120/208 Wye,3-PHASE,4-WIRE FED FROM ID: NEUTRAL BUS RATING: 225A

AIC RATING: <u>10000</u> NOTES: EXISTING PANELBOARD

ALL CIRCUIT BREAKERS ARE EXISTING UNLESS NOTED OTHERWISE. * - INDICATES TO REMOVE EXISTING CIRCUIT BREAKER AND PROVIDE NEW CIRCUIT BREAKER AS INDICATED. ** - INDICATES TO PROVIDE NEW CIRCUIT BREAKER AS INDICATED IN EXISTING SPACE.

**Total Amps:** 203.7 A 216.8 A

LOAD DESCRIPTION	BKR	Р	CKT NO.	Α(	VA)	В (	(VA)	C (	(VA)	CKT NO.	Р	BKR	LOAD DESCRIPTION
L: NORTHWEST OPEN OFFICES VIA LCP	20	1	1	1094	814					2	1	20	L: CENTER OPEN OFFICES VIA LCP
L: WEST OPEN OFFICES VIA LCP	20	1	3			560	812			4	1	20	L: NORTH & EAST RACETRACK VIA LCP
L: MAIN LOBBY	20	1	5					620	264	6	1	20	L: NORTH & EAST RACETRACK EGRESS / EXITS /
L: ADMIN CONFERENCE, STORAGE	20	1	7	504	224					8	1	20	L: NORTH OFFICE, PHONE BOOTH
L: COMMUNICATIONS ROOM	20	1	9			56	448			10	1	20	L: WEST CONFERENCE, SUPPLIES
L: TRAINING ROOM	20	1	11					476	616	12	1	20	L: BREAKROOM, MENS LOCKER, WOMENS LOCKER
L: GYM	20	1	13	560	540					14	1	20	R: MENS LOCKER ROOM
R: WOMENS LOCKER	20	1	15			360	540			16	1	20	R: WOMENS LOCKER ROOM HALL
E: GYM WATER COOLER (ADD. ALT. NO. 2)	20	1	17					100	900	18	1	20	R: GYM
E: GYM CEILING FANS	20	1	19	1500	540					20	1	20	** R: GYM
R: GYM TREADMILL	20	1	21			1500	1500			22	1	20	* R: GYM TREADMILL
R: GYM TREADMILL	20	1	23					1500	1500	24	1	20	* R: GYM TREADMILL
R: GYM ROW MACHINE	20	1	25	500	1680					26	1	20	* E: CLOTHES WASHER
* E: CLOTHES DRYER	30	2	27			6000	540			28	1	20	* R: GYM TELEVISIONS
			29	/ر	~~~	<b>✓</b>	$\sim$	V-0	540	30	1	120	K: MOMENS LOCKER ROOM HALL
* SPARE	20	1	31	1000	1920					32	1	20	* L: EXTERIOR SIGNAGE
* SPARE	20	1	33		un .	1000	~1000~		М.	34	~1	201	*SPARE-
* SPARE	20	1	35					1000	1000	36	1	20	* SPARE
EXISTING LC-1	100	3	37	12280	1000					38	1	20	* SPARE
			39			10420	1000			40	1	20	* SPARE
-			41					12790	1000	42	1	20	* SPARE
	Т	otal	Load:	24156	.00 VA	25736	6.00 VA	22306	6.00 VA				

LOAD CLASSIFICATION	CONNECTED LOAD	DEMAND FACTOR	ESTIMATED DEMAND	PANEL TOTALS	
Lighting	6512 VA	125.00%	8140 VA		
Other	1506 VA	100.00%	1506 VA	TOTAL CONN. LOAD	72.2 kVA
Power	7600 VA	100.00%	7600 VA	TOTAL CONN. CURRENT	200.4 A
Receptacles	48580 VA	60.29%	29290 VA	TOTAL EST. DEMAND LOAD	54.5 kVA
Spare	8000 VA	100.00%	8000 VA	TOTAL EST. DEMAND CURRENT	151.4 A
				FUTURE LOAD GROWTH	25%
				MIN. PANEL RATING (AMPS)	189 A

PANEL NO. LC-1

**LIGHTING & APPLIANCE** SERVICE VOLTAGE: 120/208 Wye,3-PHASE,4-WIRE PHASE BUS RATING: 225A

LOCATION:PHONE BOOTH 118MOUNTING:RECESSED **AIC RATING**: 10000 NEUTRAL BUS RATING: 225A FED FROM ID: LC

NOTES: EXISTING PANELBOARD ALL CIRCUIT BREAKERS ARE EXISTING UNLESS NOTED OTHERWISE. *** - INDICATES TO PROVIDE NEW CIRCUIT BREAKER AS INDICATED IN EXISTING SPACE.

LOAD DESCRIPTION	BKR	Р	CKT NO.	Α(	VA)	В (	VA)	C (	VA)	CKT NO.	Р	BKR	LOAD DESCRIPTION
R: MAIN LOBBY UC REFRIG.	20	1	1	540	720					2	1	20	R: MAIN LOBBY DESK
R: MAIN LOBBY, SUPPLIES, WEST CONF. RM	20	1	3			1080	1260			4	1	20	R: ADMIN CONF. RM, STORAGE
R: ADMIN NORTH CUBICLES	20	1	5					720	1440	6	1	20	R: ADMIN NORTH CUBICLES
R: ADMIN NORTH CUBICLES	20	1	7	720	720					8	1	20	R: ADMIN NORTH CUBICLES
R: ADMIN NORTH CUBICLES	20	1	9			1440	280			10	1	20	R :ADMIN NORTH CUBICLES, PHONE BOOTH
R: NORTH OFFICE	20	1	11					1440	540	12	1	20	R: ADMIN NORTH CUBICLES
R: ADMIN NORTH CUBICLES	20	1	13	1080	180					14	1	20	R: ADMIN NORTHCOPIER
R: COFFEE BAR	20	1	15			360	360			16	1	20	R: COFFEE BAR UC REFRIG
R: ADMIN SOUTH CUBICLES	20	1	17					1080	1260	18	1	20	R: ADMIN SOUTH CUBICLES
R: ADMIN SOUTH CUBICLES	20	1	19	1260	1680					20	1	20	R: ADMIN SOUTH COPIER
R: COMMUNICATIONS RM	20	1	21			180	1440			22	1	20	R: ADMIN SOUTH CUBICLES
R: ADMIN SOUTH CUBICLES	20	1	23					900	1080	24	1	20	R: ADMIN SOUTH CUBICLES
R: ADMIN SOUTH CUBICLES	20	1	25	1080	1260					26	1	20	R: ADMIN SOUTH CUBICLES
R: WEST CONFERENCE RM	20	1	27			1080	720			28	1	20	R: TRAINING ROOM
E: TRAINING ROOM PROJECTOR SCREEN	20	1	29					430	900	30	1	20	R: WEST BREAKROOM
R: WEST BREAK ROOM ISLAND	20	1	31	180	180					32	1	20	R: WEST BREAK ROOM ISLAND
R: WEST BREAK ROOM ISLAND	20	1	33			180	180			34	1	20	R: WEST BREAK ROOM ISLAND
R: WEST BREAK ROOM REFRIG.	20	1	35					1000	1000	36	1	20	R: WEST BREAK ROOM REFRIG
R: WEST BREAK ROOM ICE	20	1	37	1000	1680					38	1	20	R: WEST BREAK ROOM MICRO.
*** R: WEST BREAK ROOM MICRO.	20	1	39			1680	180			40	1	20	R: WEST BREAK ROOM COUNTER
R: WEST BREAK ROOM DISHWASHER	20	1	41					500	500	42	1	20	R: WEST WATER COOLER
Total Load:		12280.00 VA		10420	.00 VA	12790	.00 VA						
	To	tal A	mps:	104	.7 A	86.	8 A	109	.0 A				

430 VA			PANEL TOTALS	
	100.00%	430 VA		
35060 VA	64.26%	22530 VA	TOTAL CONN. LOAD	35.5 kVA
			TOTAL CONN. CURRENT	98.5 A
			TOTAL EST. DEMAND LOAD	23.0 kVA
			TOTAL EST. DEMAND CURRENT	63.7 A
			FUTURE LOAD GROWTH	25%
			MIN. PANEL RATING (AMPS)	80 A
		33000 VA 04.20 //	33000 VA	TOTAL CONN. CURRENT TOTAL EST. DEMAND LOAD TOTAL EST. DEMAND CURRENT FUTURE LOAD GROWTH

PANEL NO. LP2

MAINS TYPE: MLO
SERVICE VOLTAGE: 120/208 Wye,3-PHASE,4-WIRE **LIGHTING & APPLIANCE** LOCATION: SOUTH RACETRACK 177 MOUNTING: RECESSED PHASE BUS RATING: 225A NEUTRAL BUS RATING: 225A **AIC RATING**: <u>10000</u> FED FROM ID:

NOTES: EXISTING PANELBOARD

ALL CIRCUIT BREAKERS ARE EXISTING UNLESS NOTED OTHERWISE. * - INDICATES TO REMOVE EXISTING CIRCUIT BREAKER AND PROVIDE NEW CIRCUIT BREAKER AS INDICATED.

LOAD DESCRIPTION	BKR	Р	CKT NO.	<b>A</b> (	VA)	В (	VA)	C ('	<b>/</b> A)	CKT NO.	P	BKR	LOAD DESCRIPTION
R: NURSING NORTH CUBICLES	20	1	1	1440	1620					2	1	20	R: NURSING NORTH CUBICLES
R: NURSING NORTH CUBICLES	20	1	3			1440	1440			4	1	20	R: NURSING NORTH CUBICLES
R: NURSING NORTH CUBICLES	20	1	5					1440	1440	6	1	20	R: NURSING NORTH CUBICLES
R: NURSING NORTH COPIER	20	1	7	1680	1440					8	1	20	R: NURSING NORTH CUBICLES
R: NURSING NORTH CUBICLES	20	1	9			1440	1440			10	1	20	R: NURSING NORTH CUBICLES
R: NURSING NORTH CUBICLES	20	1	11					1080	1080	12	1	20	R: NURSING NORTH CUBICLES
R: NURSING NORTH CUBICLES	20	1	13	720	1000					14	1	20	R: EAST BREAK RM. REFRIG.
R: EAST BREAK RM REFRIG.	20	1	15			1000	1680			16	1	20	R: EAST BREAK RM. MICRO.
R: EAST BREAK RM MICRO.	20	1	17					1680	500	18	1	20	E: EAST WATER COOLER (ADD. ALT. NO. 2)
R: NURSING NORTH CUBICLES	20	1	19	1080	720					20	1	20	R: NURSING NORTH CUBICLES
R: NURSING NORTH CUBICLES	20	1	21			900	1800			22	1	20	R: ADMIN SOUTH CUBICLES
R: ADMIN SOUTH CUBICLES	20	1	23					1440	1620	24	1	20	R: ADMIN SOUTH CUBICLES
E: FIRE ALARM BOOSTER PANEL (LOCKABLE BREAKER)	20	1	25	100	0					26	1	20	E: LIGHTING CONTROL PANEL
R: IT ROOM	20	1	27			360	360			28	1	20	R: IT ROOM
R: IT ROOM	20	1	29					360	360	30	1	20	R: IT ROOM
R: IT ROOM	20	1	31	360	1500					32	1	30	* R: IT RACK
* R: IT RACK	30	1	33			1500	500			34	1	20	SPARE
SPARE	20	1	35					500	500	36	1	20	SPARE
	Т	otal I	_oad:	11660	.00 VA	13860	.00 VA	12000	.00 VA				
	To	otal A	mps:	97.	2 A	115	.9 A	100	.4 A				

LOAD CLASSIFICATION	CONNECTED LOAD	DEMAND FACTOR	ESTIMATED DEMAND	PANEL TOTALS	
Power	3600 VA	100.00%	3600 VA		
Receptacles	32420 VA	65.42%	21210 VA	TOTAL CONN. LOAD	37.5 kVA
Spare	1500 VA	100.00%	1500 VA	TOTAL CONN. CURRENT	104.1 A
				TOTAL EST. DEMAND LOAD	26.3 kVA
				TOTAL EST. DEMAND CURRENT	73.0 A
				FUTURE LOAD GROWTH	10%
				MIN. PANEL RATING (AMPS)	80 A



Fusion Medical Staffing Tenant Fit-Out 11808 Grant Street Omaha, NE 68164

LEO A DALY	PLANNING ARCHITECTURE ENGINEERING INTERIORS
	<b>(1)</b>
	EST. 1915

8600 Indian Hills Drive, Omaha, NE 68114

REVISIONS

NO.	DESCRIPTION	DATE
1	ADDENDUM NO. 1	12/18/201
FILE	LOG	·
ACTIVITY	ВУ	
Manager		
Desire	DWA	

CONSTRUCTION

DOCUMENTS

Project No. 001-10127-001 December 8, 2015

ELECTRICAL SCHEDULES

EP602