


APPLICATION FOR SUBMITTAL OF POST-APPROVAL DOCUMENT

This application is for submittal of documents, after the initial approval of the project (post-approval documents), that require Division of the State Architect (DSA) review and approval. This form shall be completed by the Design Professional in General Responsible Charge of the project, in accordance with California Code of Regulations, Title 24, Part 1, Sections 4-317, 4-323 and 4-338 and in compliance with DSA IR A-6: Construction Change Document Submittal and Approval Process.

DSA documents referenced within this form are available on the [DSA Forms](#) or [DSA Publications](#) webpages.

1. SUBMITTAL TYPE: (Is this a resubmittal? Yes <input type="checkbox"/> No <input type="checkbox"/>)			
Deferred Submittal <input type="checkbox"/>	Addendum Number:	Revision Number:	CCD Number: Category A <input type="checkbox"/> or B <input type="checkbox"/>
2. PROJECT INFORMATION:			
School District/Owner:		DSA File Number:	
Project Name/School:		DSA Application Number:	
3. APPLICANT INFORMATION:			
Date Submitted:		Attached Pages? No <input type="checkbox"/> Yes <input type="checkbox"/> Number of pages?	
Firm Name:		Contact Name:	
Work Email:		Work Phone:	
Firm Address:	City:	State:	Zip Code:
4. REASON FOR SUBMITTAL: (Check applicable boxes)			
<input type="checkbox"/> For revision or addendum prior to construction.		<input type="checkbox"/> For a project currently under construction.	
<input type="checkbox"/> For a project that has a form DSA 301-N: <i>Notification of Requirement for Certification</i> , DSA 301-P: <i>Posted Notification of Requirement for Certification</i> or a 90-Day Letter issued.			
<input type="checkbox"/> To obtain DSA approval of an existing uncertified building or buildings.			
<input type="checkbox"/> For Category B CCD this is: <input type="checkbox"/> a voluntary submittal, <input type="checkbox"/> a DSA required submittal (attach DSA notice requiring submission).			
5. DESIGN PROFESSIONAL IN GENERAL RESPONSIBLE CHARGE:			
Name of the Design Professional In General Responsible Charge:			
Professional License Number:		Discipline:	
Design Professional in General Responsible Charge Statement: The attached post-approval documents have been examined by me for design intent and appear to meet the appropriate requirements of Title 24, California Code of Regulations and the project specifications. They are acceptable for incorporation into the construction of the project.			
Signature: 			
DESIGN PROFESSIONAL IN GENERAL RESPONSIBLE CHARGE			
6. CONFIRMATION, DESCRIPTION AND LISTING OF DOCUMENTS:			
For addenda, revisions, or CCDs: CHECK THIS BOX <input type="checkbox"/> to confirm that <i>all</i> post-approval documents have been stamped and signed by the Responsible Design Professional listed on form DSA 1: <i>Application for Approval of Plans and Specifications</i> for this project. (For <i>Deferred Submittals</i> , refer to IR A-18: <i>Use of Construction Documents Prepared by Other Professionals</i> , and IR A-19: <i>Design Professional's Signature and Seal (Stamp) on Construction Documents</i> , when applicable, for signature and seal requirements.)			
Provide a brief description of construction scope for this post-approval document (attach additional sheets if needed):			
List of DSA-approved drawings affected by this post-approval document:			

DSA USE ONLY		
SSS _____ Date _____ <input type="checkbox"/> Approved <input type="checkbox"/> Disapproved <input type="checkbox"/> Not Required Comments: _____ FLS _____ Date _____ <input type="checkbox"/> Approved <input type="checkbox"/> Disapproved <input type="checkbox"/> Not Required Comments: _____ ACS _____ Date _____ <input type="checkbox"/> Approved <input type="checkbox"/> Disapproved <input type="checkbox"/> Not Required Comments: _____	Returned Date: _____ By: _____	DSA STAMP

Date: March 17, 2025

DSA Appl. No. 03-123759
DSA File No. 19-H32

ADDENDUM NO. 2

To Project Bidding Documents for:

**ARCADIA HIGH SCHOOL
LOCKER ROOM ALTERATION
ARCADIA UNIFIED SCHOOL DISTRICT**

tBP/ARCHITECTURE
4611 Teller Avenue
Newport Beach, CA 92660
949-673-0300

TO: PROSPECTIVE BIDDERS

This Addendum forms a part of the Contract Documents and modifies the original Bidding Drawings dated August 15, 2024, and Specifications dated July 2024. Acknowledge receipt of this Addendum in space provided on the Bid Form. Failure to acknowledge may subject Bidder to disqualification.

A. CHANGES TO SPECIFICATIONS

1. SECTION 00 01 10 – TABLE OF CONTENTS

Replace in its entirety specification section 00 01 10 issued with this addendum.

Changes include:

- a. Revise Section 00 01 10 – Table of Contents
- b. Revise Section 10 21 13.19 – Plastic Toilet Compartments
- c. Revise Section 10 28 00 – Toilet Accessories
- d. Remove Section 27 41 19 – Integrated Audio Video Systems

2. SECTION 10 21 13.19 – PLASTIC TOILET COMPARTMENTS

Replace in its entirety specification section 10 21 13.19 issued with this addendum.

Changes include:

- a. Part 1 General. Add shower partitions to Part 1.01.
- b. Part 1 General. Add shower curtains to Part 1.02, C.
- c. Part 2 Products. Revise Part 2.01, code compliance section.
- d. Part 2 Products. Add Part 2.03, shower partitions assembly and finish.

3. SECTION 10 28 00 – TOILET ACCESSORIES

Replace in its entirety specification section 10 21 13.19 issued with this addendum.

Changes include:

- a. Part 1 General. Add commercial shower and both accessories to Part 1.01.
- b. Part 2 Products. Add Part 2.06, commercial shower curtain, folder shower seat, and accessories.

B. CHANGES TO DRAWINGS

1. SHEET A9-1 – INTERIOR ELEVATIONS
Replace full size sheet drawing **A9-1** in its entirety, issued with this addendum.
Changes include:
 - a. Revise elevation BL-2 in accordance with floor plan update.
 - b. Revise elevation 2/BL-3 in accordance with floor plan update.
 - c. Rearrange cabinetries and revise elevation BL-3C in accordance with floor plan update.
2. SHEET A9-2 – INTERIOR ELEVATIONS
Replace full size sheet drawing **A9-2** in its entirety, issued with this addendum.
Changes include:
 - a. Extend wall length in elevation 4/BL-6 in accordance with floor plan update.
3. SHEET A9-3 – INTERIOR ELEVATIONS
Replace full size sheet drawing **A9-3** in its entirety, issued with this addendum.
Changes include:
 - a. Remove elevation BL-9.
 - b. Revise elevations BL-10, BL-11, and BL-12 in accordance with floor plan update.
4. SHEET A9-4 – INTERIOR ELEVATIONS
Replace full size sheet drawing **A9-4** in its entirety, issued with this addendum.
Changes include:
 - a. Remove elevation BL-15.
 - b. Revise elevations BL-13, BL-13A, GL-2, and GL-3 in accordance with floor plan update.
5. SHEET A9-5 – INTERIOR ELEVATIONS
Replace full size sheet drawing **A9-5** in its entirety, issued with this addendum.
Changes include:
 - a. Remove elevation GL-4.
 - b. Revise elevation GL-5 in accordance with floor plan update.
6. SHEET A9-8 – INTERIOR ELEVATIONS
Replace full size sheet drawing **A9-8** in its entirety, issued with this addendum.
Changes include:
 - a. Revise elevation 1/BL-1, 3/BL-1, and 5/BL-1 in accordance with floor plan update.
7. SHEET A9-9 – INTERIOR ELEVATIONS
Replace full size sheet drawing **A9-9** in its entirety, issued with this addendum.
Changes include:
 - a. Revise elevation 1/GL-1, 3/GL-1, and 5/GL-1 in accordance with floor plan update.
8. SHEET A10-1 – SIGNAGE PLANS
Replace full size sheet drawing **A10-1** in its entirety, issued with this addendum.
Changes include:
 - a. Relocate signages in accordance with floor plan update.

9. SHEET 8.00 – DOOR SCHEDULE
Replace full size sheet drawing **8.00** in its entirety, issued with this addendum.
Changes include:
 - a. Add Door BL02A and BL13A to door schedule.
 - b. Remove Door GL03 and GL17A from door schedule.
 - c. Widen door width for Door BL04.
 - d. Provide door louver to Door BL09.
 - e. Provide new hollow metal door and door frame to Door GL11.
 - f. Provide signages to door per schedule.
10. SHEET 8.50 – WINDOW SCHEDULE
Replace full size sheet drawing **8.50** in its entirety, issued with this addendum.
Changes include:
 - a. Revise Window Type AL01 and AL02.
 - b. Add Window Type AL03 and AL10.
 - c. Remove Window Type AL04 and AL07.
 - d. Revise window to wall attachment in Window Type AL05, AL06, and AL08.
11. SHEET 9.01 – FINISH SCHEDULE
Replace full size sheet drawing **9.01** in its entirety, issued with this addendum.
Changes include:
 - a. Provide epoxy terrazzo at shower in BL-1 and GL-1, and in All Gender Restroom in GL-9.
12. SHEET 9.02 – ENLARGED TEAM ROOM PLANS
Replace full size sheet drawing **9.02** in its entirety, issued with this addendum.
Changes include:
 - a. Provide plastic toilet compartment, PTC-2, for showers in BL-1 and GL-1..
13. SHEET E0.5 – PANEL SCHEDULES
Replace full size sheet drawing **E0.5** in its entirety, issued with this addendum.
Changes include:
 - a. Revise Panel C, E, CC, and EE to single-phase panel in lieu of three-phase panel.
14. SHEET E2.1 – BUILDING BL LIGHTING PLAN
Replace full size sheet drawing **E2.1** in its entirety, issued with this addendum.
Changes include:
 - a. Relocate light fixtures in Office BL-2 in accordance with architectural plan.
15. SHEET E3.1 – BUILDING BL POWER PLAN
Replace full size sheet drawing **E3.1** in its entirety, issued with this addendum.
Changes include:
 - a. Add electrical receptacles in pedestal on top of counter in ASB Office BL-3.
16. SHEET E4.1 – BUILDING BL SIGNAL PLAN
Replace full size sheet drawing **E4.1** in its entirety, issued with this addendum.
Changes include:
 - a. Add data receptacles in pedestal on top of counter in ASB Office BL-3.

ATTACHMENTS

The following attachments are a part of Addendum No. 2:

1. Specification Section

00 01 10	Table of Contents
10 21 13.19	Plastic Toilet Compartments
10 28 00	Toilet Accessories

2. Size 30"x42" Drawings (Total 16)

A9-1	Interior Elevations
A9-2	Interior Elevations
A9-3	Interior Elevations
A9-4	Interior Elevations
A9-5	Interior Elevations
A9-8	Interior Elevations
A9-9	Interior Elevations
A10-1	Signage Plans
8.00	Door Schedule
8.50	Window Schedule
9.01	Finish Schedule
9.02	Color Schedule
E0.5	Panel Schedule
E2.1	Building BL Lighting Plan
E3.1	Building BL Power Plan
E4.1	Building BL Signal Plan

**SECTION 00 01 10
TABLE OF CONTENTS**

PROCUREMENT AND CONTRACTING REQUIREMENTS

DIVISION 00 -- PROCUREMENT AND CONTRACTING REQUIREMENTS

- 00 01 01 - Project Title Page
- 00 01 02 - Project Information
- 00 01 07 - Seals Page
- 00 01 10 - Table of Contents
- 00 31 00 - Available Project Information
- 00 40 25 - Request for Information
- 00 43 25 - Substitution Request Form - During Procurement
- 00 63 25 - Substitution Request Form - During Construction

Addendum 2

SPECIFICATIONS

DIVISION 01 -- GENERAL REQUIREMENTS

- 01 10 00 - Summary
- 01 20 00 - Price and Payment Procedures
- 01 25 00 - Substitution Procedures
- 01 30 00 - Administrative Requirements
 - 01 30 00.01 - Request for Interpretation
- 01 31 14 - Facility Services Coordination
- 01 32 16 - Construction Progress Schedule
- 01 35 50 - Requests for Electronic Files
- 01 35 53 - Security Procedures
- 01 40 00 - Quality Requirements
- 01 41 00 - Regulatory Requirements
- 01 42 19 - Reference Standards
- 01 45 33 - Code-Required Special Inspections
- 01 50 00 - Temporary Facilities and Controls
- 01 51 00 - Temporary Utilities
- 01 52 13 - Field Offices and Sheds
- 01 55 00 - Vehicular Access and Parking
- 01 57 13 - Storm Water Pollution Prevention
- 01 57 19 - Temporary Environmental Controls

Arcadia Unified School District Locker Room Alterations tBP/Architecture Project No. 21110.00	Addendum 2	Table of Contents 00 01 10 - 1
--	-------------------	-----------------------------------

- 01 58 13 - Temporary Project Signage
- 01 60 00 - Product Requirements
- 01 61 16 - Volatile Organic Compound (VOC) Content Restrictions
 - 01 61 16.01 - Accessory Material VOC Content Certification Form
- 01 70 00 - Execution and Closeout Requirements
- 01 71 23 - Field Engineering
- 01 74 19 - Construction Waste Management and Disposal
- 01 78 00 - Closeout Submittals
 - 01 78 00.01 - Warranty Form Letter
- 01 78 39 - Project Record Documents
- 01 79 00 - Demonstration and Training

DIVISION 02 -- EXISTING CONDITIONS

- 02 41 00 - Demolition
- 02 41 13 - Site Demolition

DIVISION 03 -- CONCRETE

- 03 01 00 - Maintenance of Concrete
- 03 30 00 - Cast-in-Place Concrete
- 03 35 11 - Concrete Floor Finishes

DIVISION 04 -- MASONRY

- 04 01 00 - Maintenance of Masonry
- 04 05 11 - Masonry Mortaring and Grouting

DIVISION 05 -- METALS

- 05 50 00 - Metal Fabrications
- 05 52 13 - Pipe and Tube Railings

DIVISION 06 -- WOOD, PLASTICS, AND COMPOSITES

- 06 10 00 - Rough Carpentry
- 06 20 00 - Finish Carpentry
- 06 41 00 - Architectural Wood Casework
- 06 83 16 - Fiberglass Reinforced Paneling

DIVISION 07 -- THERMAL AND MOISTURE PROTECTION

- 07 01 50.20 - Roofing, Restoration, Patch, and Repair
- 07 21 00 - Thermal Insulation
- 07 25 00 - Weather Barriers
- 07 52 00 - Modified Bituminous Membrane Roofing

Arcadia Unified School District Locker Room Alterations tBP/Architecture Project No. 21110.00	Addendum 2	Table of Contents 00 01 10 - 2
--	-------------------	-----------------------------------

07 62 00 - Sheet Metal Flashing and Trim

07 92 00 - Joint Sealants

DIVISION 08 -- OPENINGS

08 06 71 - Door Hardware Schedule

08 11 13 - Hollow Metal Doors and Frames

08 14 16 - Flush Wood Doors

08 31 00 - Access Doors and Panels

08 43 13 - Aluminum-Framed Storefronts

08 71 00 - Door Hardware

08 80 00 - Glazing

DIVISION 09 -- FINISHES

09 05 61 - Common Work Results for Flooring Preparation

09 21 16 - Gypsum Board Assemblies

09 22 36 - Lath

09 24 00 - Cement Plastering

09 51 00 - Acoustical Ceilings

09 65 00 - Resilient Flooring

09 66 23 - Resinous Matrix Terrazzo Flooring

09 68 13 - Tile Carpeting

09 68 16 - Carpeting

09 77 33 - Terrazzo Wall Finish

09 91 13 - Exterior Painting

09 91 23 - Interior Painting

09 96 00 - High-Performance Coatings

DIVISION 10 -- SPECIALTIES

10 11 00 - Visual Display Units

10 14 23 - Panel Signage

10 21 13.19 - Plastic Toilet Compartments

10 28 00 - Toilet Accessories

10 44 00 - Fire Protection Specialties

10 51 13 - Metal Lockers

Addendum 2

Addendum 2

DIVISION 12 -- FURNISHINGS

12 24 00 - Window Shades

12 36 00 - Countertops

Arcadia Unified School District Locker Room Alterations tBP/Architecture Project No. 21110.00	Addendum 2	Table of Contents 00 01 10 - 3
--	-------------------	-----------------------------------

DIVISION 22 -- PLUMBING

- 22 05 17 - Sleeves and Sleeve Seals for Plumbing Piping
- 22 05 18 - Escutcheons for Plumbing Piping
- 22 05 23 - General-Duty Valves for Plumbing Piping
- 22 05 29 - Hangers and Supports for Plumbing Piping and Equipment
- 22 05 53 - Identification for Plumbing Piping and Equipment
- 22 07 19 - Plumbing Piping Insulation
- 22 11 16 - Domestic Water Piping
- 22 11 19 - Domestic Water Piping Specialties
- 22 11 23 - Facility Natural-Gas Piping
- 22 13 16 - Sanitary Waste and Vent Piping
- 22 13 19 - Sanitary Waste Piping Specialties
- 22 16 16 - Condensate Drain Piping
- 22 33 00 - Electric Domestic Water Heaters
- 22 42 13.13 - Commercial Water Closets
- 22 42 16.13 - Commercial Lavatories
- 22 42 16.16 - Commercial Sinks
- 22 47 13 - Drinking Fountains

DIVISION 23 -- HEATING, VENTILATING, AND AIR-CONDITIONING (HVAC)

- 23 05 29 - Hangers and Supports for HVAC Piping and Equipment
- 23 05 53 - Identification for HVAC Piping and Equipment
- 23 05 93 - Testing, Adjusting, and Balancing for HVAC
- 23 07 13 - Duct Insulation
- 23 07 19 - HVAC Piping Insulation
- 23 09 22 - Climate Management Control for HVAC
- 23 23 00 - Refrigerant Piping
- 23 31 13 - Metal Ducts
- 23 33 00 - Air Duct Accessories
- 23 34 23 - HVAC Power Ventilators
- 23 37 13 - Diffusers, Registers and Grilles
- 23 73 33 - Indoor, Indirect, Gas-Fired Heating and Ventilating Units
- 23 81 26 - Split-System Air-Conditioners

DIVISION 26 -- ELECTRICAL

- 26 05 00 - Electrical General Provisions
- 26 05 01 - Basic Electrical Materials and Methods

Arcadia Unified School District Locker Room Alterations tBP/Architecture Project No. 21110.00	Addendum 2	Table of Contents 00 01 10 - 4
--	-------------------	-----------------------------------

- 26 05 30 - Conduit and Wire
- 26 09 43 - Network Lighting Controls
- 26 24 16 - Panelboards and Terminal Cabinets
- 26 24 19 - Motor Control Equipment
- 26 50 05 - Lighting Fixtures

DIVISION 27 -- COMMUNICATIONS

- 27 41 19 - ~~Integrated Audio-Video Systems~~(Deleted)
- 27 42 00 - Electronic Network Systems Infrastructure
- 27 51 26 - Portable Assistive Listening System
- 27 53 00 - IP Based Communications System

Addendum 2

DIVISION 28 -- ELECTRONIC SAFETY AND SECURITY

- 28 31 00 - Intrusion Detection System
- 28 31 21 - Occupancy Motion Sensors
- 28 46 00 - Fire Alarm System

DIVISION 31 -- EARTHWORK

- 31 10 00 - Site Clearing
- 31 22 00 - Grading

DIVISION 32 -- EXTERIOR IMPROVEMENTS

- 32 12 16 - Asphalt Paving
- 32 12 36 - Seal Coats
- 32 13 13 - Site Concrete
- 32 14 13 - Precast Concrete Unit Paving
- 32 17 13 - Pavement Markings

DIVISION 33 -- UTILITIES

- 33 31 11 - Site Sanitary Sewer System

END OF SECTION

Arcadia Unified School District Locker Room Alterations tBP/Architecture Project No. 21110.00	Addendum 2	Table of Contents 00 01 10 - 5
--	-------------------	-----------------------------------

SECTION 10 21 13.19 PLASTIC TOILET COMPARTMENTS

PART 1 GENERAL

1.01 SECTION INCLUDES

- A. Solid plastic toilet compartments.
- B. Urinal and vestibule screens.
- C. **Shower Partitions.**

1.02 RELATED REQUIREMENTS

- A. Section 05 50 00 - Metal Fabrications: Concealed steel support members.
- B. Section 06 10 00 - Rough Carpentry: Blocking and supports.
- C. Section 10 28 00 - Toilet Accessories: **Shower curtains.**

1.03 REFERENCE STANDARDS

- A. 36 CFR 1191 - Americans with Disabilities Act (ADA) Accessibility Guidelines for Buildings and Facilities; Architectural Barriers Act (ABA) Accessibility Guidelines.
- B. ADA Standards - 2010 ADA Standards for Accessible Design.
- C. ASTM E84 - Standard Test Method for Surface Burning Characteristics of Building Materials.
- D. CBC - California Building Code.
- E. CBC Ch. 11B - California Building Code-Chapter 11B.
- F. NFPA 286 - Standard Methods of Fire Tests for Evaluating Contribution of Wall and Ceiling Interior Finish to Room Fire Growth.

1.04 ADMINISTRATIVE REQUIREMENTS

- A. Coordination: Coordinate the work with placement of support framing and anchors in walls and ceilings.

1.05 SUBMITTALS

- A. See Section 01 30 00 - Administrative Requirements, for submittal procedures.
- B. Product Data: Provide data on panel construction, hardware, and accessories.
 - 1. If other than specified manufacturer or specified product, submit catalog data.
- C. Shop Drawings: Indicate partition plan, elevation views, dimensions, details of wall supports, door swings.
 - 1. Show plan and elevation views for each room. Indicate types and thicknesses of materials and assemblies.
 - 2. Attachment details.
- D. Samples: Submit two samples of partition panels, 2 by 2 inch in size illustrating panel finish, color, and sheen.

Arcadia Unified School District Locker Room Alterations tBP/Architecture Project No. 21110.00	Addendum 2	Plastic Toilet Compartments 10 21 13.19 - 1
--	-------------------	--

- E. Manufacturer's Installation Instructions: Indicate special procedures.

1.06 WARRANTY

- A. All components shall have a 15 year limited warranty.

1.07 PACKAGING, DELIVERY, STORAGE AND HANDLING

- A. Packaging: Maintain factory packaging and protective coverings.
- B. Storage: Store panels to prevent impact and moisture damage.

1.08 PROJECT CONDITIONS

- A. Field Measurements: Verify field design and field dimensions before submitting shop drawings and before fabrication.
- B. Environmental Conditions: Maintain humidity and temperature in ranges required by manufacturer.

1.09 SEQUENCING AND SCHEDULING

- A. Complete tile and painting Work before toilet partition installations.
- B. Coordinate dimensions and locations of cut-outs and panel reinforcement with approved toilet accessories.
- C. Coordinate backing and blocking provisions in walls.

PART 2 PRODUCTS

2.01 REGULATORY REQUIREMENTS

- A. Code compliance ~~of these systems~~ with **CBC 803.9** must be verified prior to use. ~~They may be no longer available and are not yet proven to be~~ compliant with NFPA 286, ~~per CBC Sections 803.1.2, 803.11, 2604.2.4.~~
- B. Installation shall meet requirements for the physically disabled of the California Code of Regulations (CCR) Title 24 Part 2 and latest amendments to the ADA Standards and 36 CFR 1191.
- C. California Building Code (CBC) disabled accessibility regulations.
 - 1. Wheelchair accessible compartment shall comply with CBC Ch. 11B-604.8.1.
 - 2. Toe clearance for at least one side partition of a wheelchair accessible compartment shall comply with CBC Ch. 11B Figure 604.8.1.4.
 - a. It shall be 9 inches high minimum above the finish floor and 6 inches deep minimum beyond the compartment side face of the partition, exclusive of partition support members.
 - b. It shall be 12 inches high minimum above the finish floor for children's use.
 - c. Partition components at toe clearances shall be smooth without sharp edges or abrasive surfaces.
 - d. Toe clearance is not required in a compartment greater than 66 inches wide.

3. Ambulatory accessible compartments shall be provided where there are six or more toilet compartments, or where the combination of of urinals and water closets totals six or more fixtures.
 - a. Such compartment shall be provided in the same quantity as wheelchair accessible compartments per CBC Ch. 11B-213.3.1 and shall comply with CBC Ch. 11B-604.8.2.
4. Door and door hardware for accessible compartments shall be self-closing and shall comply with CBC Ch. 11B-404 except that if the approach is on the latch side of an ambulatory compartment door, clearance between the door side of the compartment and any obstruction shall be 44 inches minimum. CBC Ch. 11B Figure 604.8.2.
5. A door pull complying with CBC Ch. 11B-404.2.7 shall be placed on both sides of the accessible compartment door near the latch.
6. Ambulatory Accessible Toilet Compartment doors shall not swing into the clear floor space or clearance required for any fixture or into the minimum required compartment area. CBC Ch. 11B-604.8.2.2.

2.02 PLASTIC TOILET COMPARTMENTS

- A. Basis of Design Product: Hadrian - Standard Series - Plastic as manufactured by www.hadrian-inc.com/#sle, or approved equal.
- B. Solid Plastic Toilet Compartments: Factory fabricated doors, pilasters, and divider panels made of solid molded high density polyethylene (HDPE), tested in accordance with NFPA 286; floor-mounted headrail-braced.
 1. Color: Single color as selected, in each space.
 2. Flame Spread Rating (ASTM E84):
 - a. Class B flame spread 26-75 and smoke developed of 0-450.
 3. Doors, Panels, and Pilasters: Standard panel edge.
 4. Doors:
 - a. Thickness: 1 inch.
 - b. Width: 24 inch.
 - c. Width for Handicapped Use: 36 inch, out-swinging.
 - d. Height: 66 inch.
 5. Panels:
 - a. Thickness: 1 inch.
 - b. Height: 66 inch.
 - 1) Provide 9 inch high foot clearance at accessible toilet stalls.
 - c. Depth: As indicated on drawings.
 6. Pilasters:
 - a. Thickness: 1 inch.
 - b. Width: As required to fit space; minimum 3 inch.
 7. Screens: Without doors; to match compartments; mounted to wall with continuous panel brackets.

Arcadia Unified School District Locker Room Alterations tBP/Architecture Project No. 21110.00	Addendum 2	Plastic Toilet Compartments 10 21 13.19 - 3
--	-------------------	--

- a. Aluminum heat sink fastened to bottom edges
- b. Urinal Screens: 24 inches wide by 42 inches high.
 - 1) Mount 14 inches above floor.

2.03 SHOWER PARTITIONS

- A. **Construction:** Doors, panels and pilasters shall be certified CLASS B polyethylene solid plastic. The material shall contain no foaming agents, which can cause the formation of air pockets. The self-lubricating surface is resistant to marking and can be maintained effectively with ordinary household cleaners.
- B. **Panels:** 1" (25mm) thick by 55" (1397mm) high straight cut with fine radius edges.
- C. **Pilasters:** 1" (25mm) thick by 82" (2083mm) high straight cut with fine radius edges.
- D. **Headrail:** 1.25" (32mm) by 1.75" (44mm) extruded anodized aluminum with anti-grip design. Wall thickness to be 0.060" (1.5mm) and securely attach to wall and pilasters with manufacturer's fittings in such a way as to make a rigid installation. Connect all joints in headrails at a pilaster.
- E. **Finish:**
 - 1. **Doors, panels, and pilasters:** Certified CLASS B polyethylene solid plastic with uniform color throughout. Color to be as selected from Hadrian's color card.

~~2.03~~2.04 ACCESSORIES

- A. **Pilaster Shoes:** Stainless steel, satin finish, 3 inches high; concealing floor fastenings.
 - 1. Provide adjustment for floor variations with screw jack through steel saddles integral with pilaster.
 - 2. Provide ceiling attachment using two adjustable hanging studs, attached to above-ceiling framing.
- B. **Head Rails:** Extruded aluminum, anti-grip profile.
 - 1. Size: Manufacturer's standard size.
- C. **Wall and Pilaster Brackets:** Stainless steel; continuous type.
- D. **Attachments, Screws, and Bolts:** Stainless steel, tamper proof type.
 - 1. For attaching panels and pilasters to brackets: Through-bolts and nuts; tamper proof.
 - 2. Secure to pilasters with a stainless steel tamper resistant Torx head sex bolt.
- E. **Hinges:** Stainless steel, manufacturer's standard finish.
 - 1. Continuous-type hinge, self closing.
- F. **Door Hardware:** Anodized aluminum, manufacturer's standard finish.
 - 1. **Door Latch:** Slide type with exterior emergency access feature.
 - a. **Latch Mechanism:** Stainless Steel Slide Bolt Latch and Housing: Heavy-duty stainless steel type 304. The latch and housing to have a bright finish. The slide bolt and button to have a black anodized finish.
 - b. **Latch Mechanism:** Occupancy Indicator Latch and Housing:
 - 1) Material: Satin stainless steel.

- 2) Occupancy indicators: Green for occupied and red not occupied.
- 3) Slide bolt and button.
- 2. Door Strike and Keeper with Rubber Bumper: Mount on pilaster in alignment with door latch.
 - a. Heavy-duty extruded aluminum 6436-T5 alloy with a bright dip anodized finish. Secure to pilasters with stainless steel tamper resistant Torx head sex bolts. Bumper made of extruded black vinyl.
 - b. Style: 6 inches aluminum.
- 3. Provide second CBC Ch. 11B and ADA Standards door pull for outswinging doors at accessible doors.
 - a. Surface mounted U-shaped or wire pulls on both sides of accessible compartment doors.
 - b. Chrome Plated Double Door Pull 5-1/2", for 1 inch thick doors.
 - c. Overall width is 6-3/4 inches with 5-7/8 inch hole spacing.
- G. Coat Hook: One per compartment, mounted on door.
 - 1. Mount such that no portion is over 40 inches above finish floor , at accessible stall, and 48 inches above finish floor at non-accessible stall.
- H. Toilet Partition Suspension Members: As specified in Section 05 50 00.

PART 3 EXECUTION

3.01 EXAMINATION

- A. Verify that field measurements are as indicated.
- B. Verify correct spacing of and between plumbing fixtures.
- C. Verify correct location of built-in framing, anchorage, and bracing.

3.02 INSTALLATION

- A. Install partitions secure, rigid, plumb, and level in accordance with manufacturer's instructions.
- B. Maintain 3/8 inch to 1/2 inch space between wall and panels and between wall and end pilasters.
- C. Attach panel brackets securely to walls using anchor devices.
- D. Attach panels and pilasters to brackets. Locate head rail joints at pilaster center lines.
- E. Field touch-up of scratches or damaged finish will not be permitted. Replace damaged or scratched materials with new materials.

3.03 TOLERANCES

- A. Alignment Tolerance: Plus or minus 1/16 inch, in any direction.
- B. Maximum Variation From True Position: 1/4 inch.
- C. Maximum Variation From Plumb: 1/8 inch.

Arcadia Unified School District Locker Room Alterations tBP/Architecture Project No. 21110.00	Addendum 2	Plastic Toilet Compartments 10 21 13.19 - 5
--	-------------------	--

3.04 ADJUSTING

- A. Operation: Doors shall operate smoothly and evenly.
- B. Adjust and align hardware to uniform clearance at vertical edge of doors, not exceeding 3/16 inch.
 - 1. Hang doors and adjust so that tops of doors are parallel with overhead brace when doors are in closed position.
- C. Adjust hinges to position doors in partial opening position when unlatched. Return out-swinging doors to closed position.
 - 1. Adjust doors to remain open at approximately 30 degrees.
- D. Adjust adjacent components for consistency of line or plane.
- E. Field Operation and Alignment Check: Demonstrate compliance with specified tolerance and operation requirements.
 - 1. Should check reveal misalignment, improper operation or inadequate anchorage, realign, adjust and re-anchor the entire installation to Architect's satisfaction.
 - 2. Replace deformed, marred, damaged or dented parts at no change in Contract Time or Sum.

3.05 CLEANING

- A. Cleaning After Installation: Clean exposed surfaces of panel systems using materials and methods recommended by manufacturer.
- B. Protection: Provide protection as necessary to prevent damage during remainder of construction period.
- C. Final Cleaning: Clean partitions to dust-free condition prior to Final Acceptance.

END OF SECTION

Arcadia Unified School District Locker Room Alterations tBP/Architecture Project No. 21110.00	Addendum 2	Plastic Toilet Compartments 10 21 13.19 - 6
--	-------------------	--

SECTION 10 28 00 TOILET ACCESSORIES

PART 1 GENERAL

1.01 SECTION INCLUDES

- A. Commercial toilet accessories.
- B. Commercial shower and bath accessories.**
- ~~B.C.~~ Under-lavatory pipe supply covers.
- ~~C.D.~~ Utility room accessories.

1.02 RELATED REQUIREMENTS

- A. Section 06 10 00 - Rough Carpentry: Concealed supports for accessories, including in wall framing and plates.
- B. Section 10 21 13.19 - Plastic Toilet Compartments.

1.03 REFERENCE STANDARDS

- A. ADA Standards - 2010 ADA Standards for Accessible Design.
- B. ASME A112.18.9 - Protectors/Insulators for Exposed Waste and Supplies on Accessible Fixtures.
- C. ASTM A269/A269M - Standard Specification for Seamless and Welded Austenitic Stainless Steel Tubing for General Service.
- D. ASTM A666 - Standard Specification for Annealed or Cold-Worked Austenitic Stainless Steel Sheet, Strip, Plate, and Flat Bar.
- E. ASTM B456 - Standard Specification for Electrodeposited Coatings of Copper Plus Nickel Plus Chromium and Nickel Plus Chromium.
- F. ASTM C1036 - Standard Specification for Flat Glass.
- G. ASTM C1048 - Standard Specification for Heat-Strengthened and Fully Tempered Flat Glass.
- H. ASTM C1503 - Standard Specification for Silvered Flat Glass Mirror.
- I. ASTM C1822 - Standard Specification for Insulating Covers on Accessible Lavatory Piping.
- J. ASTM E84 - Standard Test Method for Surface Burning Characteristics of Building Materials.
- K. ASTM G21 - Standard Practice for Determining Resistance of Synthetic Polymeric Materials to Fungi.
- L. CBC Ch. 11B - California Building Code-Chapter 11B.
- M. ICC A117.1 - Accessible and Usable Buildings and Facilities.

1.04 ADMINISTRATIVE REQUIREMENTS

- A. Coordinate the work with the placement of internal wall reinforcement, concealed ceiling supports, and reinforcement of toilet partitions to receive anchor attachments.

Arcadia Unified School District Locker Room Alterations tBP/Architecture Project No. 21110.00	Addendum 2	Toilet Accessories 10 28 00 - 1
--	-------------------	------------------------------------

1.05 SUBMITTALS

- A. See Section 01 30 00 - Administrative Requirements, for submittal procedures.
- B. Product Data: Submit data on accessories describing size, finish, details of function, and attachment methods.
- C. Manufacturer's Installation Instructions: Indicate special procedures and conditions requiring special attention.
- D. Maintenance Materials: Furnish the following for District's use in maintenance of project:
 - 1. See Section 01 60 00 - Product Requirements, for additional provisions.
 - 2. Tools: One each of every special tool required for maintenance of fasteners and operable parts.

PART 2 PRODUCTS

2.01 REGULATORY REQUIREMENTS

- A. Provide toilet accessories meeting the requirements for the physically disabled of the California Building Code (CBC), Title 24 Part 2, CBC Ch. 11B, and 2010 ADA Standards, as amended.
- B. Accessible requirements:
 - 1. Elements of sanitary facilities shall be mounted at locations in compliance with CBC Ch. 11B-602 through 11B-612.
 - 2. Grab bars in toilet facilities and bathing facilities shall comply with CBC Ch. 11B-609.
 - a. Grab bars and any wall or other surfaces adjacent to grab bars shall be free of sharp or abrasive elements and shall have rounded edges.
 - b. The space around the grab bars shall be as follows:
 - 1) 1-1/2 inches between the grab bar and the wall. CBC Ch. 11B-609.3.
 - 2) 1-1/2 inches minimum between the grab bar and projecting objects below and at the ends.
 - 3) 12 inches minimum between the grab bar and projecting objects above.
 - 3. Toilet accessories required to be accessible shall be mounted with any operable part at maximum 40 inches above the finish floor. CBC Ch. 11B-603.5.
 - 4. The grab bar shall not project more than 3 inches into the 48 inches minimum clear space required required in front of the water closet. CBC Ch. 11B-609.3.
 - 5. Toilet tissue dispensers are to be continuous flow type. CBC Ch. 11B-604.7.
 - 6. Toilet paper and feminine napkin disposals located on the grab bar side of the accessible toilet room or stall shall not project more than the grab bar or 3 inches from the finished wall surface nor be located closer than 1-1/2 inches clear of the tangent point of the grab bar. (Legacy DSA Interpretation.)
 - a. Accessories surface mounted above grab bar will restrict usability.
 - 7. All other accessories shall not project more than 4 inches from wall surface, but cannot encroach into any required clear space.

Arcadia Unified School District Locker Room Alterations tBP/Architecture Project No. 21110.00	Addendum 2	Toilet Accessories 10 28 00 - 2
--	-------------------	------------------------------------

8. Shower controls shall comply with CBC Ch. 11B-608.5.
9. Shower seats shall comply with CBC Ch. 11B-610.3 Shower compartment seats.

2.02 MANUFACTURERS

- A. Commercial Toilet, Shower, and Bath Accessories:
 1. American Specialties, Inc: www.americanspecialties.com/#sle.
 2. Bobrick Washroom Equipment, Inc.: www.bobrick.com.
 3. Bradley Corporation: www.bradleycorp.com/#sle.
 4. Gamco: www.gamcousa.com.
 5. Georgia-Pacific Professional: www.blue-connect.com/#sle.
 6. Kimberly-Clark: www.KCprofessional.com.
 7. Or Equal Substitutions: Section 01 60 00 - Product Requirements.
- B. Provide products of each category type by single manufacturer.

2.03 MATERIALS

- A. Accessories - General: Shop assembled, free of dents and scratches and packaged complete with anchors and fittings, steel anchor plates, adapters, and anchor components for installation.
 1. Grind welded joints smooth.
 2. Fabricate units made of metal sheet of seamless sheets with flat surfaces.
- B. Stainless Steel Sheet: ASTM A666, Type 304.
- C. Stainless Steel Tubing: ASTM A269/A269M, Grade TP304 or TP316.
- D. Mirror Glass: Annealed float glass, ASTM C1036 Type I, Class 1, Quality Q2, with silvering, protective and physical characteristics complying with ASTM C1503.
- E. Mirror Glass: Tempered safety glass, ASTM C1048; and ASTM C1036 Type I, Class 1, Quality Q2, with silvering as required.
- F. Adhesive: Two component epoxy type, waterproof.
- G. Fasteners, Screws, and Bolts: Stainless steel except where fully concealed may be hot dip galvanized; tamper-proof; security type.
- H. Expansion Shields: Fiber, lead, or rubber as recommended by accessory manufacturer for component and substrate.

2.04 FINISHES

- A. Stainless Steel: Satin finish, unless otherwise noted.
- B. Chrome/Nickel Plating: ASTM B456, SC 2, polished finish, unless otherwise noted.

2.05 COMMERCIAL TOILET ACCESSORIES

- A. Toilet Paper Dispenser: Double roll, surface mounted, for coreless type rolls.
 1. Basis of Design Product: B-2892 as manufactured by Bobrick Washroom Equipment, Inc., or approved equal.

Arcadia Unified School District Locker Room Alterations tBP/Architecture Project No. 21110.00	Addendum 2	Toilet Accessories 10 28 00 - 3
--	-------------------	------------------------------------

- B. Toilet Paper Dispenser: Double roll, dual side-by-side partition mounting, stainless steel unit with pivot hinge, tumbler lock.
- C. Toilet Paper Dispenser: Double roll, surface-mounted, stainless steel unit. Provide at semi-ambulatory toilet compartment with adjacent non-accessible compartment and where indicated.
 - 1. Basis of Design Product: B-386 as manufactured by Bobrick Washroom Equipment, Inc., or approved equal.
- D. Combination Toilet Paper/Seat Cover Dispenser with Napkin Disposal: Double roll; Recessed flush with wall, stainless steel; seamless wall flanges, continuous piano hinges.
 - 1. Minimum capacity: 1000 seat covers.
 - 2. Waste receptacle capacity: 1.3 gallons.
- E. Paper Towel Dispenser: Folded paper type, stainless steel, semi-recessed, with viewing slots on sides as refill indicator and tumbler lock.
 - 1. Capacity: 400 multifold minimum.
- F. Combination Towel Dispenser/Waste Receptacle: Recessed flush with wall, stainless steel; seamless wall flanges, continuous piano hinges.
 - 1. Waste receptacle liner: Reusable, heavy-duty vinyl.
 - 2. Towel dispenser capacity: 600 C-fold.
 - 3. Waste receptacle capacity: 6.3 gallons.
- G. Soap Dispenser: Liquid soap dispenser, wall-mounted, surface, with stainless steel cover and horizontal stainless steel tank and working parts; push type soap valve, check valve, and window gauge refill indicator, tumbler lock.
 - 1. Minimum Capacity: 48 ounces.
- H. Mirrors: Stainless steel framed, 1/4 inch thick annealed float glass; ASTM C1036.
 - 1. Annealed Float Glass: Silvering, protective and physical characteristics in compliance with ASTM C1503.
 - 2. Size: As indicated on drawings.
 - 3. Frame: 0.05 inch angle shapes, with mitered and welded and ground corners, and tamperproof hanging system; satin finish.
 - 4. Backing: Full-mirror sized, minimum 0.03 inch galvanized steel sheet and nonabsorptive filler material.
 - 5. Shelf: Stainless steel; gauge and finish to match mirror frame, turned down edges, welded to frame; 5 inches deep, full width of mirror.
- I. Seat Cover Dispenser: Stainless steel, surface-mounted, reloading by concealed opening at base, tumbler lock.
 - 1. Minimum capacity: 250 seat covers.
- J. Grab Bars: Stainless steel, peened surface.
 - 1. Standard Duty Grab Bars:
 - a. Push/Pull Point Load: 250 pound-force, minimum.

- b. Dimensions: 1-1/4 inch outside diameter, minimum 0.05 inch wall thickness, exposed flange mounting, 1-1/2 inch clearance between wall and inside of grab bar.
 - c. Finish: Satin, with peened gripping surface (suffix.99).
 - d. Length and Configuration: As indicated on drawings.
 - 1) Minimum Length for Side Wall of Water Closet: 48 inches.
 - 2) Minimum Length for Rear Wall of Water Closet: 42 inches.
 - e. Basis of Design Product: Snap Flange B-5806 Series as manufactured by Bobrick Washroom Equipment, Inc., or approved equal.
- K. Combination Sanitary Napkin/Tampon Dispenser: Stainless steel, surface-mounted.
- 1. Door: Seamless 0.05 inch door with returned edges and tumbler lock.
 - 2. Cabinet: Fully welded, 0.03 inch thick sheet.
 - 3. Operation: 25 cent coin required to operate dispenser. Provide locked coin box, separately keyed.
 - a. Product selection and coin return push button-operation shall be certified ADA Standards, ICC/ANSI A117.1 compliant by third party certification for operation with one hand with less than 5 pounds of force (22.2 N) without tight grasping, pinching or twisting of the wrist.
 - 4. Identify dispensers slots without using brand names.
 - 5. Minimum capacity: 15 napkins and 20 tampons.
- L. Sanitary Napkin Disposal Unit: Stainless steel, surface-mounted, self-closing door, locking bottom panel with full-length stainless steel piano-type hinge, removable receptacle.
- 1. Basis of Design Product: B-353 as manufactured by Bobrick Washroom Equipment, Inc., or approved equal.

2.06 COMMERCIAL SHOWER AND BATH ACCESSORIES

- A. Shower Curtain Rod: Stainless steel tube, 1 inch outside diameter, 0.04 inch wall thickness, satin-finished, with 3 inch outside diameter, minimum 0.04 inch thick satin-finished stainless steel flanges, for installation with exposed fasteners.
- 1. Basis of Design Product: Classic Series Extra-Heavy-Duty Shower Curtain Rod B-6047 as manufactured by Bobrick Washroom Equipment, Inc., or approved equal.
- B. Shower Curtain:
- 1. Material: Opaque vinyl, 0.008 inch thick, matte finish, with antibacterial treatment, flameproof and stain-resistant.
 - 2. Size: 36 by 72 inches, hemmed edges.
 - 3. Grommets: Stainless steel; pierced through top hem on 6 inch centers.
 - 4. Color: White.
 - a. Basis of Design Product: Vinyl Shower Curtains, 204-3 as manufactured by Bobrick Washroom Equipment, Inc., or approved equal.
 - 5. Shower Curtain Hooks: Chrome-plated or stainless steel spring wire designed for snap closure.

Arcadia Unified School District Locker Room Alterations tBP/Architecture Project No. 21110.00	Addendum 2	Toilet Accessories 10 28 00 - 5
--	-------------------	------------------------------------

6. **Basis of Design Product: Stainless Steel Shower Curtain Hook, 204-1 as manufactured by Bobrick Washroom Equipment, Inc., or approved equal.**
- C. **Folding Shower Seat: Wall-mounted surface; welded tubular seat frame, structural support members, swing-down legs, hinges, and mechanical fasteners of Type 304 stainless steel, rectangular seat.**
 1. **Seat: Phenolic or polymeric composite one-piece seat or seat slats, of color as selected .**
 2. **Size: ADA Standards compliant.**
 3. **Basis of Design Product: B-5181 as manufactured by Bobrick Washroom Equipment, Inc., or approved equal.**
- D. **Robe Hook: Heavy-duty stainless steel, double-prong, rectangular-shaped bracket and backplate for concealed attachment, satin finish.**
 1. **Basis of Design Product: B-7672 as manufactured by Bobrick Washroom Equipment, Inc., or approved equal.**

2.062.07 UNDER-LAVATORY PIPE AND SUPPLY COVERS

- A. Under-Lavatory Pipe and Supply Covers:
 1. Insulate exposed drainage piping, including hot, cold, and tempered water supplies under lavatories or sinks to comply with ADA Standards.
 2. Exterior Surfaces: Smooth non-absorbent, non-abrasive surfaces.
 3. Construction: 1/8 inch flexible PVC.
 - a. Surface Burning Characteristics: Flame spread index of 25 or less and smoke developed index of 450 or less, when tested in accordance with ASTM E84.
 - b. Comply with ASTM C1822, type indicated.
 - c. Comply with ASME A112.18.9.
 - d. Comply with ADA Standards and CBC Ch. 11B.
 - e. Microbial and Fungal Resistance: Comply with ASTM G21.
 4. Color: White.
 5. Fasteners: Reusable, snap-locking fasteners with no sharp or abrasive external surfaces.
 6. Products:
 - a. Bobrick Washroom Equipment, Inc.; www.bobrick.com.
 - b. Bradley Corporation : www.bradleycorp.com.
 - c. IPS Corporation Lav Guard 2 Undersink Pipe Covers: www.ipscorp.com.
 - d. IPS Corporation TrueBro Lav Shield: www.ipscorp.com.

2.072.08 UTILITY ROOM ACCESSORIES

- A. Combination Utility Shelf/Mop and Broom Holder: 0.05 inch thick stainless steel, Type 304, with 1/2 inch returned edges, 0.06 inch steel wall brackets.
 1. Drying rod: Stainless steel, 1/4 inch diameter.

Arcadia Unified School District Locker Room Alterations tBP/Architecture Project No. 21110.00	Addendum 2	Toilet Accessories 10 28 00 - 6
--	-------------------	------------------------------------

2. Hooks: Two, 0.06 inch stainless steel rag hooks at shelf front.
3. Mop/broom holders: Three spring-loaded rubber cam holders at shelf front.
4. Length: 36 inches.
5. Product: See schedule on Drawings.

PART 3 EXECUTION

3.01 EXAMINATION

- A. Verify existing conditions before starting work.
- B. Verify exact location of accessories for installation.
- C. Before covering wall framing with gypsum board, examine framing to ensure that backing plates and grab bar mounting kits have been installed behind surface mounted accessories in such positions as to receive all attachment screws.
- D. Verify that pipes, vents, conduits and other construction features do not protrude into rough wall opening space required for recessed accessories.
- E. Verify that field measurements are as indicated on drawings.
- F. Verify installation of blocking, reinforcing plates, and concealed anchors in walls and ceilings.

3.02 PREPARATION

- A. Deliver inserts and rough-in frames to site for timely installation.
- B. Provide templates and rough-in measurements as required.

3.03 INSTALLATION

- A. Install accessories in accordance with manufacturers' instructions in locations indicated on drawings.
 1. Exception: Install surface mounted accessories other than grab bars with screws, molly or toggle bolts only to studs or through backing plates attached directly to studs.
 2. At combination units placed behind a grab bar set the perimeter trim tight against the backing board.
 - a. Face of this unit shall not project beyond the tile or applied finish face. Maintain the required 1-1/2 inch clearance.
 - b. Coordinate surrounding finish trim with bullnose tile, radius, or sloped profile trim.
- B. Install plumb and level, securely and rigidly anchored to substrate.
- C. Mounting Heights: As required by accessibility regulations, unless otherwise indicated.
 1. Grab Bars: As indicated on drawings.
 - a. Adult mounting height to be between minimum 33 inches to maximum 36 inches to top tangent point. CBC 11B-609.4 Position of Grab Bars.
 2. Mirrors: 40 inch, measured from floor to bottom of mirrored surface.
 3. Seat Cover Dispenser:

Arcadia Unified School District Locker Room Alterations tBP/Architecture Project No. 21110.00	Addendum 2	Toilet Accessories 10 28 00 - 7
--	-------------------	------------------------------------

- a. Shall not be located closer than 1-1/2 inches clear of the tangent point of the grab bar.
 - b. If surface mounted and located under the grab bar provide a minimum 5 inches clear under unit for refilling.
4. Clothes Bumper/Coat Hook: 40 to 48 inches. CBC 11B-603.4 Coat hooks, shelves and medicine cabinets
5. Shelf with Mop and Broom Holders: 40 to 48 inches. CBC 11B-603.4 Coat hooks, shelves and medicine cabinets
6. Other Accessories: As indicated on drawings.


3.04 PROTECTION

- A. Protect installed accessories from damage due to subsequent construction operations.

END OF SECTION


Arcadia Unified School District Locker Room Alterations tBP/Architecture Project No. 21110.00	Addendum 2	Toilet Accessories 10 28 00 - 8
--	-------------------	------------------------------------

C:\Users\moria\BTPA\Documents\AHS_Archie\of\allies_P1\Lockers_Central_innovor\RC0303.mxd

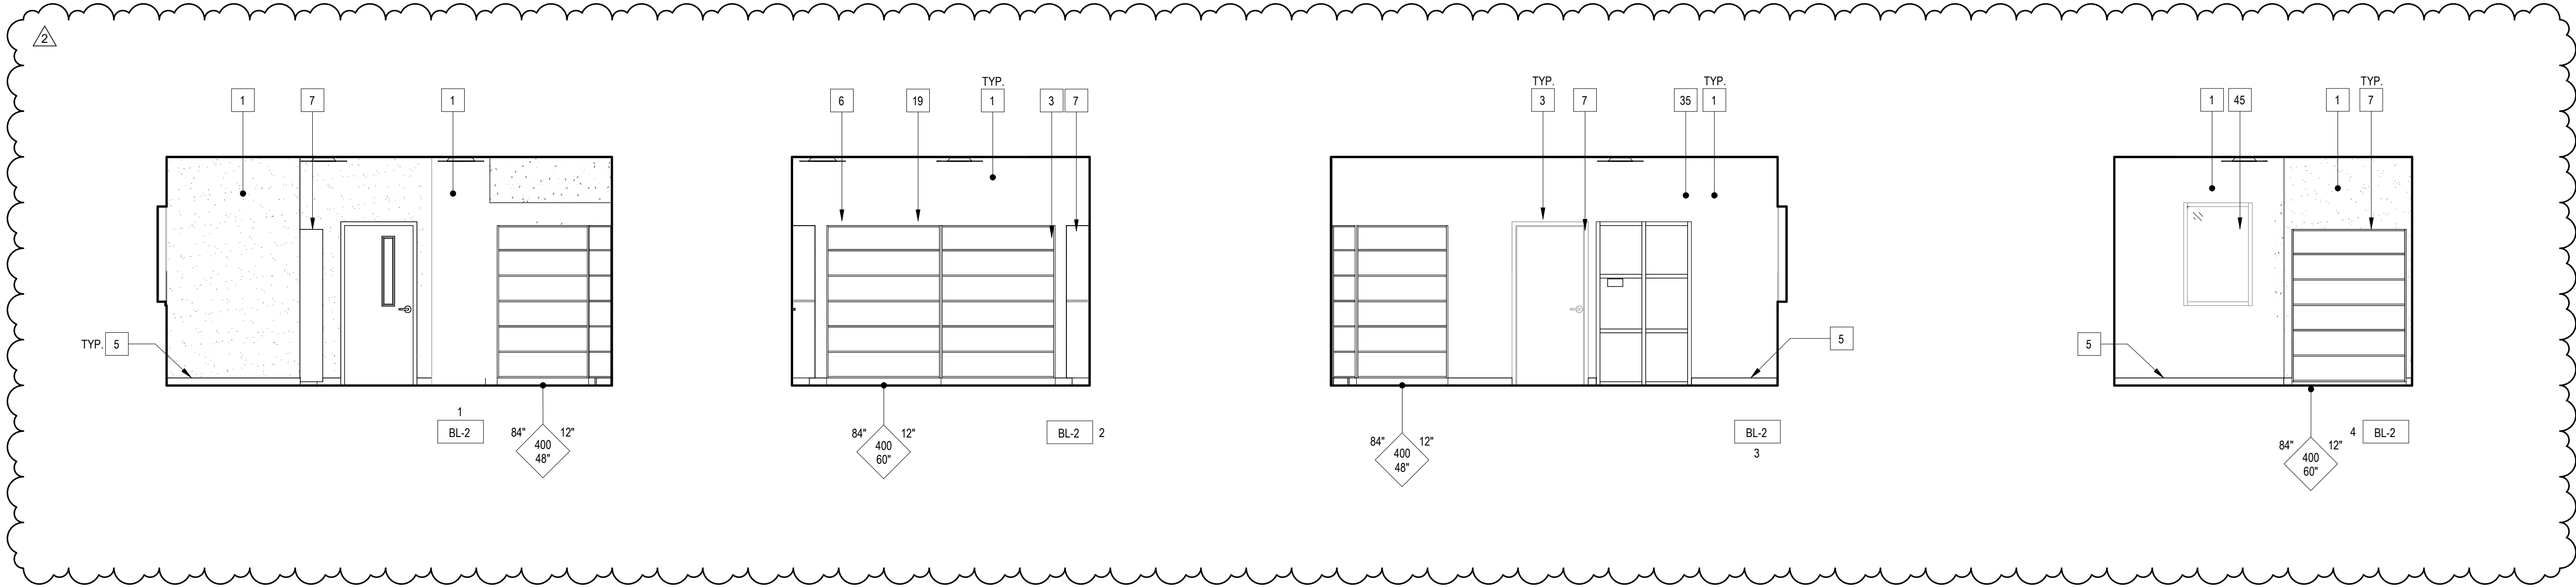


OFFICE
SCALE: 1/4"=1'-0"

BL-2

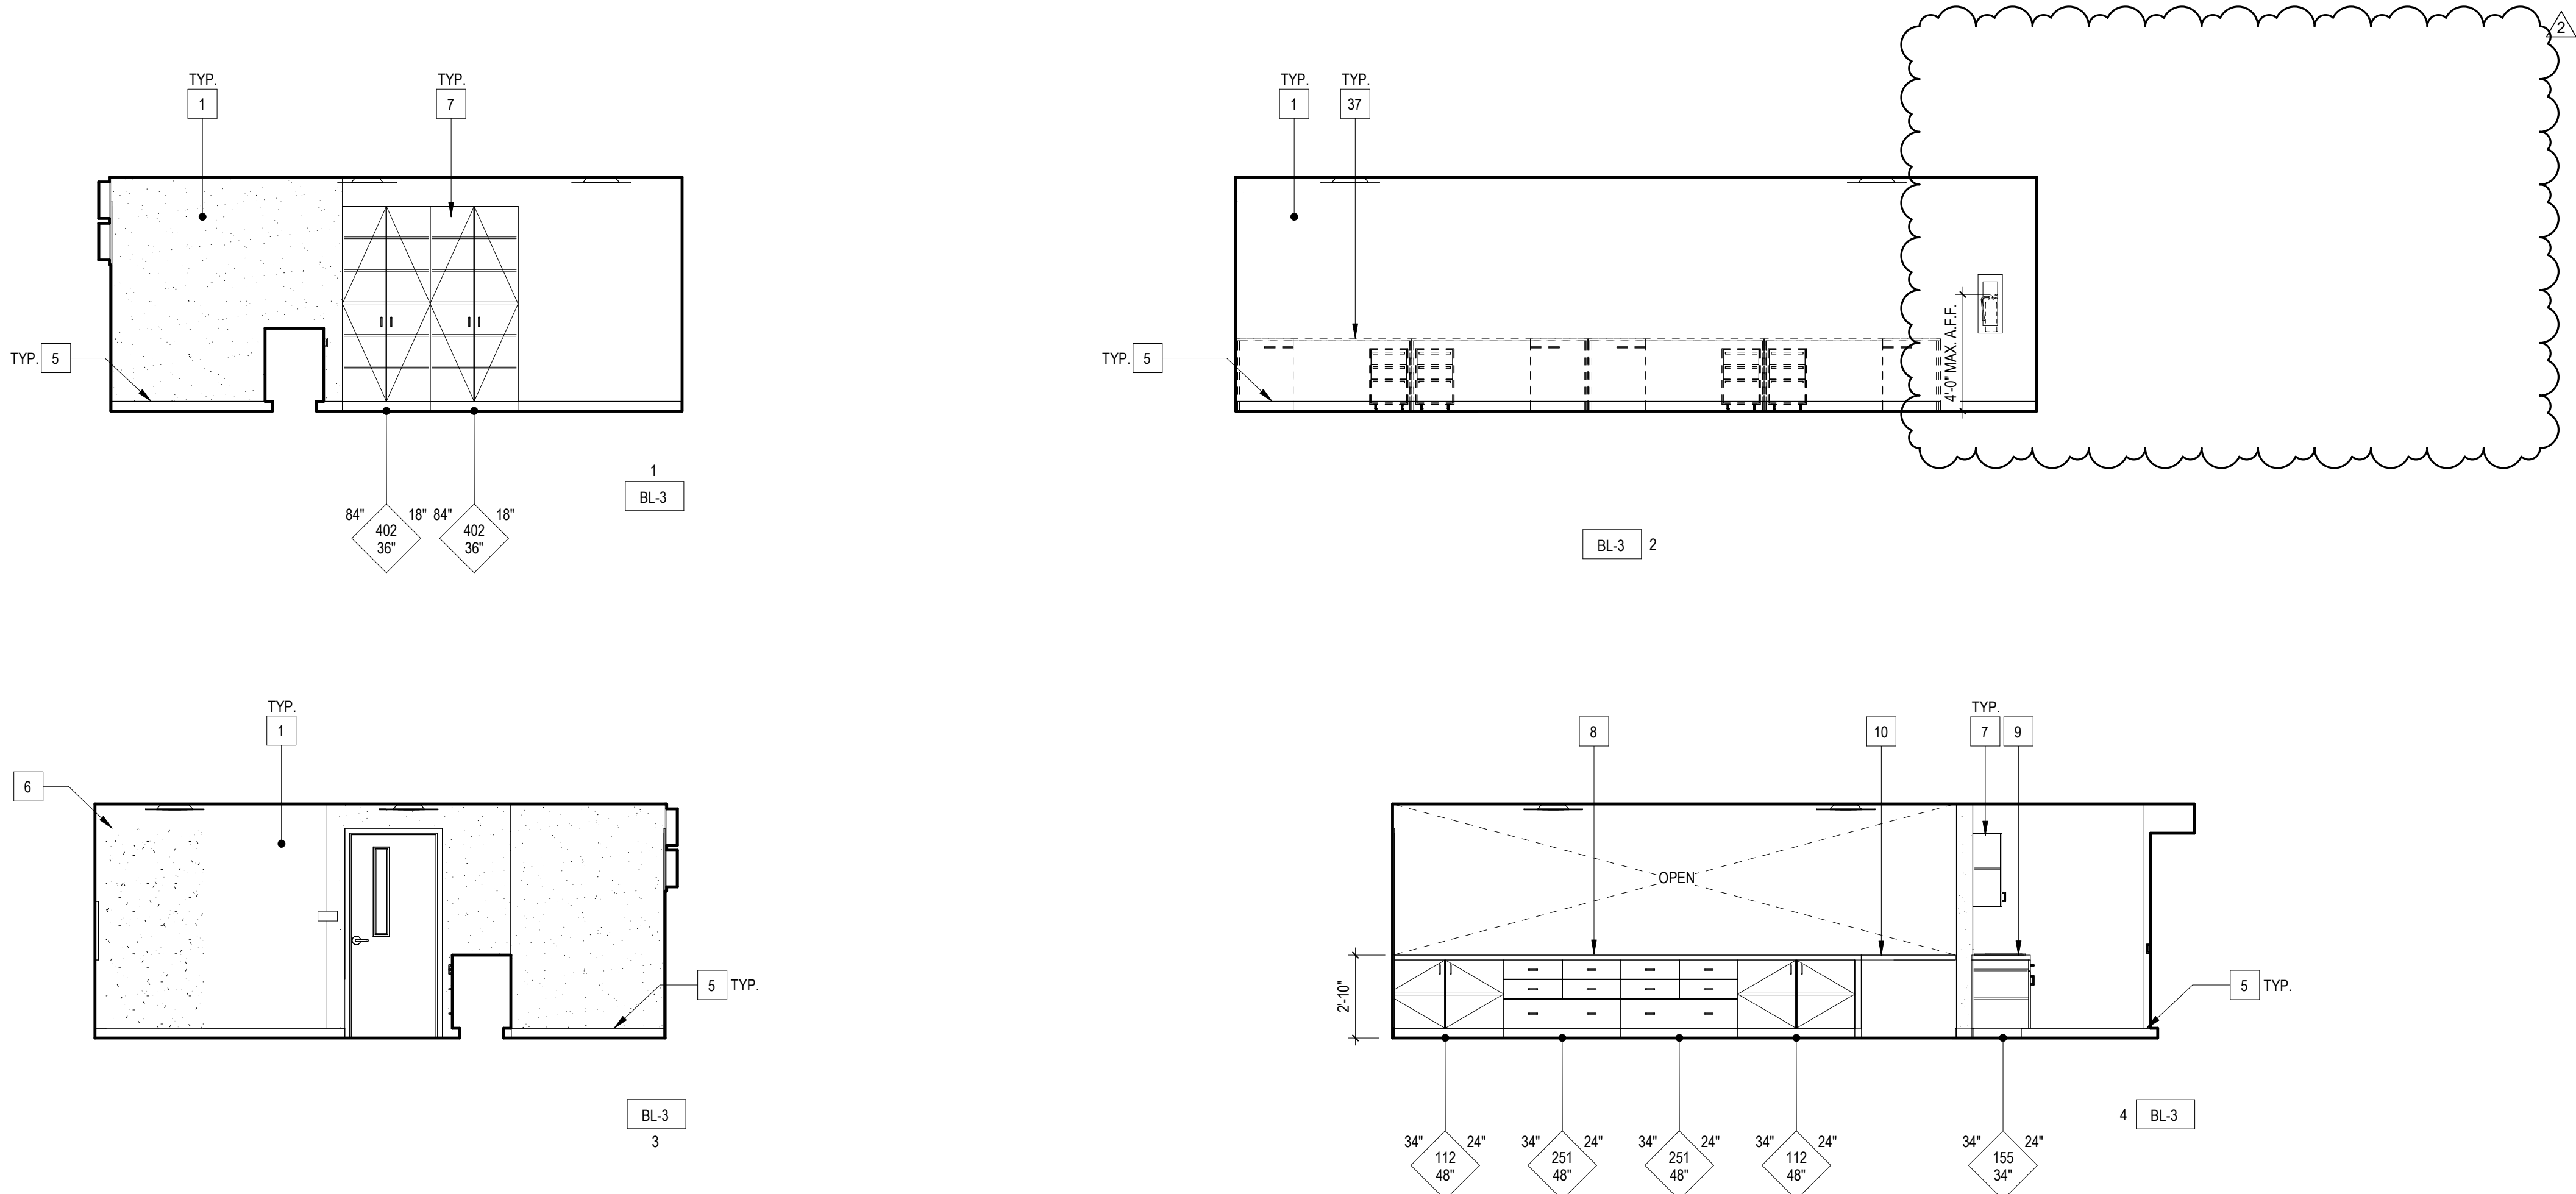


ASB OFFICE
SCALE: 1/4"=1'-0"

BL-3

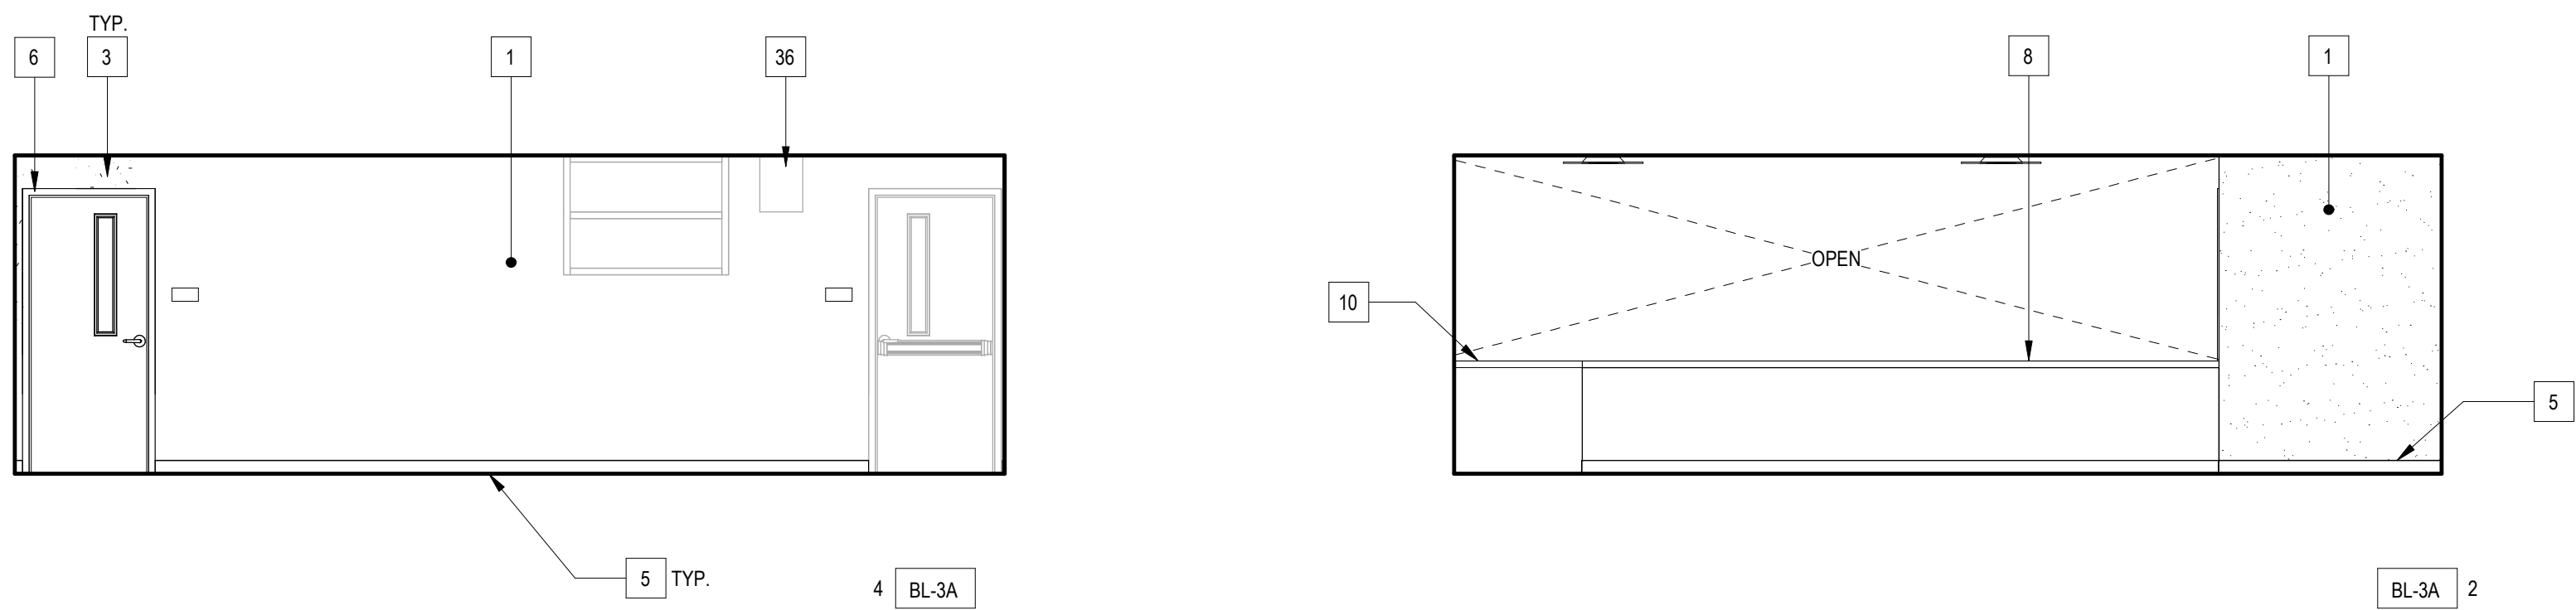

ASB COUNTER
SCALE: 1/4"=1'-0"

BL-3A

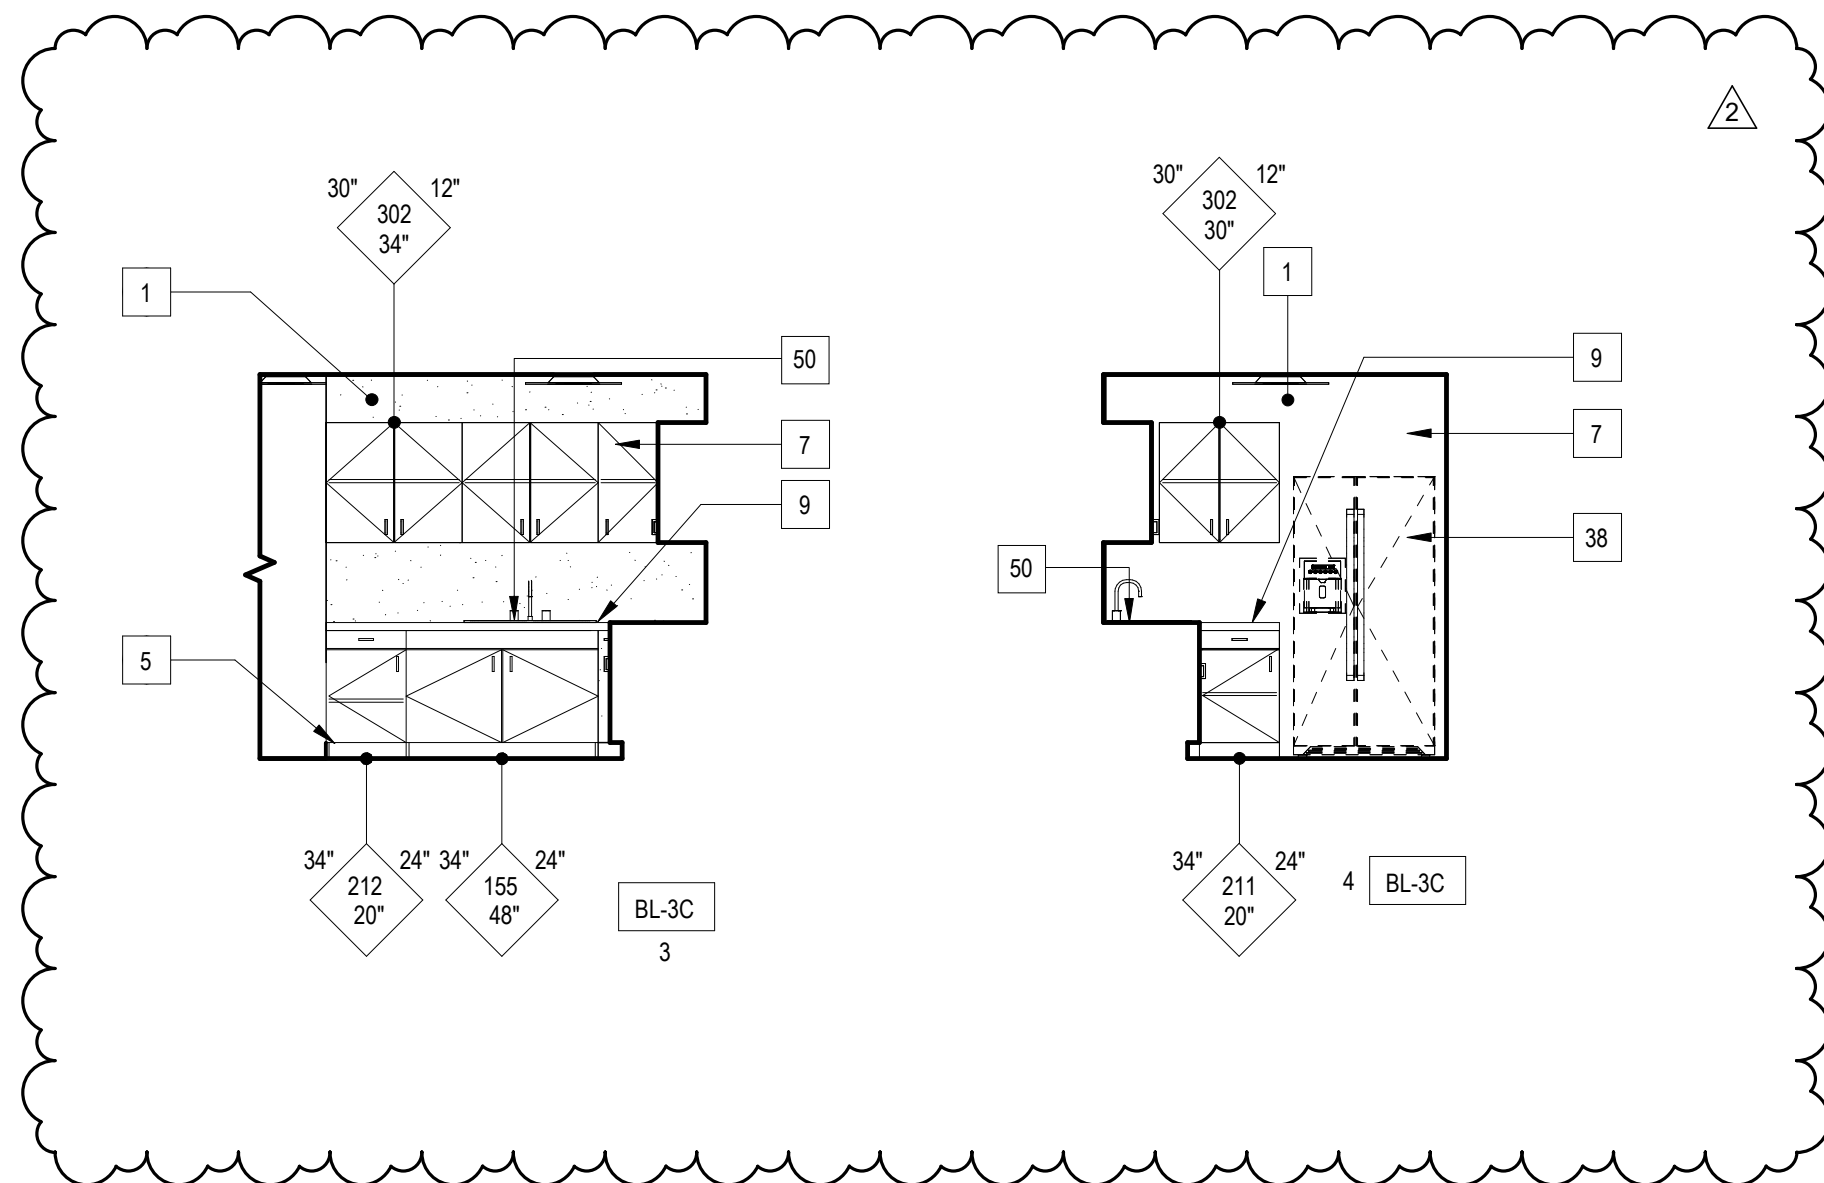

KITCHENETTE
SCALE: 1/4"=1'-0"



BL-3C

REMODEL KEY NOTES

- 1 GYP. BOARD
2 INTERIOR PLASTER
3 INFILL (E) OPENING WITH FRAMED WALL PER PLAN. FINISH TO MATCH ADJACENT SURFACE
4 FINISH AT (E) WOOD STUD WALL. MATCH AND PROVIDE SMOOTH TRANSITION TO ADJACENT SURFACE
5 RESILIENT BASE
6 HOLLOW METAL DOOR AND FRAME, PER SCHEDULE
7 CASEWORK, SEE DETAIL 4 / 6.01
8 COUNTERTOP
9 COUNTERTOP AND BACKSPLASH
10 FLIP-UP COUNTERTOP
11 LOCKER BASE, SEE DETAIL 10 / 6.02
12 WALL MOUNTED BENCH WITH SOLID PLASTIC TOP. SEE DETAIL 12 / 6.02
13 24"x48" ACCESSIBLE PEDESTAL BENCH WITH SOLID PLASTIC TOP. SEE DETAIL 14 / 6.02
14 12"x16"x60" 2-TIER PLASTIC LOCKERS. SEE DETAIL 10 / 6.02
15 LOCKER CLOSURE PANEL
16 MARKER BOARD, FOR MOUNTING. SEE DETAIL 16 / 6.01
17 PARTIAL HEIGHT WALL. SEE DETAIL 20 / 4.01
18 WINDOW, PER WINDOW SCHEDULE
19 INFILL OPENING WITH WOOD FILLER PANEL
20 AIR REGISTER, SEE MECHANICAL PLAN SHEET M2-1
21 FROSTED GLAZING, PER WINDOW SCHEDULE. (E) WINDOW, FRAME, AND TRIM TO REMAIN.
22 (E) 10" TO REMAIN. PROTECT IN PLACE
23 12"x12"x22" 2-TIER PLASTIC LOCKERS, MOUNT TO (E) CONCRETE CURB. SEE DETAIL 7 / 6.01
24 WOOD WAINSCOT
25 SOLID PLASTIC PARTITION. SEE DETAIL 19 / 6.01
26 24"x48" ACCESSIBLE FOLDING BENCH. SEE DETAIL 20 / 6.02
27 (E) WALL MOUNTED EQUIPMENT AND CONDUIT TO REMAIN. PROTECT IN PLACE
28 18" HIGH PEDESTAL BENCH WITH SOLID PLASTIC TOP. SEE DETAIL 17 / 6.02
29 AIR DUCT, SEE MECHANICAL PLAN, SHEET M2-1
30 (E) WALL MOUNTED EQUIPMENT AND CONDUIT TO REMAIN. TEMPORARILY DISMOUNT DURING DEMOLITION AS NEEDED AND REMOUNT AT (E) LOCATION.
31 RELOCATE (E) SWITCH, DEVICE BOX, AND SURFACE MOUNTED CONDUIT
32 REMOVE (E) ELECTRICAL DEVICES AND ASSOCIATED CONDUITS
33 (E) WALL MOUNTED EQUIPMENT TO REMAIN. PROTECT IN PLACE
34 DESK, O.F.C.
35 REFRIGERATOR, O.F.O.I
36 ACCESSIBLE SHOWER FIXTURE
37 25.5" WIDE ACCESSIBLE FOLDING SHOWER BENCH
38 TERRAZZO
39 (E) WINDOW TO REMAIN
40 TERRAZZO EPOXY WALL BASE
41 DOUBLE COMPARTMENT STAINLESS STEEL SINK. (1) 5" DEEP HANDWASH SINK AND (1) 10" DEEP SCRUB SINK

DIVISION OF THE STATE ARCHITECT
355 S. GRAND AVE, SUITE 2100
LOS ANGELES, CA 90071
ph: 213.897.3995 fx: 213.897.3159/0726
DSA Application # 03-123759
DSA File # 19-H32

agency

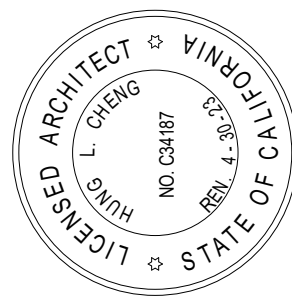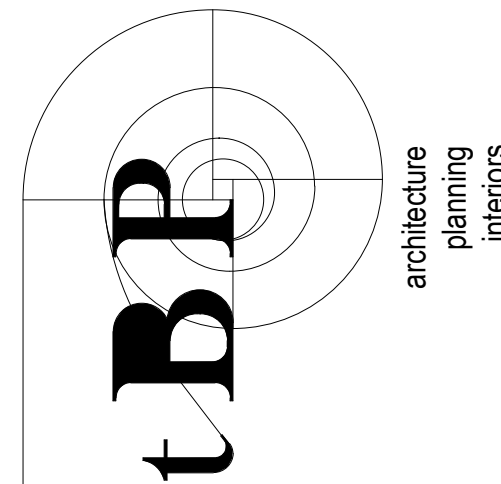

tBP/architecture
4611 Teller Avenue
Newport Beach, CA 92660
ph: 949.673.0300 fx: 949.732.3895

architect

consultant

ARCADIA HIGH SCHOOL LOCKER ROOM ALTERATION

180 CAMPUS DR.
ARCADIA, CA 91006

owner

tBP project number: 21110.00

file name:

drawn by: Author checked by: Checker

date: 12/20/2023

rev: 2 date: 03/17/25 description: ADDENDUM 2

THIS DRAWING AND THE DESIGN, DEPICTIONS, IDEAS AND OTHER INFORMATION CONTAINED HEREIN CONSTITUTE UNPUBLISHED WORK OF ARCHITECTURE, AND SHALL REMAIN PROPERTY OF ARCHITECTURE IN PERPETUITY. NO PART THEREOF SHALL BE REPRODUCED, DISCLOSED, DISTRIBUTED, SOLD, PUBLISHED OR OTHERWISE USED IN ANY WAY WITHOUT THE ADVANCED EXPRESS WRITTEN CONSENT OF ARCHITECTURE.

drawing title:
INTERIOR ELEVATION

drawing no.:

A9-1



DESCRIPTION

1 GYP BOARD

2 INTERIOR PLASTER

3 NFLL (E) OPENING WITH FRAMED WALL PER PLAN. FINISH TO MATCH ADJACENT SURFACE

4 FINISH AT (E) WOOD STUD WALL. MATCH AND PROVIDE SMOOTH TRANSITION TO ADJACENT SURFACE

5 RESILIENT BASE

6 HOLLOW METAL DOOR AND FRAME, PER SCHEDULE

7 CASEWORK. SEE DETAIL 4.6/0.1

8 COUNTERTOP

9 COUNTERTOP AND BACKSPLASH

10 FLUPUP COUNTERTOP

12 LOOKER BASE. SEE DETAIL 10 / 6.02

13 WALL MOUNTED BENCH WITH SOLID PLASTIC TOP. SEE DETAIL 12 / 6.02

14 2"x4" ACCESSIBLE PEDESTAL BENCH WITH SOLID PLASTIC TOP. SEE DETAIL 14 / 6.02

15 12"x16"x2" TIER PLASTIC LOCKERS. SEE DETAIL 10 / 6.02

16 WOOD CLOUSE PANEL

17 MARKER BOARD, FOR MOUNTING. SEE DETAIL 16 / 6.01

18 PARTIAL HEIGHT WALL. SEE DETAIL 20 / 4.01

19 WINDOW. PER WINDOW SCHEDULE

20 NFLL OPENING WITH WOOD FILLER PANEL

21 AIR REGISTER. SEE MECHANICAL PLAN SHEET M-2

22 FROSTED GLAZING. PER WINDOW SCHEDULE. (E) WINDOW, FRAME, AND TRIM TO REMAIN

23 (E) DF TO REMAIN. PROTECT IN PLACE

24 12"x12"x2" TIER PLASTIC LOCKERS. MOUNT TO (E) CONCRETE CURB. SEE DETAIL 7 / 6.01

26 WOOD WAINSCOT

26 SOLID PLASTIC PARTITION. SEE DETAIL 18 / 6.01

27 2"x4" ACCESSIBLE FOLDING BENCH. SEE DETAIL 20 / 4.02

28 (E) WALL MOUNTED EQUIPMENT AND CONDUIT TO REMAIN. PROTECT IN PLACE

29 18" HIGH PEDESTAL BENCH WITH SOLID PLASTIC TOP. SEE DETAIL 17 / 6.02

30 AIR. CUIT. SEE MECHANICAL PLAN, SHEET M-2

31 (E) WALL MOUNTED EQUIPMENT AND CONDUIT TO REMAIN. TEMPORARILY DISMOUNT DURING DEMOLITION AS NEEDED AND REMOUNT AT (E) LOCATION

34 RELOCATE (E) SWITCH, DEVICE BOX, AND SURFACE MOUNTED CONDUIT REMOVE (E) ELECTRICAL BOXES AND ASSOCIATED CONDUITS

35 1/2" ANGLE IRON X 2" X 1/2" TO REMAIN. PROTECT IN PLACE

36 DESK TOP (E)

37 REFRIGERATOR, D.O.F.O.I



38 ACCESSIBLE SHOWER FIXTURE

39 25.9" WIDE ACCESSIBLE FOLDING SHOWER BENCH

41 TERRAZZO

42 (E) WINDOW TO REMAIN

43 TERRAZZO EPOXY WALL BASE

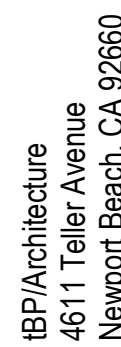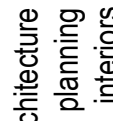agency

architect

consultant

ARCADIA HIGH SCHOOL
LOCKER ROOM ALTERATION

180 CAMPUS DR.
ARCADIA, CA 91006

ARCADIA UNIFIED SCHOOL DISTRICT

owner

tBP project number: 21110.00

file name:

drawn by: Author checked by: Checker

date: 12/20/2023

rev:	date:	description:
2	03/17/25	ADDENDUM


THIS DRAWING AND THE DESIGNS, DEPICTIONS, IDEAS AND OTHER INFORMATION CONTAINED HEREIN CONSTITUTE UNPUBLISHED WORK OF IBPARCHITECTURE AND SHALL REMAIN PROPERTY OF IBPARCHITECTURE IN PERPETUITY. NO PART THEREOF SHALL BE REPRODUCED, DISCLOSED, DISTRIBUTED, SOLD, PUBLISHED OR OTHERWISE USED IN ANY WAY WITHOUT THE ADVANCED EXPRESS WRITTEN CONSENT OF IBPARCHITECTURE.

drawing title:
INTERIOR ELEVATION

drawing no.:


A9-3



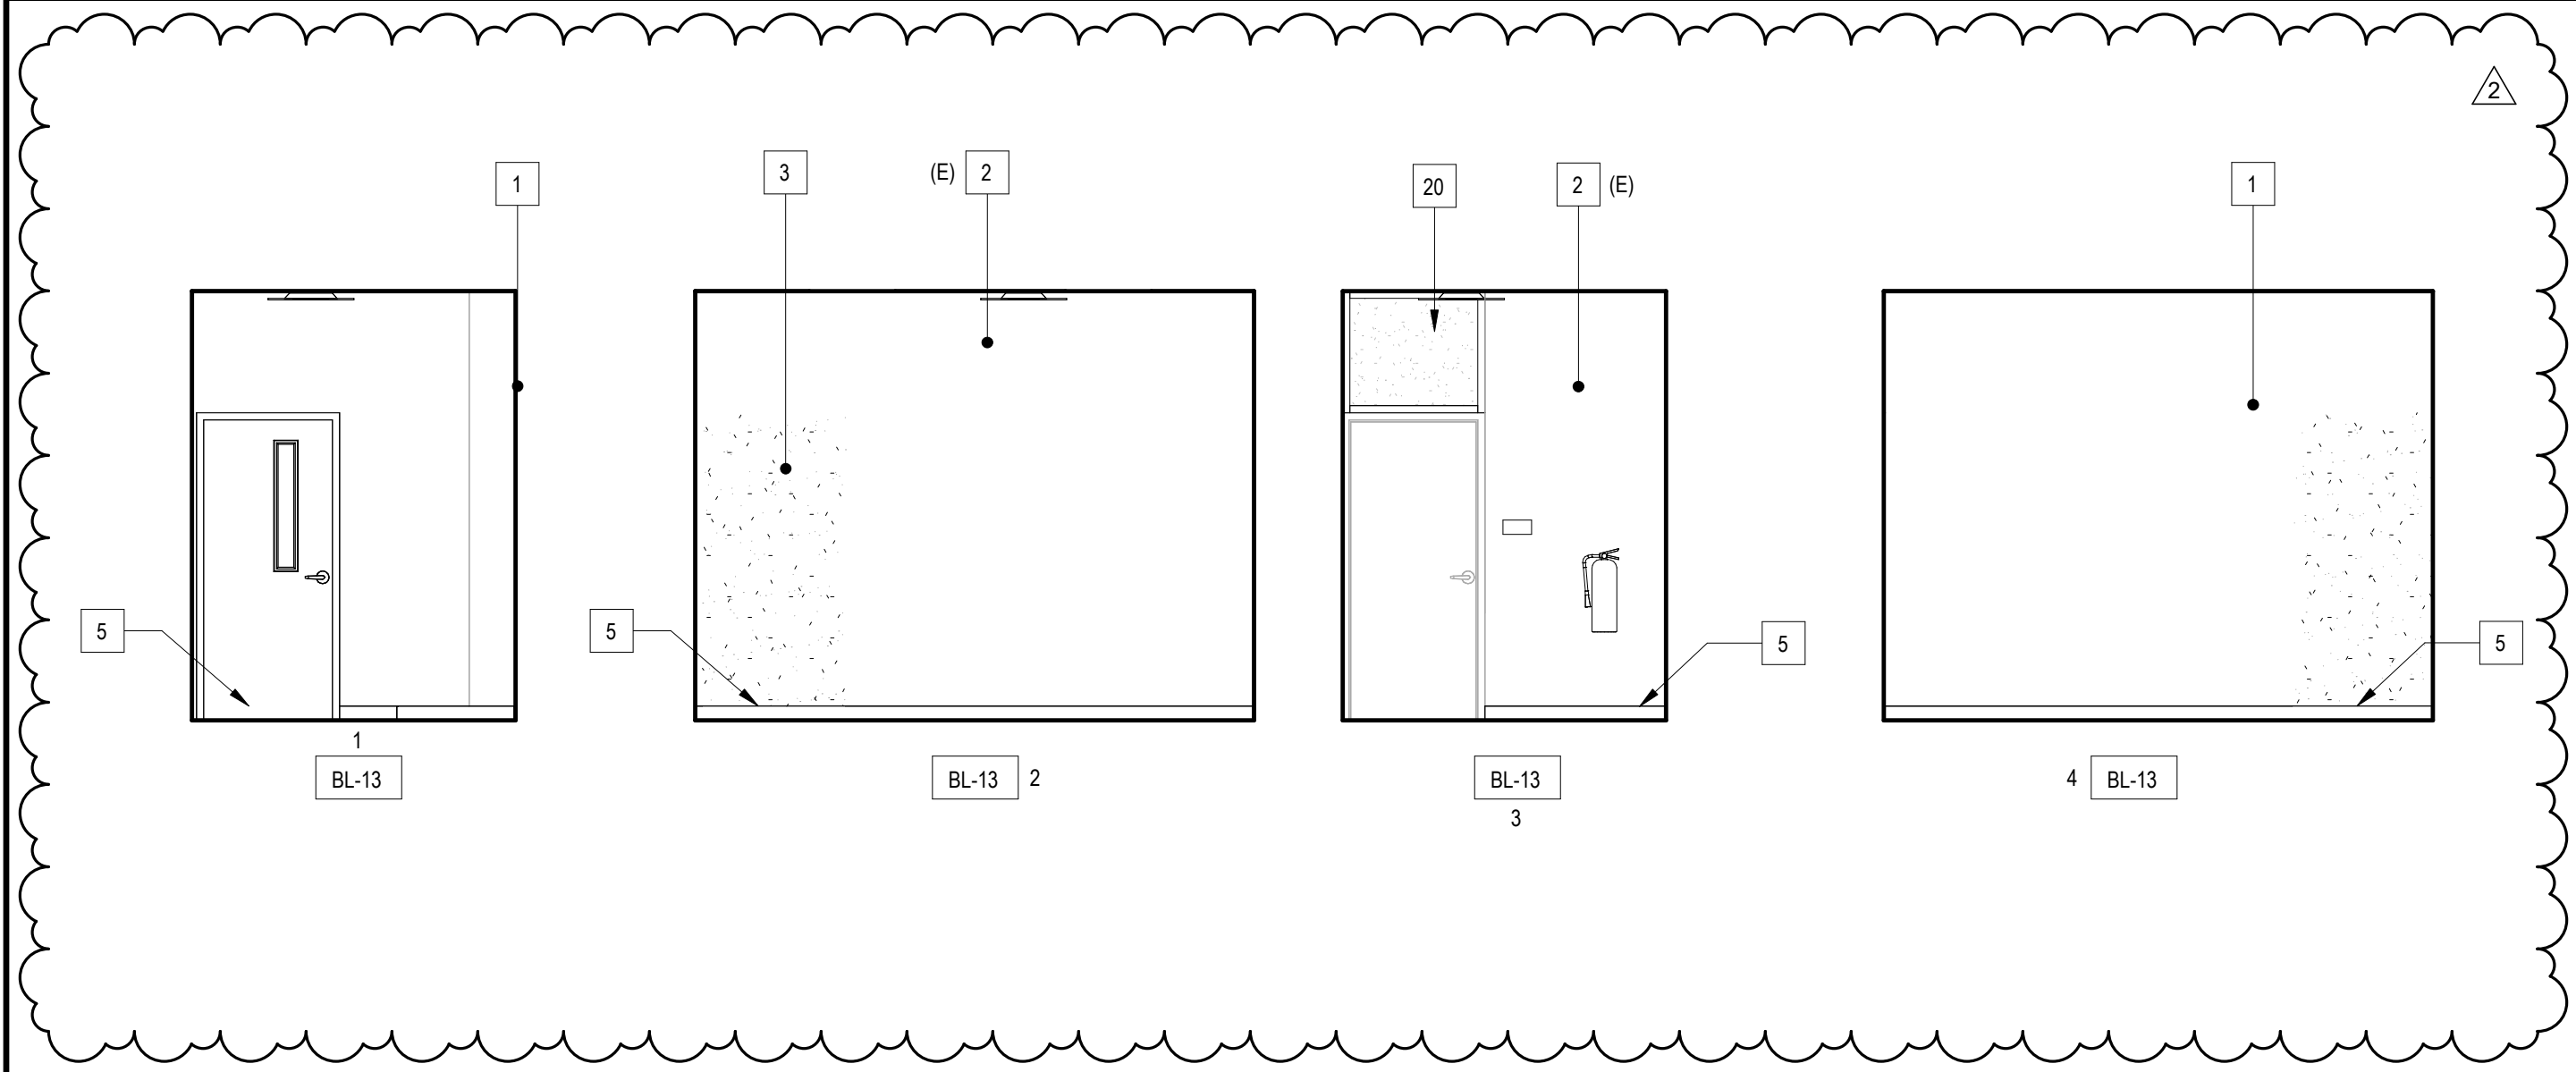

P.E. ATTENDANT OFFICE
SCALE: 1/4"=1'-0"

BL-13

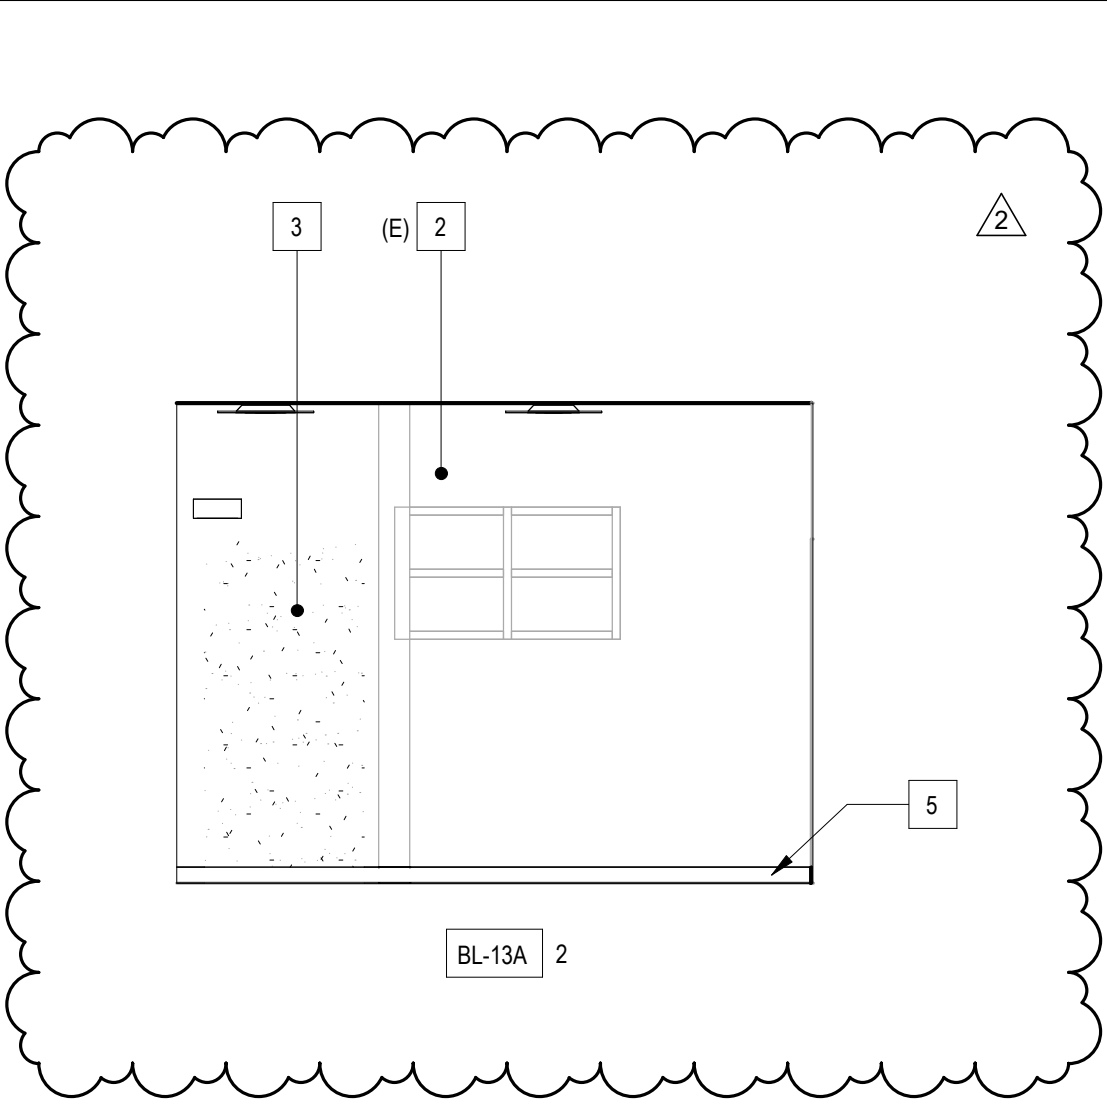

SHARED STOR./ TEMP. OFFICE
SCALE: 1/4"=1'-0"



BL-13A

REMODEL KEY NOTES

- ← # DESCRIPTION:
- 1 GYP. BOARD
 - 2 INTERIOR PLASTER
 - 3 INFILL (E) OPENING WITH FRAMED WALL PER PLAN. FINISH TO MATCH ADJACENT SURFACE
 - 4 FINISH AT (E) WOOD STUD WALL. MATCH AND PROVIDE SMOOTH TRANSITION TO ADJACENT SURFACE
 - 5 RESILIENT BASE
 - 6 HOLLOW METAL DOOR AND FRAME, PER SCHEDULE
 - 7 CASEWORK. SEE DETAIL. 4 / 6.01
 - 8 COUNTERTOP
 - 9 COUNTERTOP AND BACKSPLASH
 - 10 FLIP-UP COUNTERTOP
 - 12 LOCKER BASE. SEE DETAIL. 10 / 6.02
 - 13 WALL MOUNTED BENCH WITH SOLID PLASTIC TOP. SEE DETAIL. 12 / 6.02
 - 14 24"x48" ACCESSIBLE PEDESTAL BENCH WITH SOLID PLASTIC TOP. SEE DETAIL. 14 / 6.02
 - 15 12"x16"x60" 2-TIER PLASTIC LOCKERS. SEE DETAIL. 10 / 6.02
 - 16 LOCKER CLOSURE PANEL
 - 17 MARKER BOARD, FOR MOUNTING. SEE DETAIL. 16 / 6.01
 - 18 PARTIAL HEIGHT WALL. SEE DETAIL. 20 / 4.01
 - 19 WINDOW, PER WINDOW SCHEDULE
 - 20 INFILL OPENING WITH WOOD FILLER PANEL
 - 21 AIR REGISTER, SEE MECHANICAL PLAN SHEET M2-1
 - 22 FROSTED GLAZING, PER WINDOW SCHEDULE. (E) WINDOW, FRAME, AND TRIM TO REMAIN.
 - 23 (E) TOP TO REMAIN. PROTECT IN PLACE
 - 24 12"x12"x22" 2-TIER PLASTIC LOCKERS, MOUNT TO (E) CONCRETE CURB. SEE DETAIL. 7 / 6.01
 - 25 WOOD WAINSCOT
 - 26 SOLID PLASTIC PARTITION. SEE DETAIL. 19 / 6.01
 - 27 24"x48" ACCESSIBLE FOLDING BENCH. SEE DETAIL. 20 / 6.02
 - 28 (E) WALL MOUNTED EQUIPMENT AND CONDUIT TO REMAIN. PROTECT IN PLACE
 - 29 18" HIGH PEDESTAL BENCH WITH SOLID PLASTIC TOP. SEE DETAIL. 17 / 6.02
 - 30 AIR DUCT, SEE MECHANICAL PLAN, SHEET M2-1
 - 33 (E) WALL MOUNTED EQUIPMENT AND CONDUIT TO REMAIN. TEMPORARILY DISMOUNT DURING DEMOLITION AS NEEDED AND REMOUNT AT (E) LOCATION.
 - 34 RELOCATE (E) SWITCH, DEVICE BOX, AND SURFACE MOUNTED CONDUIT
 - 35 REMOVE (E) ELECTRICAL DEVICES AND ASSOCIATED CONDUITS
 - 36 (E) WALL MOUNTED EQUIPMENT AND CONDUIT TO REMAIN. TEMPORARILY DISMOUNT DURING DEMOLITION AS NEEDED AND REMOUNT AT (E) LOCATION.
 - 37 DESK, O.F.C.I.
 - 38 REFRIGERATOR, O.F.O.I.
 - 39 ACCESSIBLE SHOWER FIXTURE
 - 40 25.5" WIDE ACCESSIBLE FOLDING SHOWER BENCH
 - 41 TERRAZZO
 - 45 (E) WINDOW TO REMAIN
 - 46 TERRAZZO EPOXY WALL BASE

DIVISION OF THE STATE ARCHITECT
355 S. GRAND AVE, SUITE 2100
LOS ANGELES, CA 90071
ph: 213.897.3995 fx: 213.897.3159/0726
DSA Application # 03-123759
DSA File # 19-H32

agency

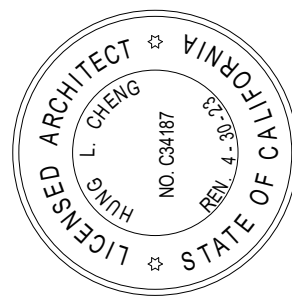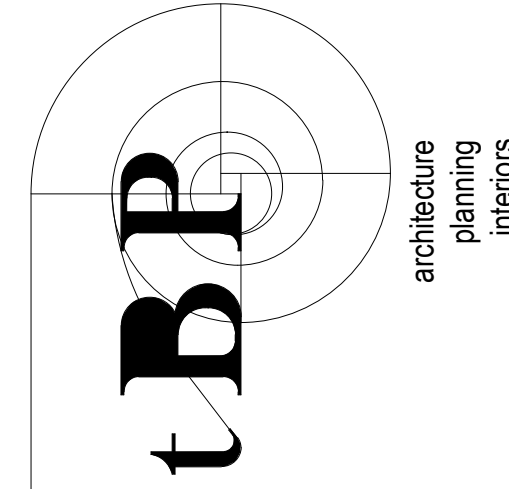

tBP/architecture
4611 Teller Avenue
Newport Beach, CA 92660
ph: 949.673.0300 fx: 949.732.3895

architect

consultant

ARCADIA HIGH SCHOOL
LOCKER ROOM ALTERATION

180 CAMPUS DR.
ARCADIA, CA 91006

owner

tBP project number: 21110.00

file name:

drawn by: Author checked by: Checker

date: 12/20/2023

rev: 2 date: 03/17/25 description: ADDENDUM 2


THIS DRAWING AND THE DESIGN, DEPICTIONS, IDEAS AND OTHER INFORMATION CONTAINED HEREIN CONSTITUTE UNPUBLISHED WORK OF ARCHITECTURE, AND SHALL REMAIN PROPERTY OF tBP/ARCHITECTURE IN PERPETUITY. NO PART OF THIS WORK SHALL BE REPRODUCED, DISCLOSED, DISTRIBUTED, SOLD, PUBLISHED OR OTHERWISE USED IN ANY MANNER WITHOUT THE ADVANCED EXPRESS WRITTEN CONSENT OF tBP/ARCHITECTURE.

drawing title:
INTERIOR ELEVATION

drawing no.:


A9-4

KEYPLAN

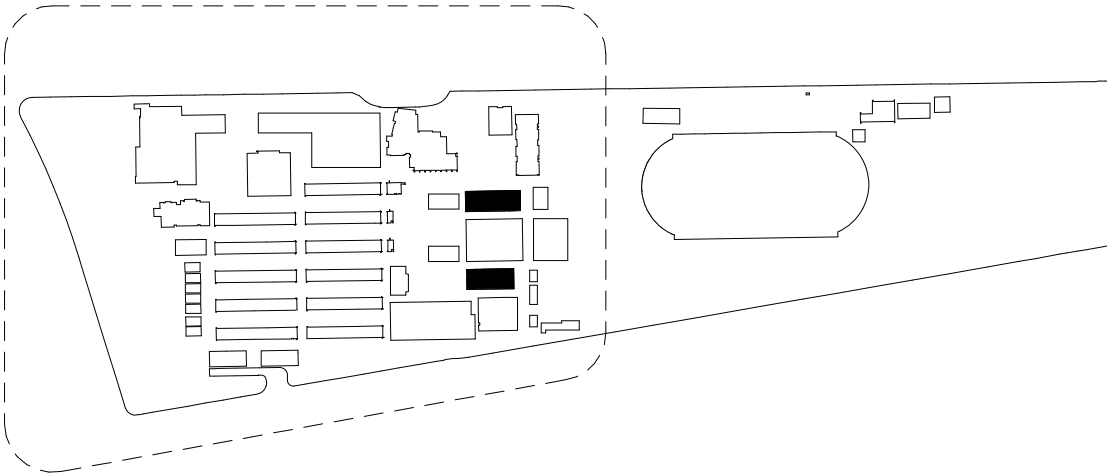


OFFICE
SCALE: 1/4"=1'-0"

GL-2


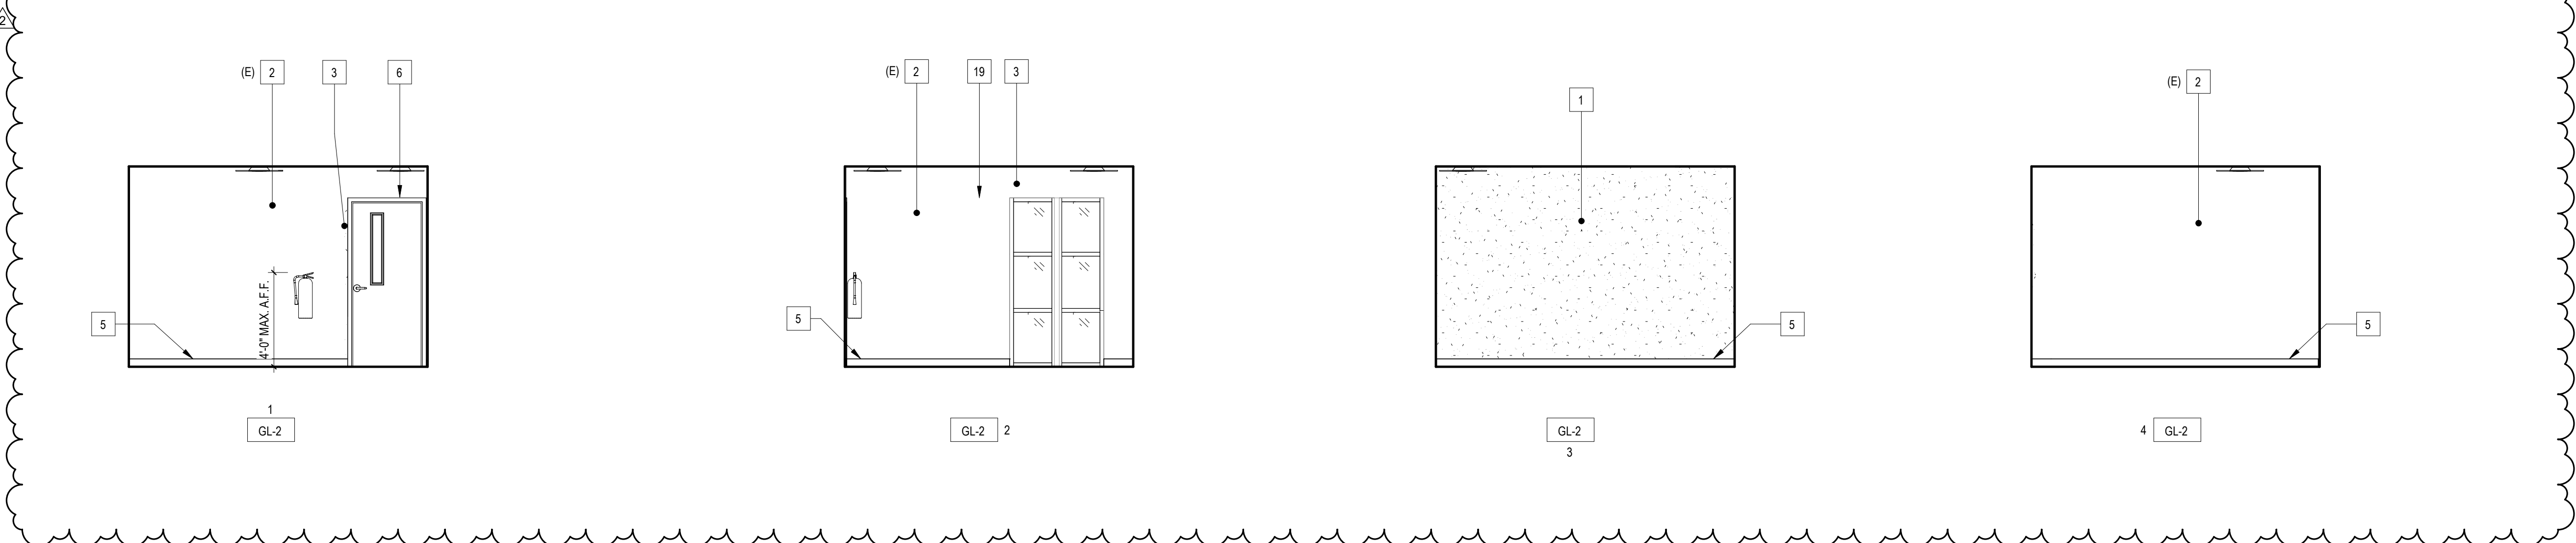


OFFICE
SCALE: 1/4"=1'-0"

GL-3


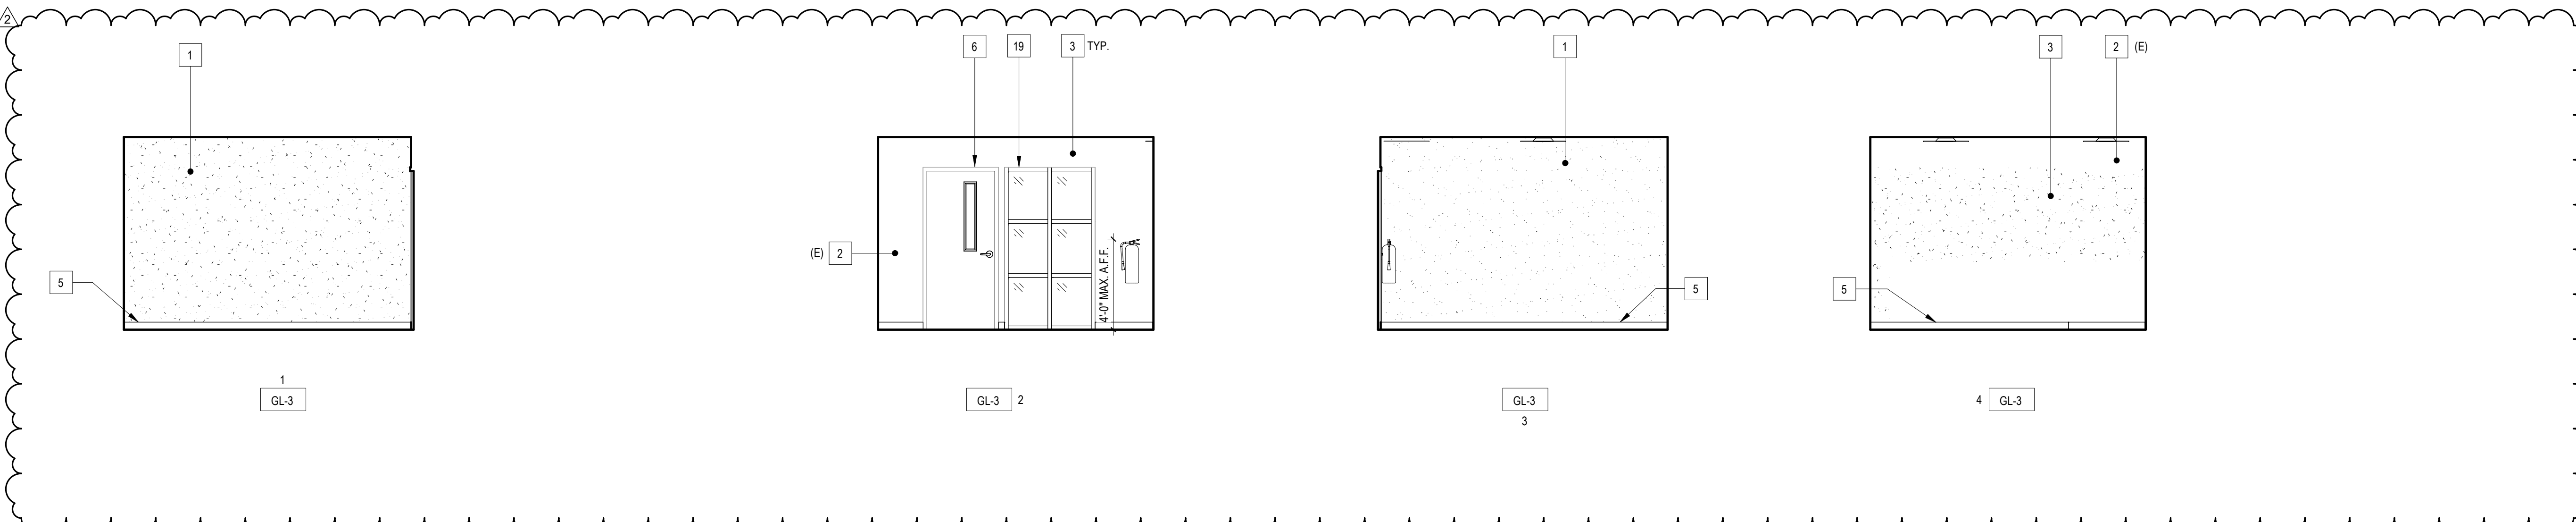


F:\Users\wvorn\BPA\Documents\A95_Archie\A95_Archie.dwg, P:\Users\wvorn\BPA\Documents\A95_Archie.dwg, P:\Users\wvorn\BPA\Documents\A95_Archie.dwg

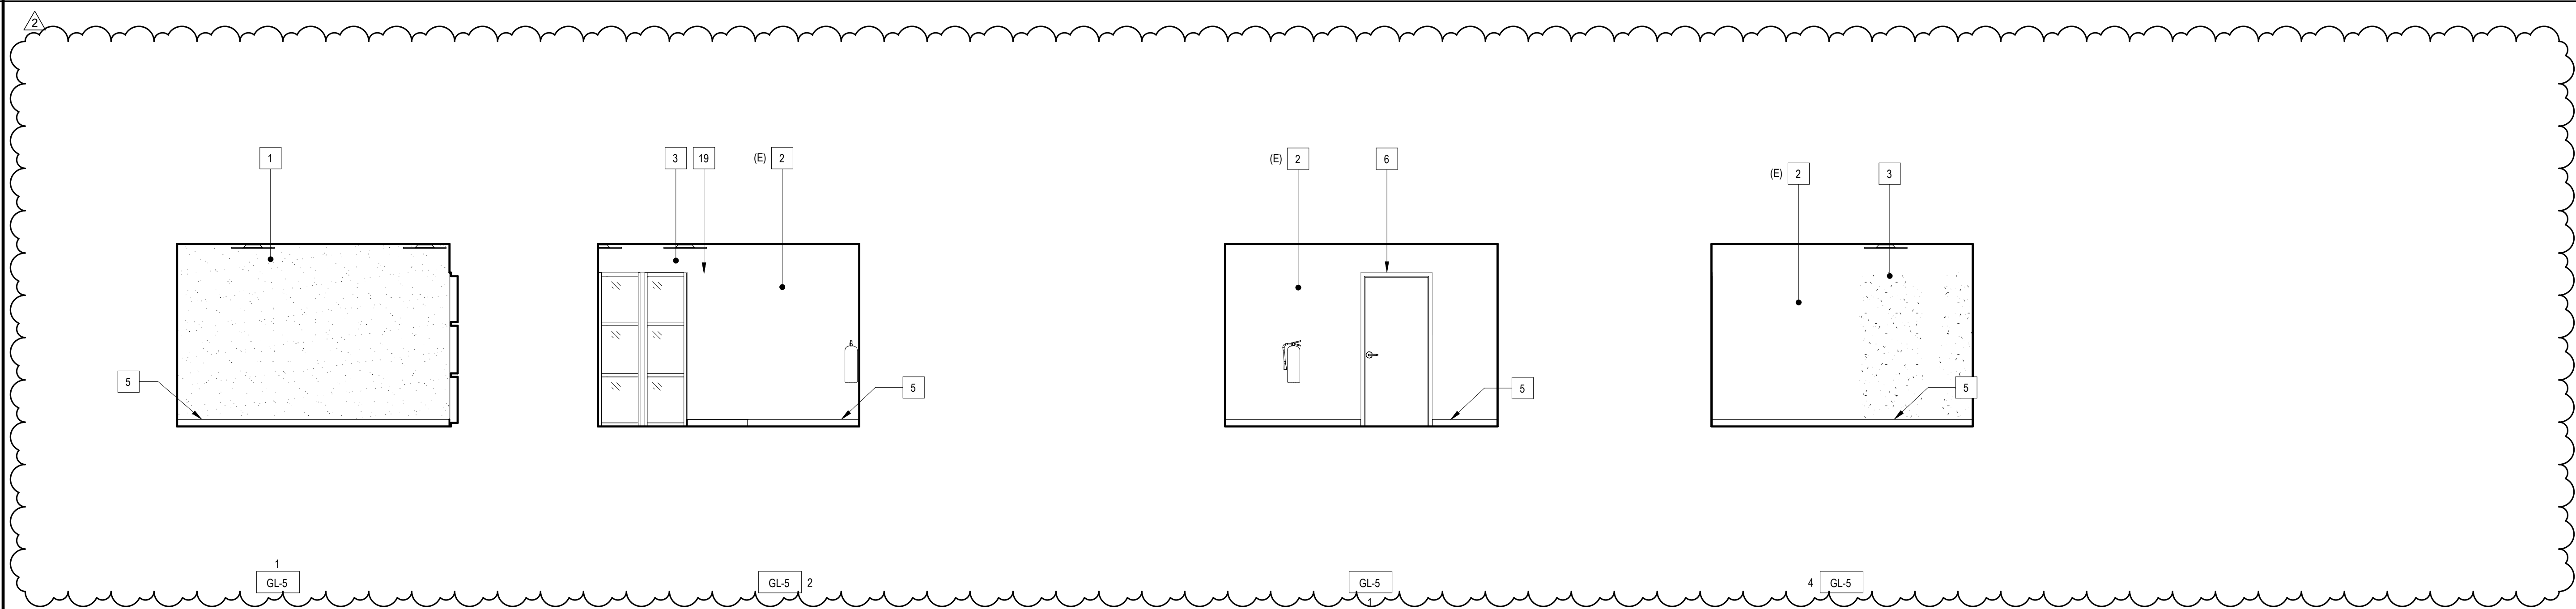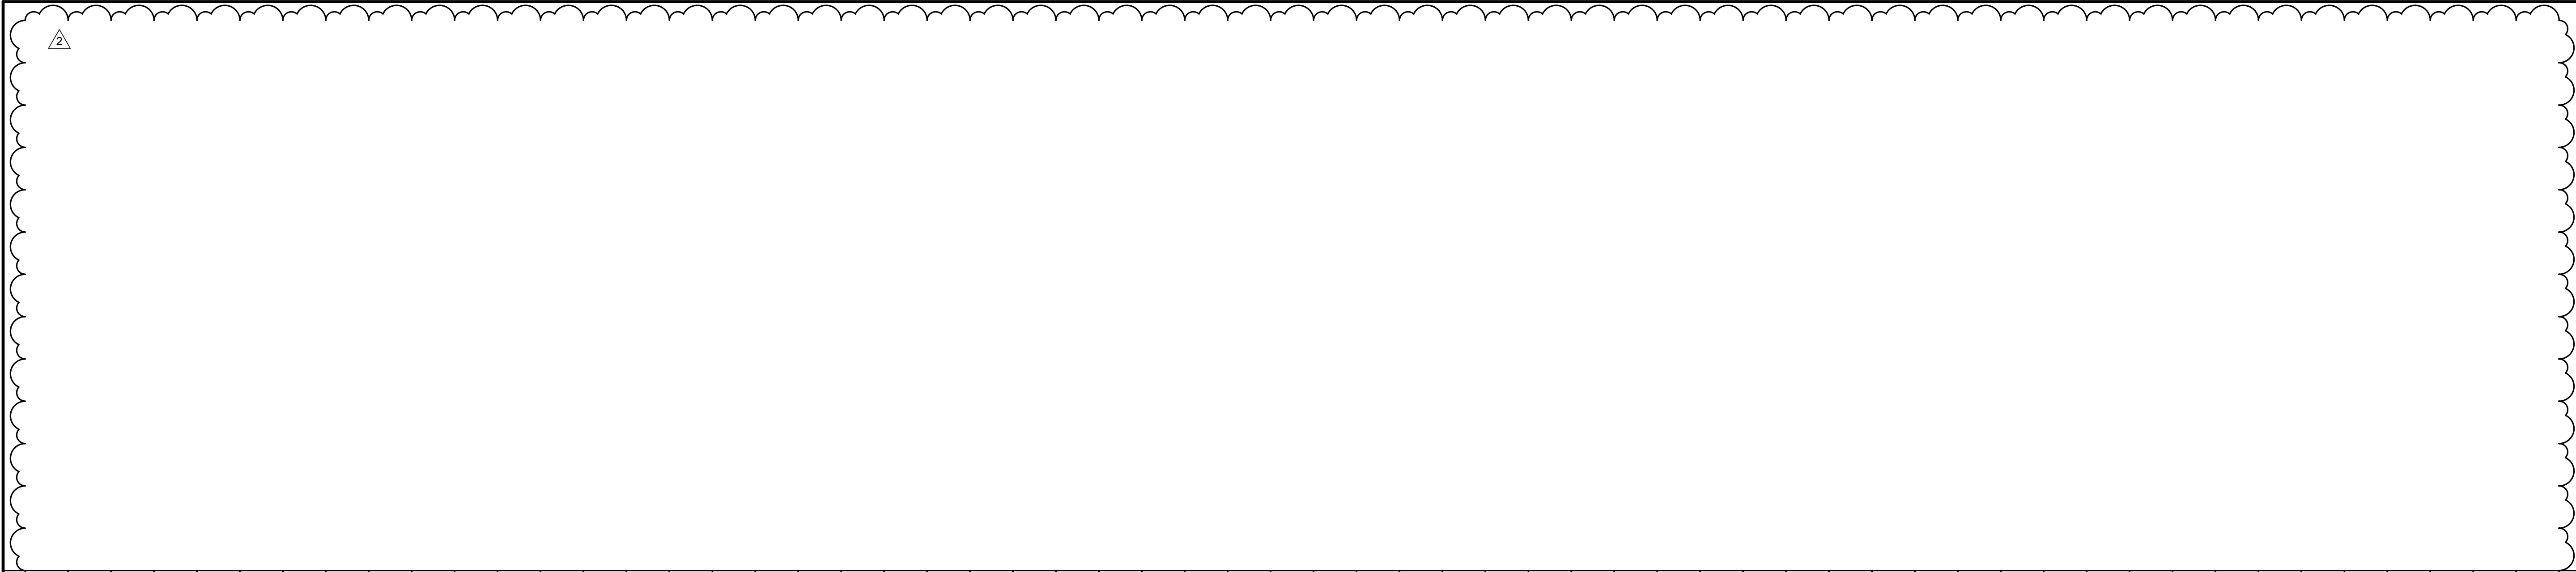


OFFICE
SCALE: 1/4"=1'-0"

GL-5

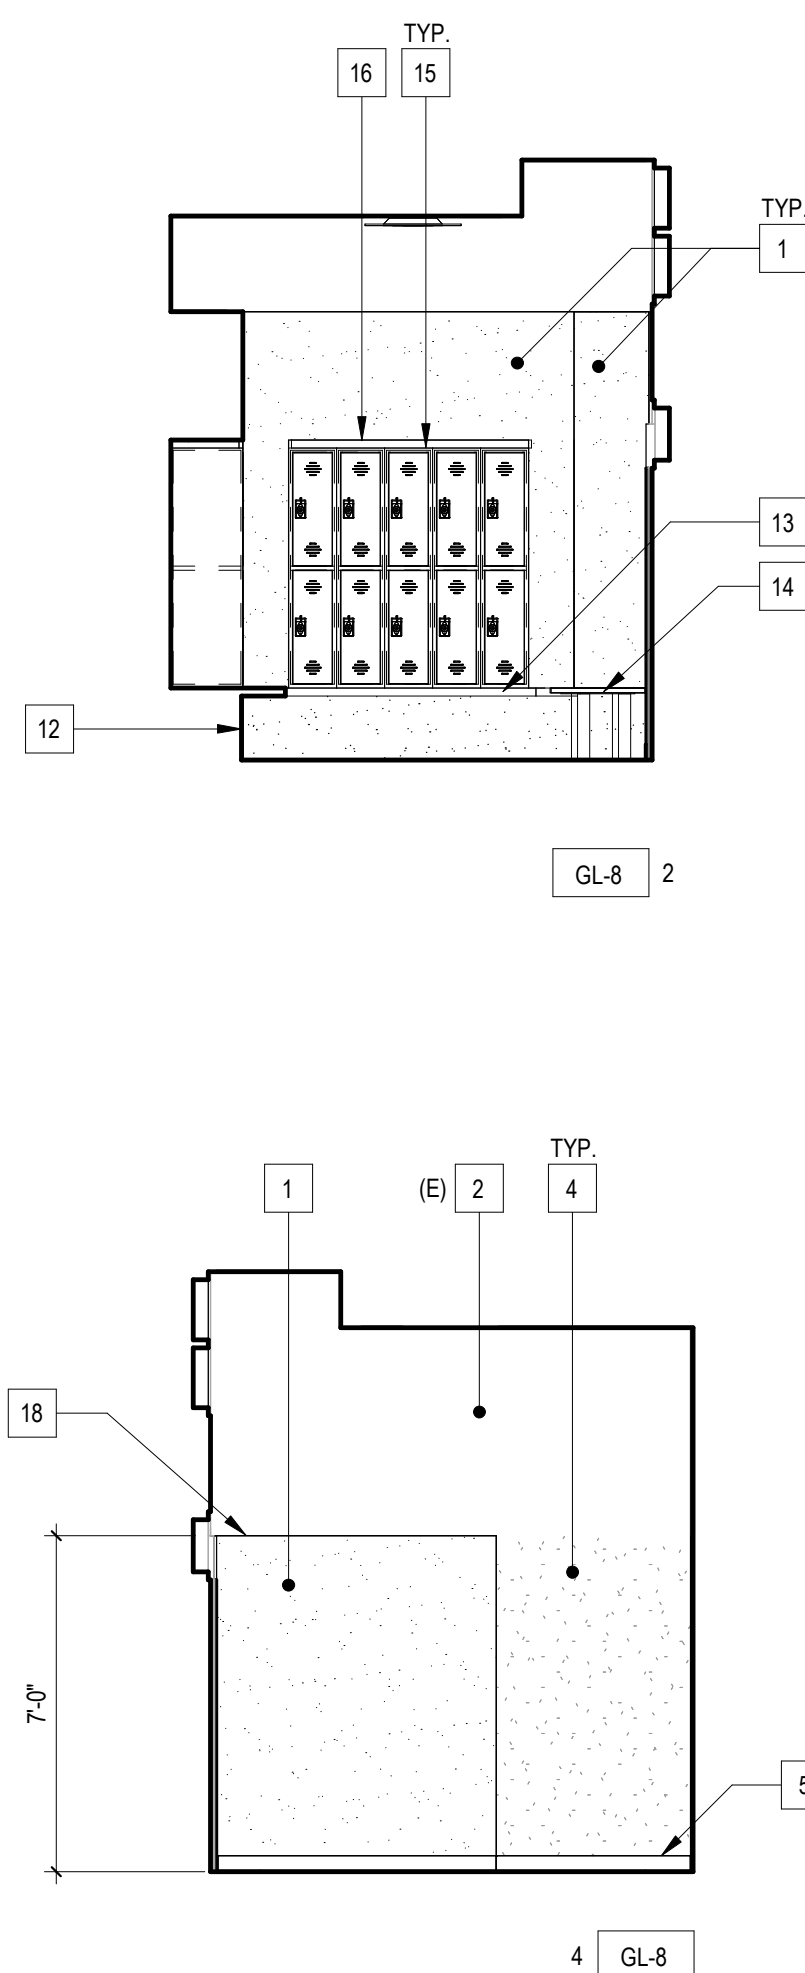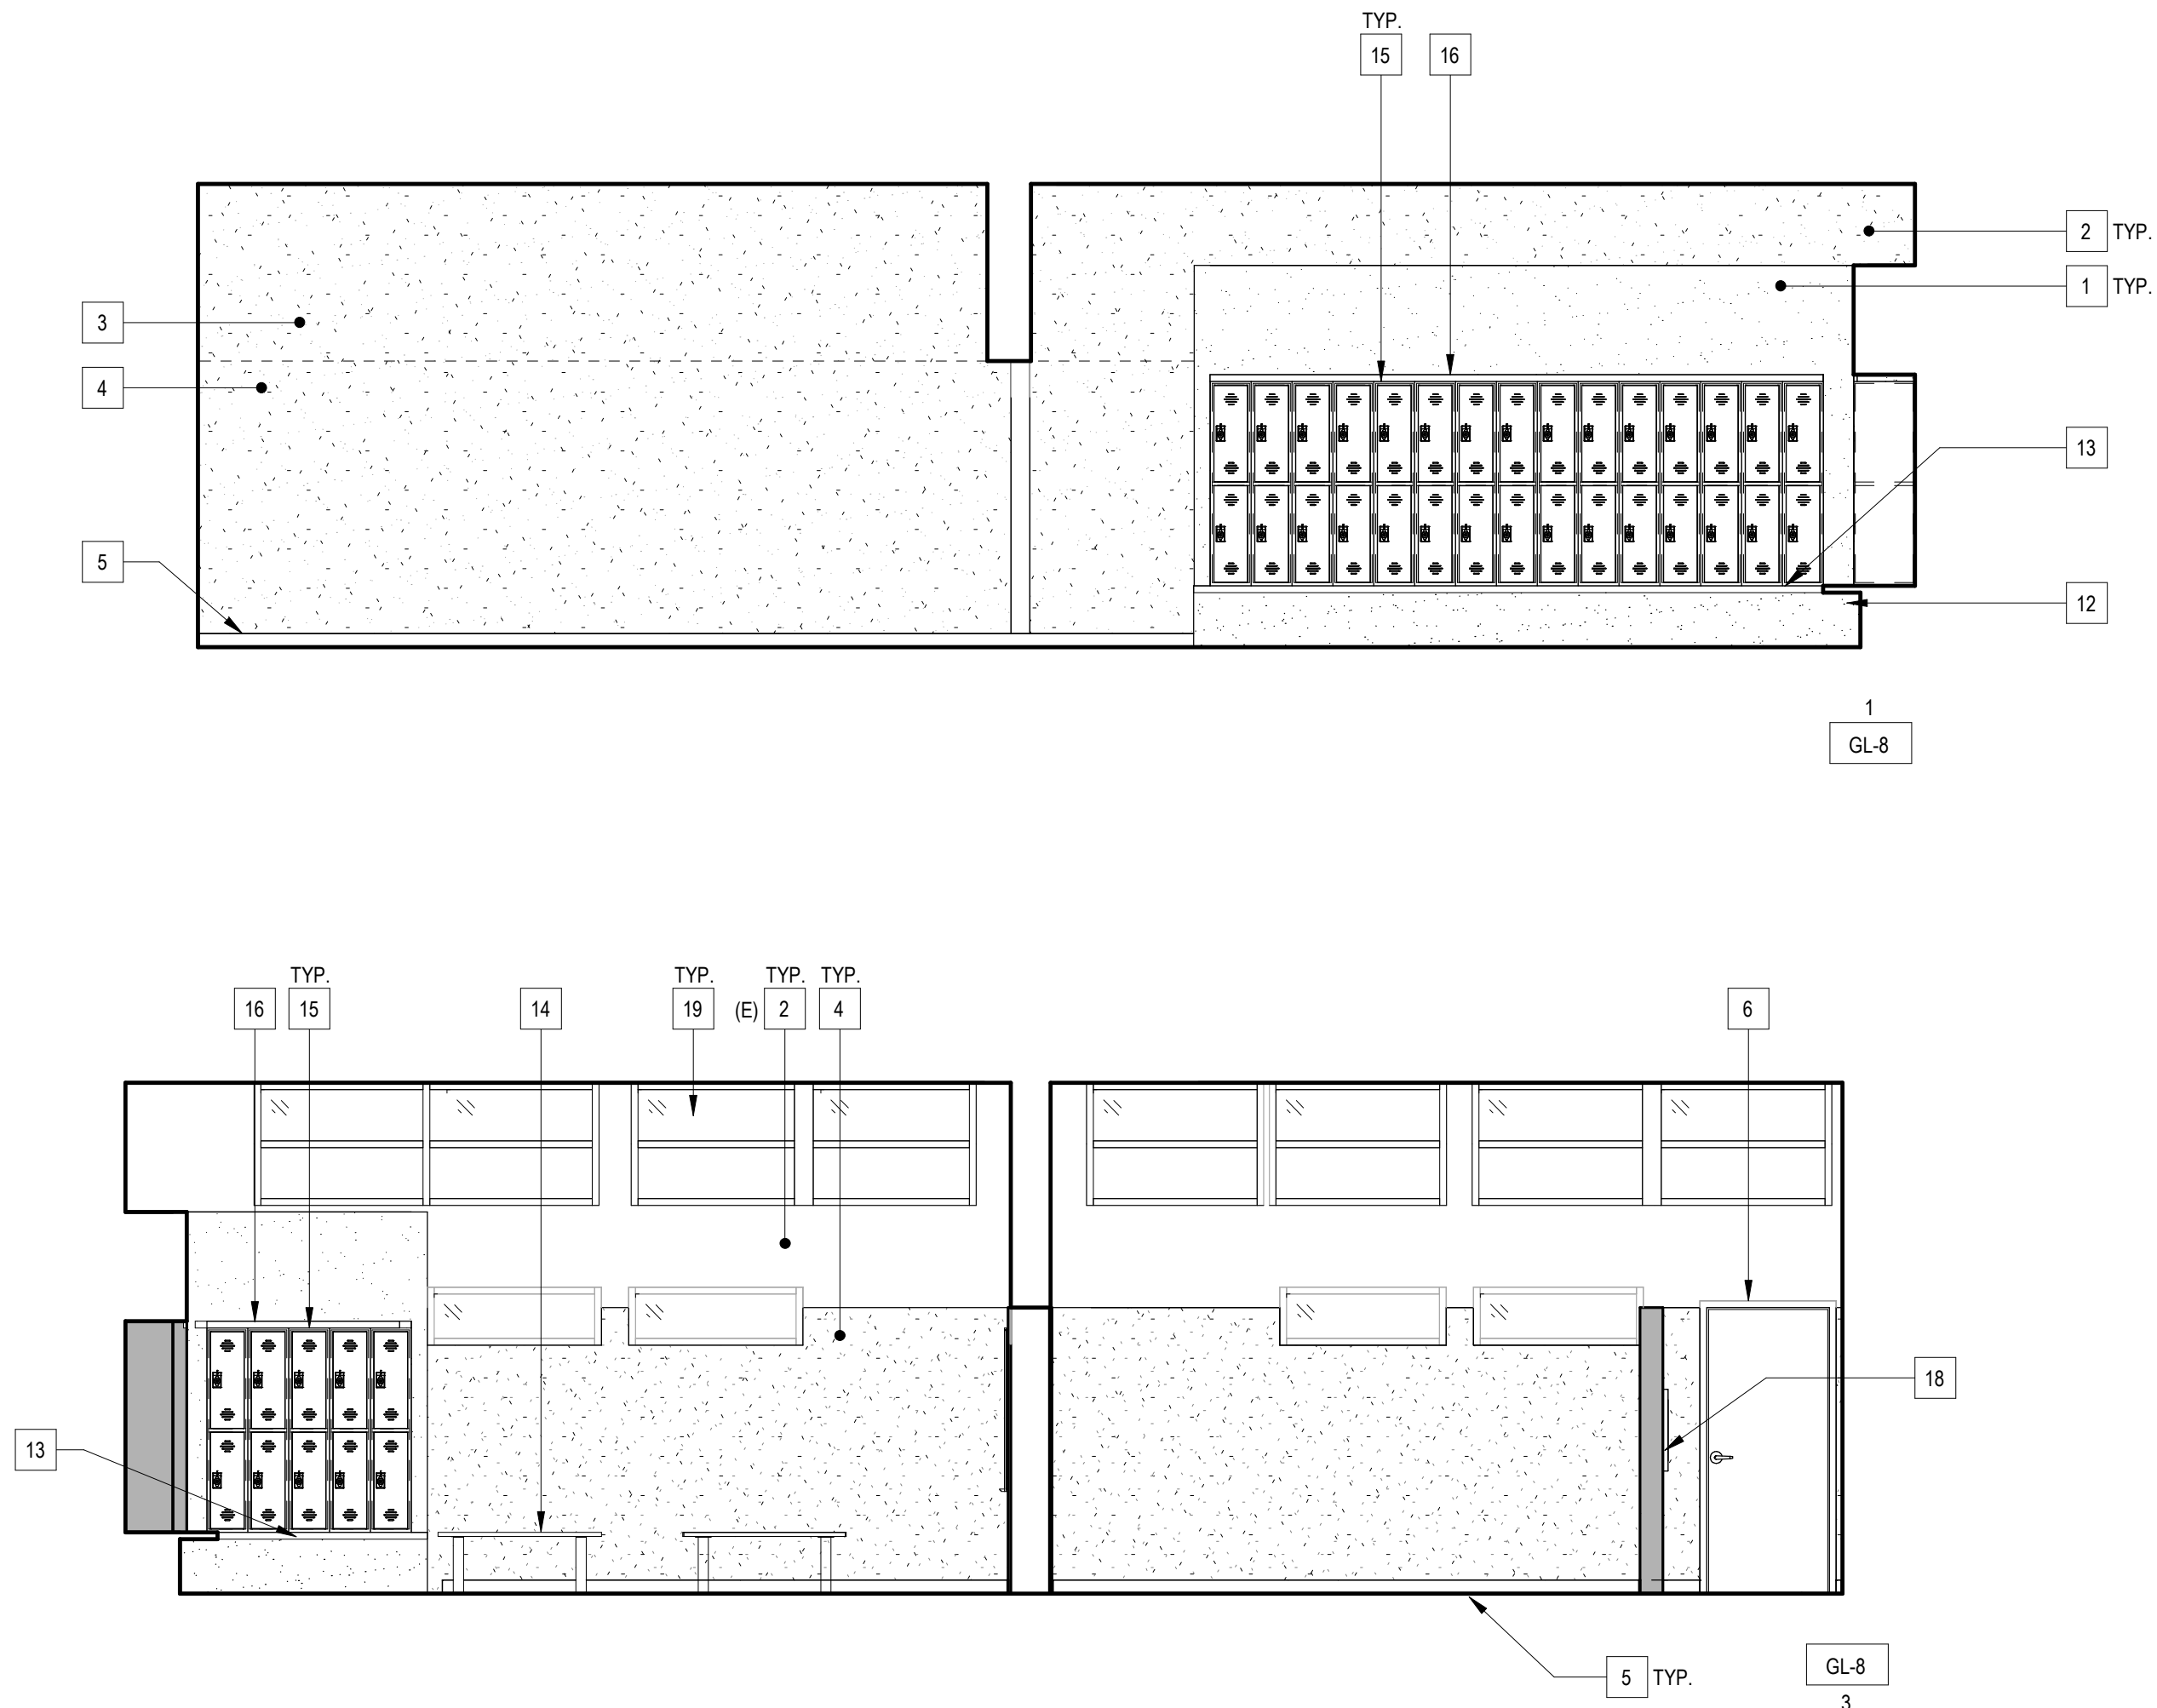

KEYPLAN

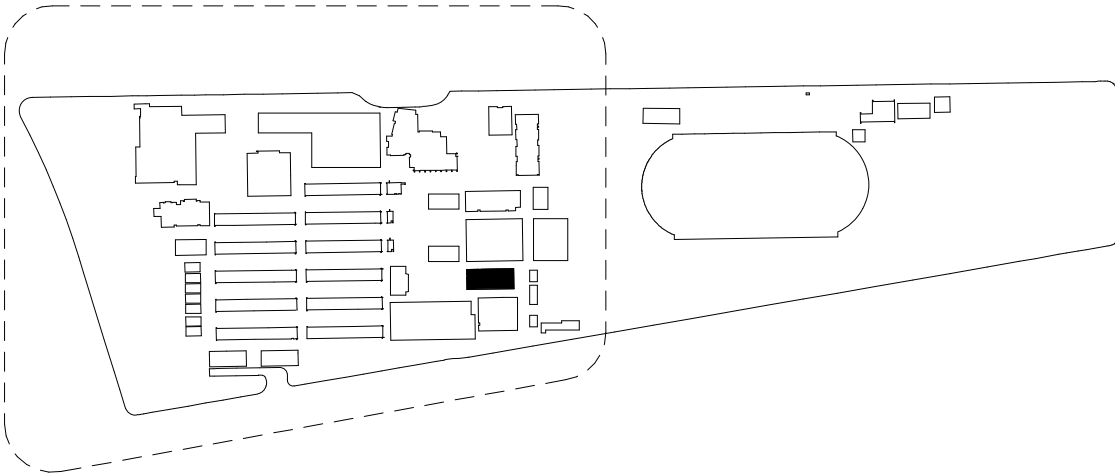

TEAM RM.1
SCALE: 1/4"=1'-0"



GL-8

REMODEL KEY NOTES

- ← # DESCRIPTION:
- 1 GYP. BOARD
 - 2 INTERIOR PLASTER
 - 3 INFILL (E) OPENING WITH FRAMED WALL PER PLAN. FINISH TO MATCH ADJACENT SURFACE
 - 4 FINISH AT (E) WOOD STUD WALL. MATCH AND PROVIDE SMOOTH TRANSITION TO ADJACENT SURFACE
 - 5 RESILIENT BASE
 - 6 HOLLOW METAL DOOR AND FRAME, PER SCHEDULE
 - 7 CASEWORK. SEE DETAIL. 4 / 6.01
 - 8 COUNTERTOP
 - 9 COUNTERTOP AND BACKSPLASH
 - 10 FLIP-UP COUNTERTOP
 - 12 LOCKER BASE. SEE DETAIL. 10 / 6.02
 - 13 WALL MOUNTED BENCH WITH SOLID PLASTIC TOP. SEE DETAIL. 12 / 6.02
 - 14 24"x48" ACCESSIBLE PEDESTAL BENCH WITH SOLID PLASTIC TOP. SEE DETAIL. 14 / 6.02
 - 15 12"x16"x60" 2-TIER PLASTIC LOCKERS. SEE DETAIL. 10 / 6.02
 - 16 LOCKER CLOSURE PANEL
 - 17 MARKER BOARD, FOR MOUNTING. SEE DETAIL. 16 / 6.01
 - 18 PARTIAL HEIGHT WALL. SEE DETAIL. 20 / 4.01
 - 19 WINDOW, PER WINDOW SCHEDULE
 - 20 INFILL OPENING WITH WOOD FILLER PANEL
 - 21 AIR REGISTER, SEE MECHANICAL PLAN SHEET M2-1
 - 22 FROSTED GLAZING, PER WINDOW SCHEDULE. (E) WINDOW, FRAME, AND TRIM TO REMAIN.
 - 23 (E) 10' TO REMAIN. PROTECT IN PLACE
 - 24 12"x12"x22" 2-TIER PLASTIC LOCKERS, MOUNT TO (E) CONCRETE CURB. SEE DETAIL. 7 / 6.01
 - 25 WOOD WAINSCOT
 - 26 SOLID PLASTIC PARTITION. SEE DETAIL. 19 / 6.01
 - 27 24"x48" ACCESSIBLE FOLDING BENCH. SEE DETAIL. 20 / 6.02
 - 28 (E) WALL MOUNTED EQUIPMENT AND CONDUIT TO REMAIN. PROTECT IN PLACE
 - 29 18" HIGH PEDESTAL BENCH WITH SOLID PLASTIC TOP. SEE DETAIL. 17 / 6.02
 - 30 AIR DUCT, SEE MECHANICAL PLAN, SHEET M2-1
 - 33 (E) WALL MOUNTED EQUIPMENT AND CONDUIT TO REMAIN. TEMPORARILY DISMOUNT DURING DEMOLITION AS NEEDED AND REMOUNT AT (E) LOCATION.
 - 34 RELOCATE (E) SWITCH, DEVICE BOX, AND SURFACE MOUNTED CONDUIT
 - 35 REMOVE (E) ELECTRICAL DEVICES AND ASSOCIATED CONDUITS
 - 36 (E) 10' TO REMAIN. PROTECT IN PLACE
 - 37 DESK, O.F.C.I.
 - 38 REFRIGERATOR, O.F.O.I.
 - 39 ACCESSIBLE SHOWER FIXTURE
 - 40 25.5" WIDE ACCESSIBLE FOLDING SHOWER BENCH
 - 41 TERRAZZO
 - 45 (E) WINDOW TO REMAIN
 - 46 TERRAZZO EPOXY WALL BASE

DIVISION OF THE STATE ARCHITECT
355 S. GRAND AVE, SUITE 2100
LOS ANGELES, CA 90071
ph: 213.897.3995 fx: 213.897.3159/0726
DSA Application # 03-123759
DSA File # 19-H32

agency

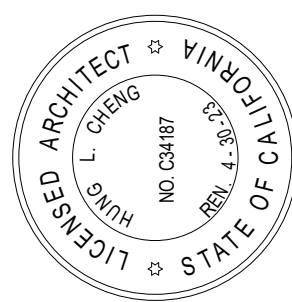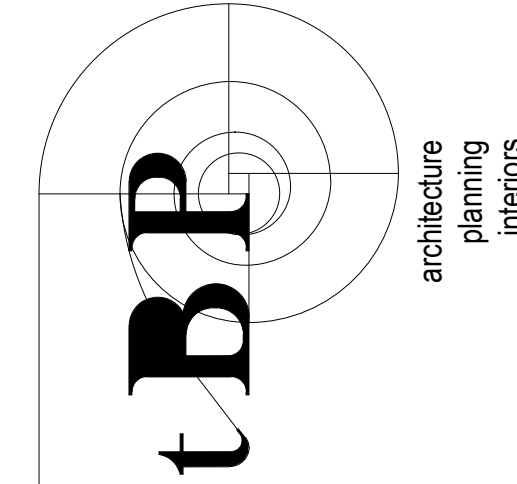

tBP/architecture
4611 Teller Avenue
Newport Beach, CA 92660
ph: 949.673.0300 fx: 949.732.3895

architect

consultant

ARCADIA HIGH SCHOOL LOCKER ROOM ALTERATION

180 CAMPUS DR.
ARCADIA, CA 91006

ARCADIA UNIFIED SCHOOL DISTRICT

owner

tBP project number: 21110.00

file name:

drawn by: Author checked by: Checker

date: 12/20/2023

rev: 2 date: 03/17/25 description: ADDENDUM 2

THIS DRAWING AND THE DESIGN, DEPICTIONS, IDEAS AND OTHER INFORMATION CONTAINED HEREIN CONSTITUTE UNPUBLISHED WORK OF ARCHITECTURE, AND SHALL REMAIN PROPERTY OF ARCHITECTURE IN PERPETUITY. NO PART THEREOF SHALL BE REPRODUCED, DISCLOSED, DISTRIBUTED, SOLD, PUBLISHED OR OTHERWISE USED IN ANY MANNER WITHOUT THE ADVANCED EXPRESS WRITTEN CONSENT OF ARCHITECTURE.


drawing title:
INTERIOR ELEVATION

drawing no.:

A9-5



C:\Users\moria\BPA\Documents\A9- Alter of Facilities - P\Lockers - Central - interior\RC0303.vrt

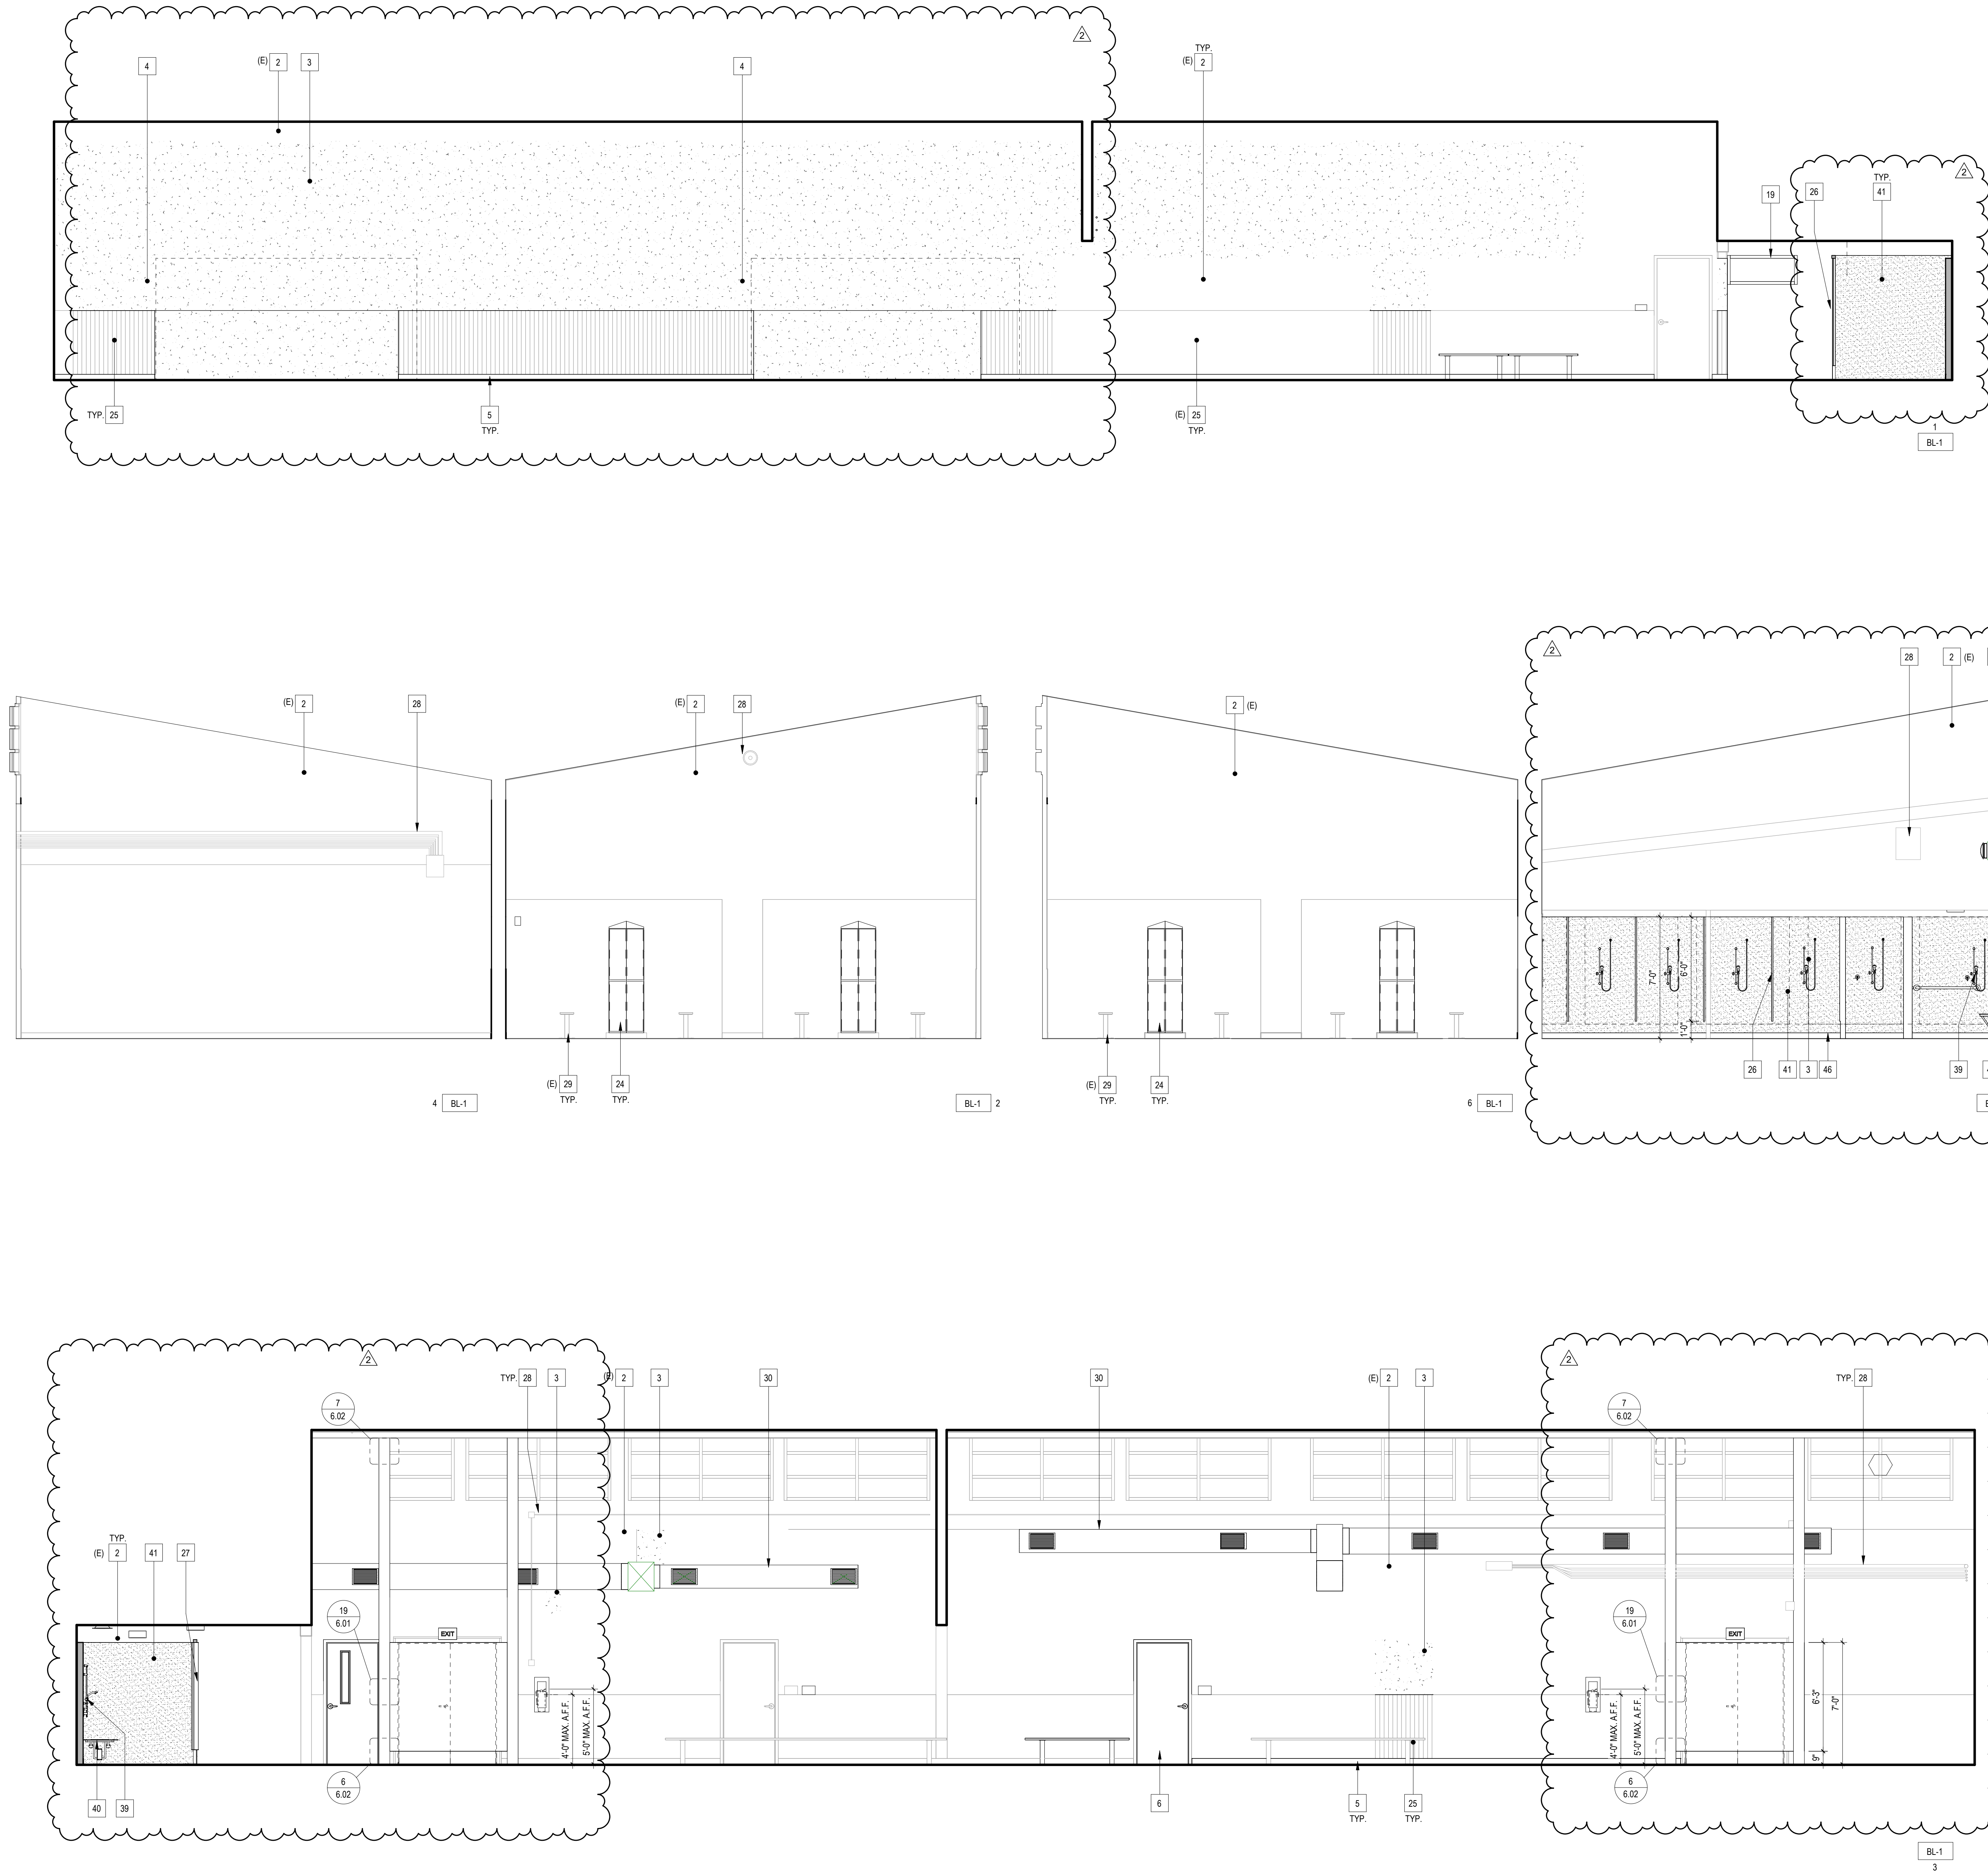


LOCKER ROOM
SCALE: 1/4"=1'-0"

BL-1

REMODEL KEY NOTES



- ← # DESCRIPTION:
- 1 GYP. BOARD
 - 2 INTERIOR PLASTER
 - 3 INFILL (E) OPENING WITH FRAMED WALL PER PLAN. FINISH TO MATCH ADJACENT SURFACE
 - 4 FINISH AT (E) WOOD STUD WALL. MATCH AND PROVIDE SMOOTH TRANSITION TO ADJACENT SURFACE
 - 5 RESILIENT BASE
 - 6 HOLLOW METAL DOOR AND FRAME, PER SCHEDULE
 - 7 CASEWORK. SEE DETAIL. 4 / 6.01
 - 8 COUNTERTOP
 - 9 COUNTERTOP AND BACKSPLASH
 - 10 FLIP-UP COUNTERTOP
 - 12 LOCKER BASE. SEE DETAIL. 10 / 6.02
 - 13 WALL MOUNTED BENCH WITH SOLID PLASTIC TOP. SEE DETAIL. 12 / 6.02
 - 14 24"x48" ACCESSIBLE PEDESTAL BENCH WITH SOLID PLASTIC TOP. SEE DETAIL. 14 / 6.02
 - 15 12"x16"x6" 2-TIER PLASTIC LOCKERS. SEE DETAIL. 10 / 6.02
 - 16 LOCKER CLOSURE PANEL
 - 17 MARKER BOARD, FOR MOUNTING. SEE DETAIL. 16 / 6.01
 - 18 PARTIAL HEIGHT WALL. SEE DETAIL. 20 / 4.01
 - 19 WINDOW, PER WINDOW SCHEDULE
 - 20 INFILL OPENING WITH WOOD FILLER PANEL
 - 21 AIR REGISTER, SEE MECHANICAL PLAN SHEET M2-1
 - 22 FROSTED GLAZING, PER WINDOW SCHEDULE. (E) WINDOW, FRAME, AND TRIM TO REMAIN.
 - 23 (E) TOP TO REMAIN. PROTECT IN PLACE
 - 24 12"x12"x22 2-TIER PLASTIC LOCKERS, MOUNT TO (E) CONCRETE CURB. SEE DETAIL. 7 / 6.01
 - 25 WOOD WAINSCOT
 - 26 SOLID PLASTIC PARTITION. SEE DETAIL. 19 / 6.01
 - 27 24"x48" ACCESSIBLE FOLDING BENCH. SEE DETAIL. 20 / 6.02
 - 28 (E) WALL MOUNTED EQUIPMENT AND CONDUIT TO REMAIN. PROTECT IN PLACE
 - 29 18" HIGH PEDESTAL BENCH WITH SOLID PLASTIC TOP. SEE DETAIL. 17 / 6.02
 - 30 AIR DUCT, SEE MECHANICAL PLAN, SHEET M2-1
 - 33 (E) WALL MOUNTED EQUIPMENT AND CONDUIT TO REMAIN. TEMPORARILY DISMOUNT DURING DEMOLITION AS NEEDED AND REMOUNT AT (E) LOCATION.
 - 34 RELOCATE (E) SWITCH, DEVICE BOX, AND SURFACE MOUNTED CONDUIT
 - 35 REMOVE (E) ELECTRICAL DEVICES AND ASSOCIATED CONDUITS
 - 36 (E) WALL CLOCK TO REMAIN. PROTECT IN PLACE
 - 37 REFRIGERATOR, O.F.O.I.
 - 38 REFRIGERATOR, O.F.O.I.
 - 39 ACCESSIBLE SHOWER FIXTURE
 - 40 25.5" WIDE ACCESSIBLE FOLDING SHOWER BENCH
 - 41 TERRAZZO
 - 45 (E) WINDOW TO REMAIN
 - 46 TERRAZZO EPOXY WALL BASE

KEYPLAN

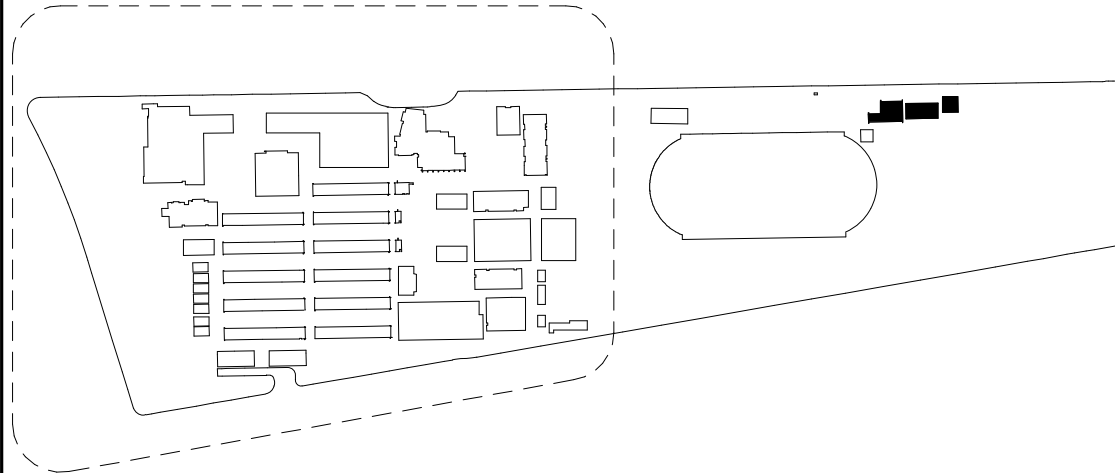

DIVISION OF THE STATE ARCHITECT
355 S. GRAND AVE, SUITE 2100
LOS ANGELES, CA 90071
ph: 213.897.3995 fx: 213.897.3159/0726
DSA Application # 03-123759
DSA File # 19-H32

agency

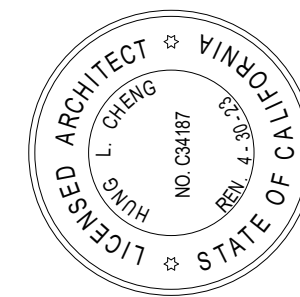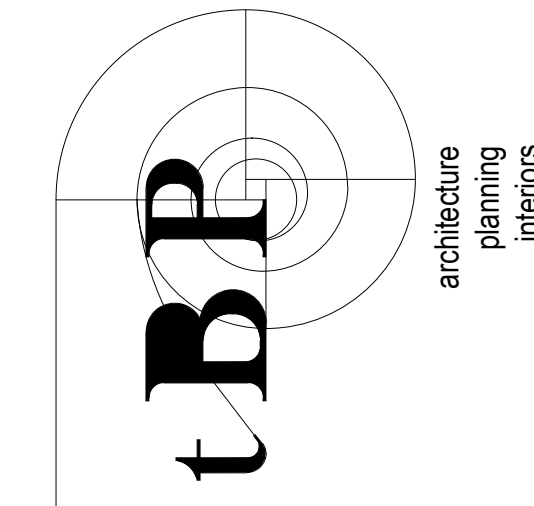

tBP/Architecture
4611 Teller Avenue
Newport Beach, CA 92660
ph: 949.673.0300 fx: 949.732.3895

architect

consultant

ARCADIA HIGH SCHOOL LOCKER ROOM ALTERATION

180 CAMPUS DR.
ARCADIA, CA 91006

ARCADIA UNIFIED SCHOOL DISTRICT

owner

tBP project number: 21110.00

file name:

drawn by: Author

checked by: Checker

date: 12/20/2023

rev: 2 date: 03/17/25 description: ADDENDUM 2

THIS DRAWING AND THE DESIGN, DEPICTIONS, IDEAS AND OTHER INFORMATION CONTAINED HEREIN CONSTITUTE UNPUBLISHED WORK OF ARCHITECTURE, AND SHALL REMAIN PROPERTY OF ARCHITECTURE IN PERPETUITY. NO PART THEREOF SHALL BE REPRODUCED, DISCLOSED, DISTRIBUTED, SOLD, PUBLISHED OR OTHERWISE USED IN ANY MANNER WITHOUT THE ADVANCED EXPRESS WRITTEN CONSENT OF ARCHITECTURE.

drawing title:
INTERIOR ELEVATION

drawing no.:



A9-8

REMODEL KEY NOTES

- 1 GYP. BOARD
2 INTERIOR PLASTER
3 INFILL (E) OPENING WITH FRAMED WALL PER PLAN. FINISH TO MATCH ADJACENT SURFACE
4 FINISH AT (E) WOOD STUD WALL. MATCH AND PROVIDE SMOOTH TRANSITION TO ADJACENT SURFACE
5 RESILIENT BASE
6 HOLLOW METAL DOOR AND FRAME, PER SCHEDULE
7 CASEWORK. SEE DETAIL. 4 / 6.01
8 COUNTERTOP
9 COUNTERTOP AND BACKSPLASH
10 FLIP-UP COUNTERTOP
12 LOCKER BASE. SEE DETAIL. 10 / 6.02
13 WALL MOUNTED BENCH WITH SOLID PLASTIC TOP. SEE DETAIL. 12 / 6.02
14 24"x48" ACCESSIBLE PEDESTAL BENCH WITH SOLID PLASTIC TOP. SEE DETAIL. 14 / 6.02
15 12"x16"x6" 2-TIER PLASTIC LOCKERS. SEE DETAIL. 10 / 6.02
16 LOCKER CLOSURE PANEL
17 MARKER BOARD, FOR MOUNTING. SEE DETAIL. 16 / 6.01
18 PARTIAL HEIGHT WALL. SEE DETAIL. 20 / 4.01
19 WINDOW, PER WINDOW SCHEDULE
20 INFILL OPENING WITH WOOD FILLER PANEL
21 AIR REGISTER, SEE MECHANICAL PLAN SHEET M2-1
22 FROSTED GLAZING, PER WINDOW SCHEDULE. (E) WINDOW, FRAME, AND TRIM TO REMAIN.
23 (E) TOP TO REMAIN, PROTECT IN PLACE
24 12"x12"x2" 2-TIER PLASTIC LOCKERS, MOUNT TO (E) CONCRETE CURB. SEE DETAIL. 7 / 6.01
25 WOOD WAINSCOT
26 SOLID PLASTIC PARTITION. SEE DETAIL. 19 / 6.01
27 24"x48" ACCESSIBLE FOLDING BENCH. SEE DETAIL. 20 / 6.02
28 (E) WALL MOUNTED EQUIPMENT AND CONDUIT TO REMAIN, PROTECT IN PLACE
29 18" HIGH PEDESTAL BENCH WITH SOLID PLASTIC TOP. SEE DETAIL. 17 / 6.02
30 AIR DUCT, SEE MECHANICAL PLAN, SHEET M2-1
33 (E) WALL MOUNTED EQUIPMENT AND CONDUIT TO REMAIN, TEMPORARILY DISMOUNT DURING DEMOLITION AS NEEDED AND REMOUNT AT (E) LOCATION.
34 RELOCATE (E) SWITCH, DEVICE BOX, AND SURFACE MOUNTED CONDUIT
35 REMOVE (E) ELECTRICAL DEVICES AND ASSOCIATED CONDUITS
36 (E) WALL CLOCK TO REMAIN, PROTECT IN PLACE
37 CESS. PLANT
38 REFRIGERATOR, O.F.O.I.
39 ACCESSIBLE SHOWER FIXTURE
40 25.5" WIDE ACCESSIBLE FOLDING SHOWER BENCH
41 TERRAZZO
45 (E) WINDOW TO REMAIN
46 TERRAZZO EPOXY WALL BASE

DIVISION OF THE STATE ARCHITECT
355 S. GRAND AVE, SUITE 2100
LOS ANGELES, CA 90071
ph: 213.897.3995 fx: 213.897.3159/0726
DSA Application # 03-123759
DSA File # 19-H32

agency

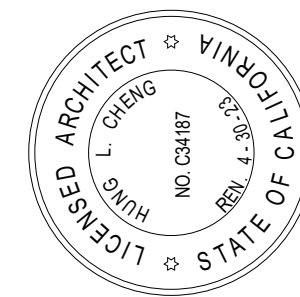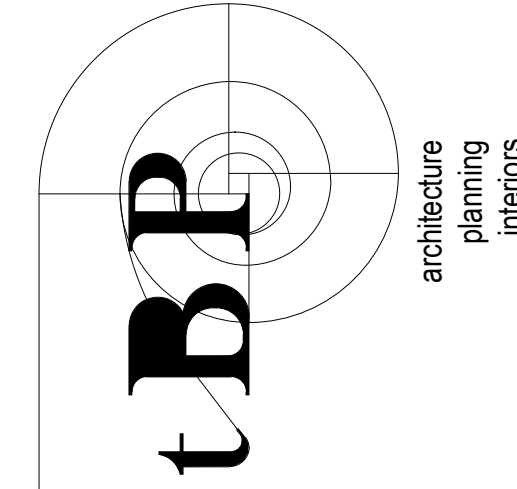

tBP/Architecture
4611 Teller Avenue
Newport Beach, CA 92660
ph: 949.673.0300 fx: 949.732.3895

architect

consultant

ARCADIA HIGH SCHOOL
LOCKER ROOM ALTERATION

180 CAMPUS DR.
ARCADIA, CA 91006

owner

tBP project number: 21110.00

file name:

drawn by: Author checked by: Checker

date: 12/20/2023

rev: 2 date: 03/17/25 description: ADDENDUM 2

THIS DRAWING AND THE DESIGN, DEPICTIONS, IDEAS AND OTHER INFORMATION CONTAINED HEREIN CONSTITUTE UNPUBLISHED WORK OF ARCHITECTURE, AND SHALL REMAIN PROPERTY OF tBP/ARCHITECTURE IN PERPETUITY. NO PART THEREOF SHALL BE REPRODUCED, DISCLOSED, DISTRIBUTED, SOLD, PUBLISHED OR OTHERWISE USED IN ANY MANNER WITHOUT THE ADVANCED EXPRESS WRITTEN CONSENT OF tBP/ARCHITECTURE.

drawing title:
INTERIOR ELEVATION


drawing no.:


A9-9




LOCKER ROOM
SCALE: 1/4"=1'-0"

GL-1

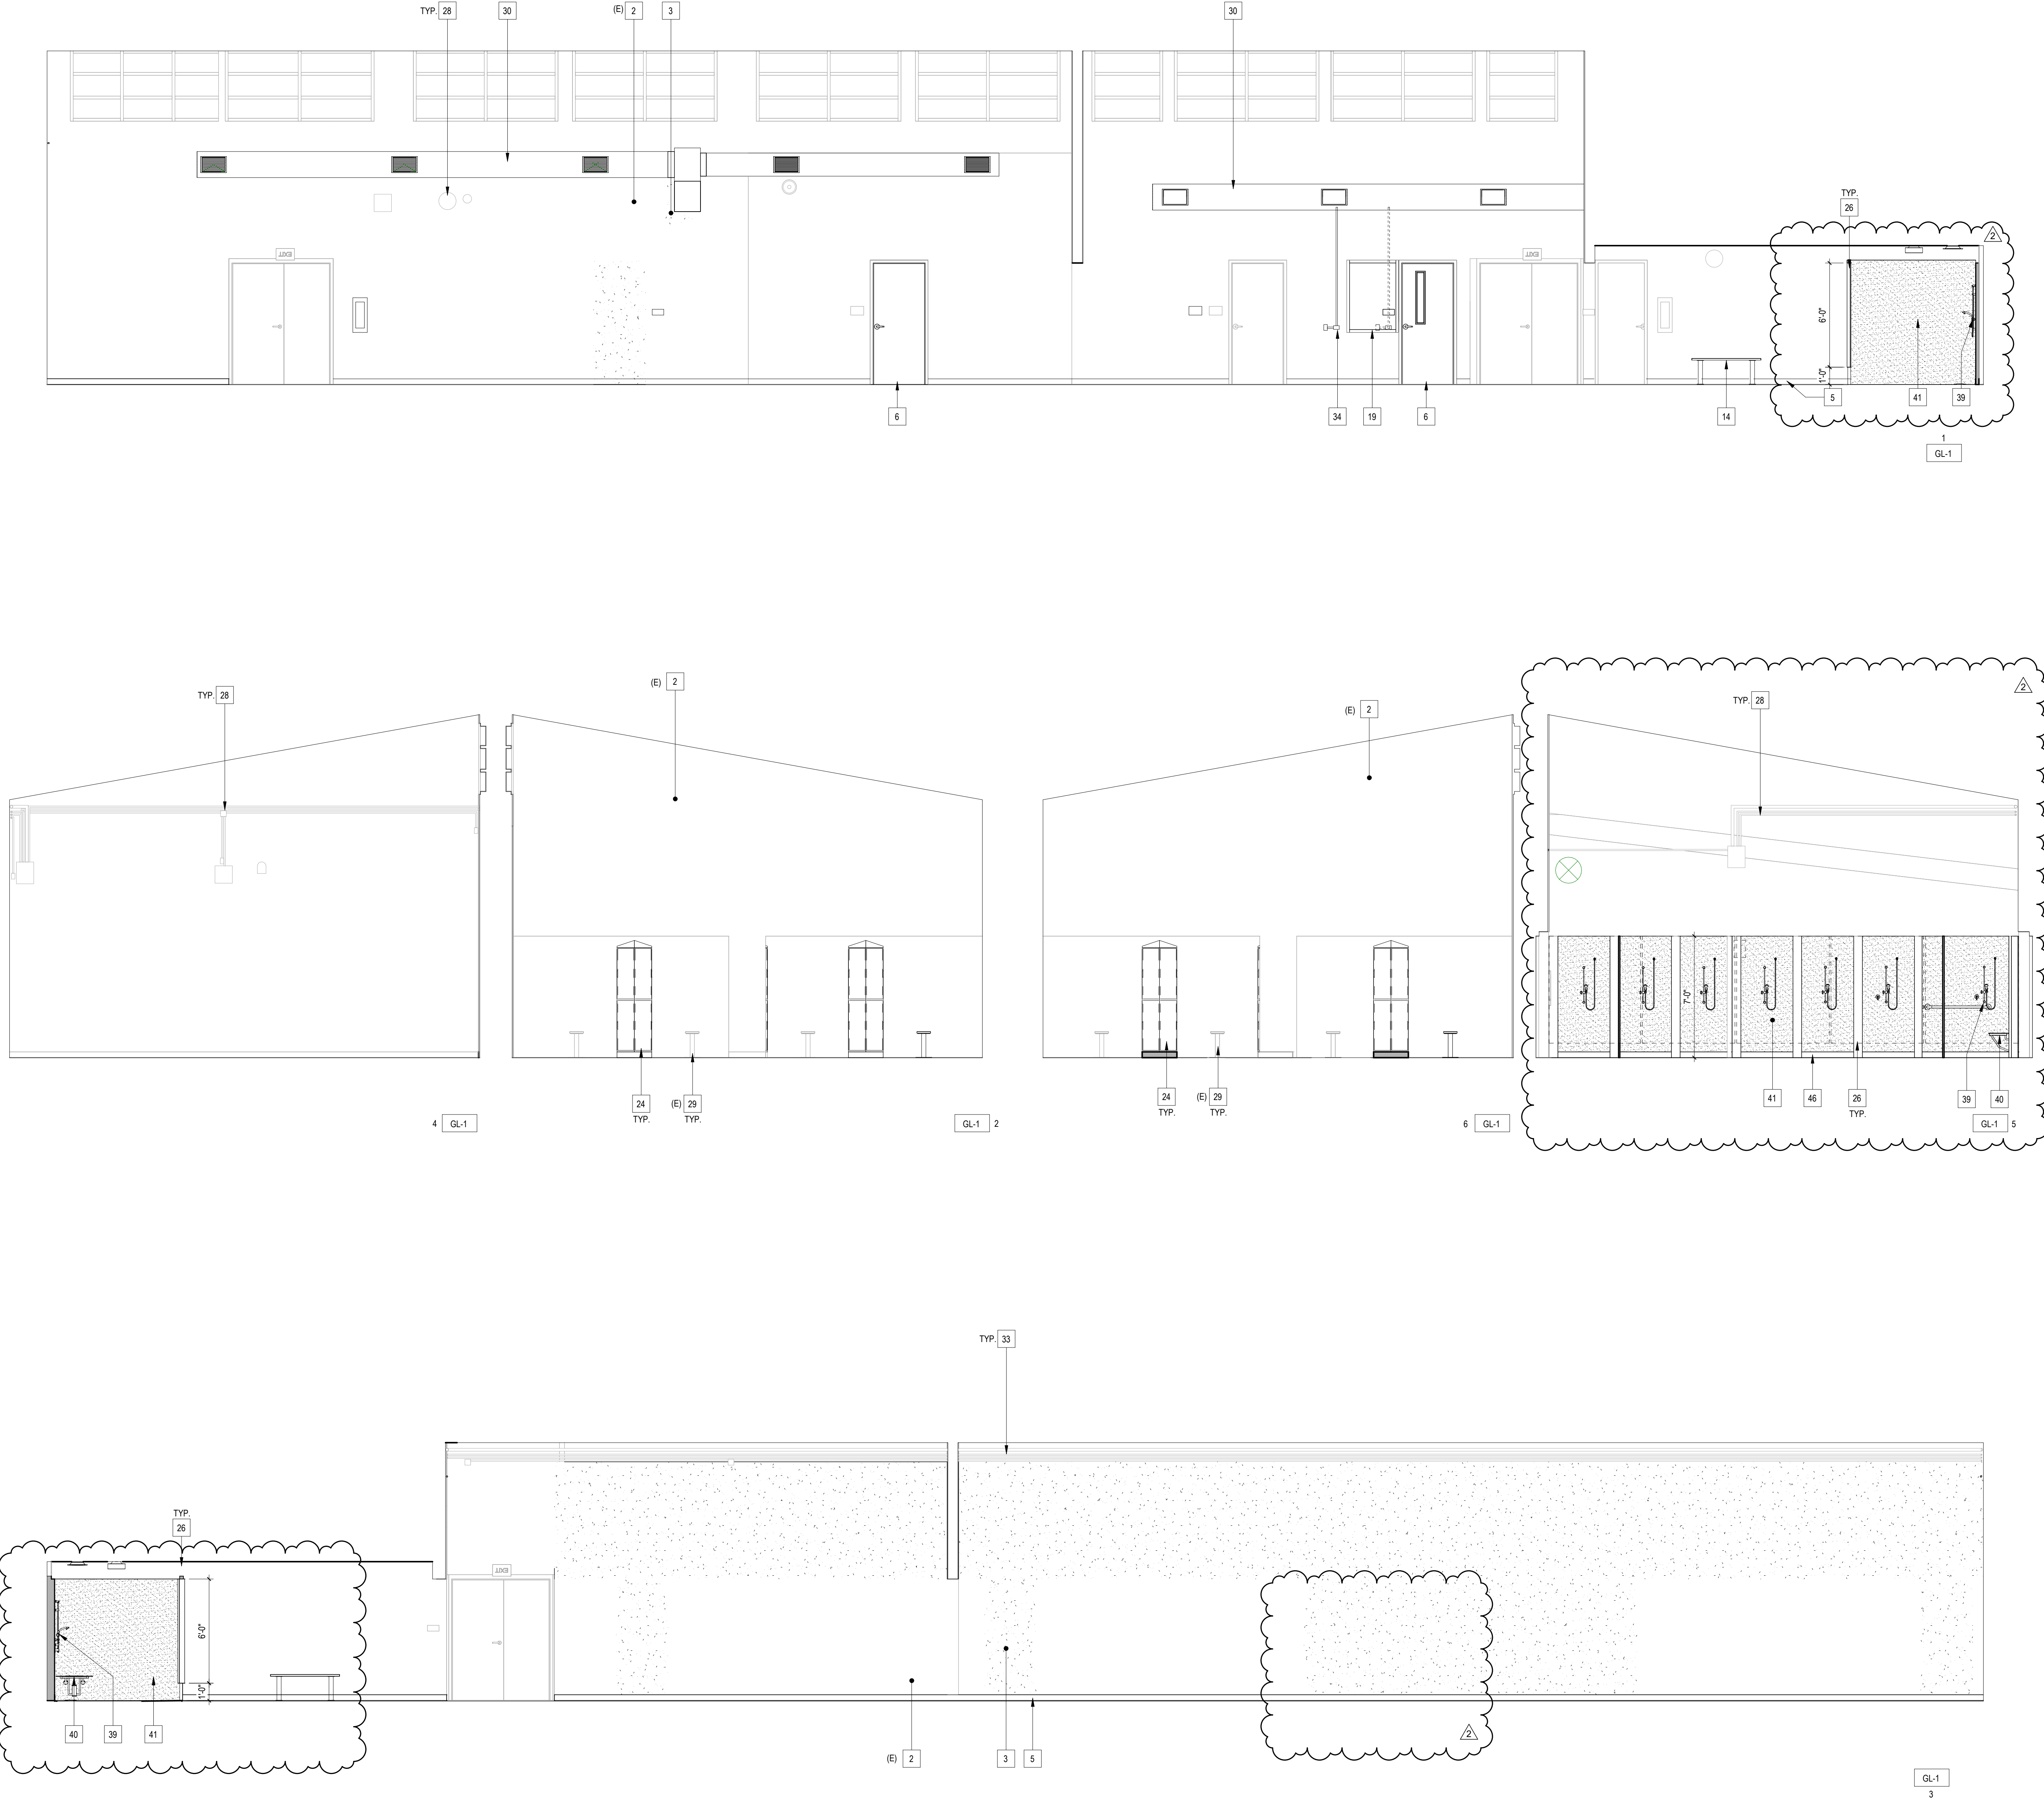

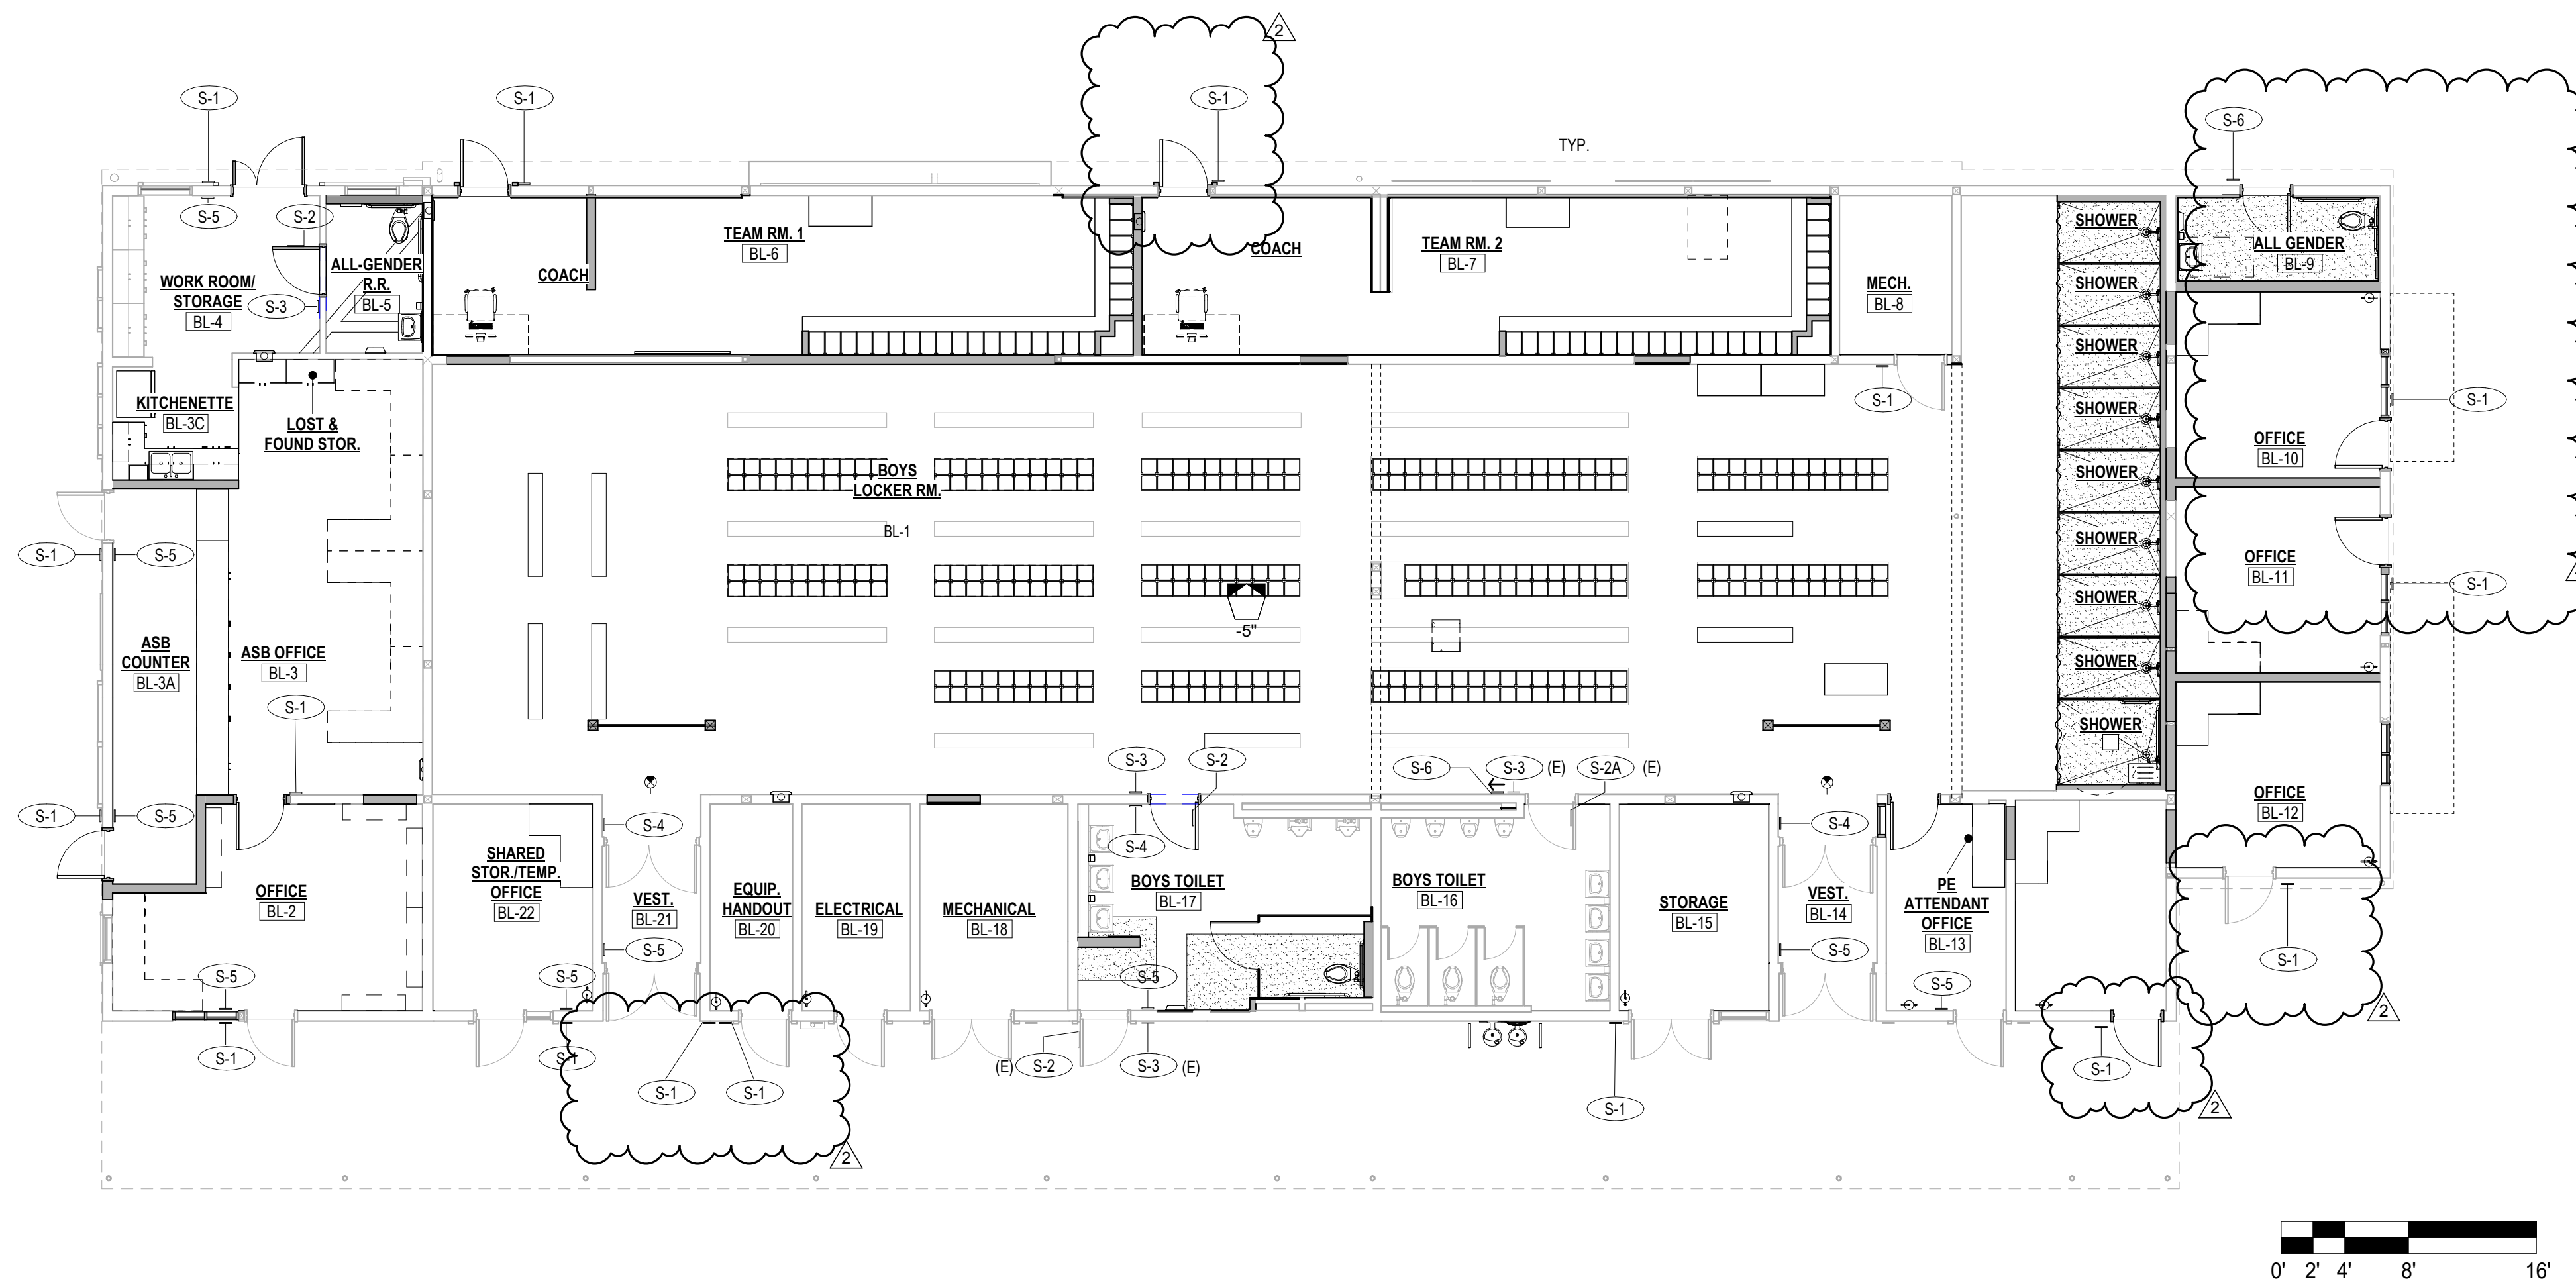

BLDG. BL SIGNAGE PLAN 1
SCALE: 1/8" = 1'-0"

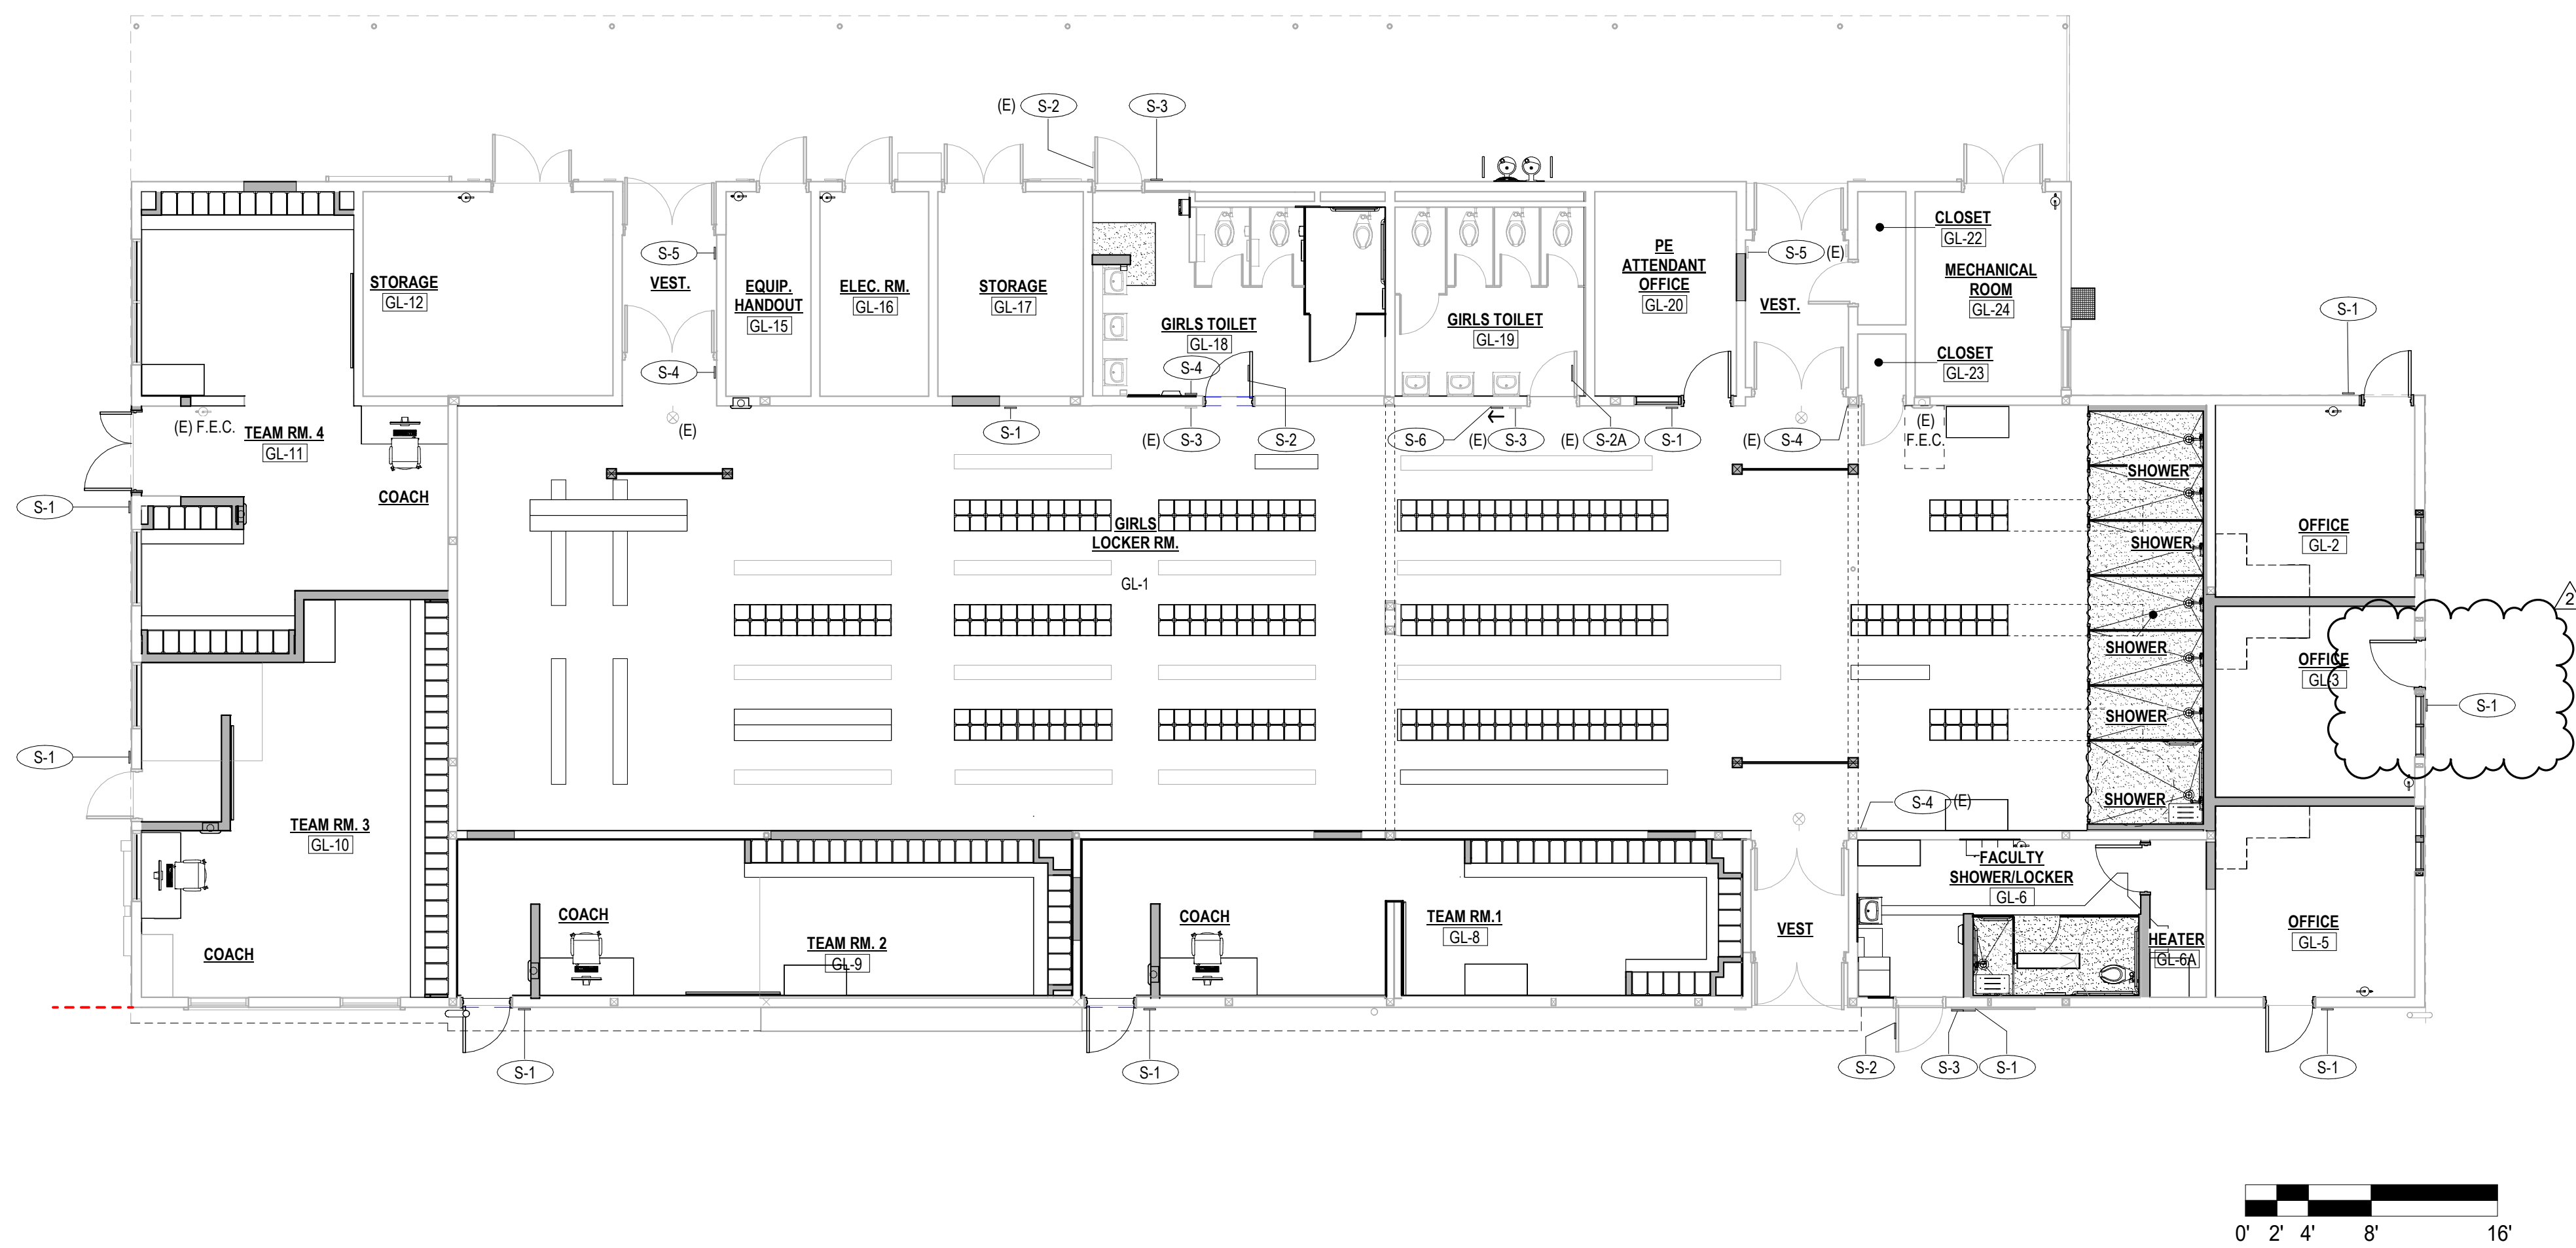


BLDG. GL SIGNAGE PLAN 2
SCALE: 1/8" = 1'-0"



LEGEND



- S-1 ROOM NAME / NUMBER SIGN, SEE DOOR SCHEDULE & 2 10.01
- S-2 TOILET ROOM DOOR SIGN, SEE 16 10.01
- S-2A TOILET ROOM DOOR SIGN, SEE SIMILAR DETAIL. OMIT ISA AT NON-ACCESSIBLE TOILET ROOM 16 10.01
- S-3 TOILET ROOM WALL SIGN, SEE 17 18 19 10.01 10.01 10.01
- S-4 TACTILE "EXIT ROUTE" SIGN (INTERIOR) 4 10.01
- S-5 TACTILE "EXIT" SIGN (INTERIOR) 5 10.01
- S-6 "ACCESSIBLE RESTROOM" DIRECTIONAL SIGNAGE (INTERIOR) 20 10.01

KEYPLAN

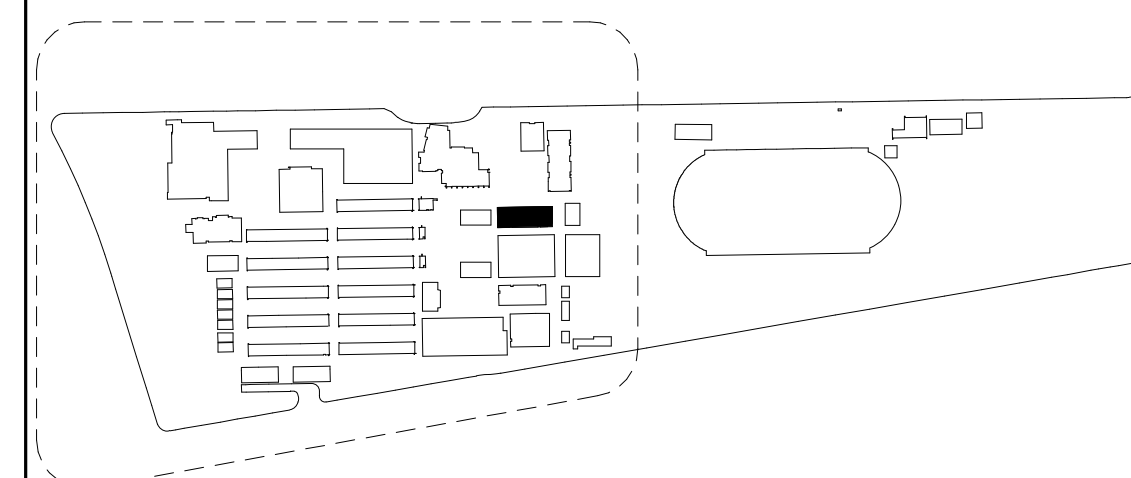

DIVISION OF THE STATE ARCHITECT
355 S. GRAND AVE, SUITE 2100
LOS ANGELES, CA 90071
ph: 213.897.3995 fx: 213.897.3159/0726
DSA Application # 03-123759
DSA File # 19-H32

agency

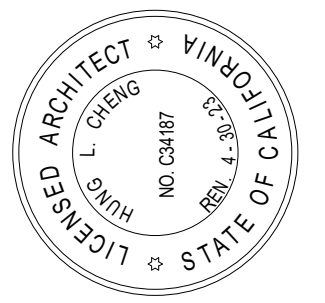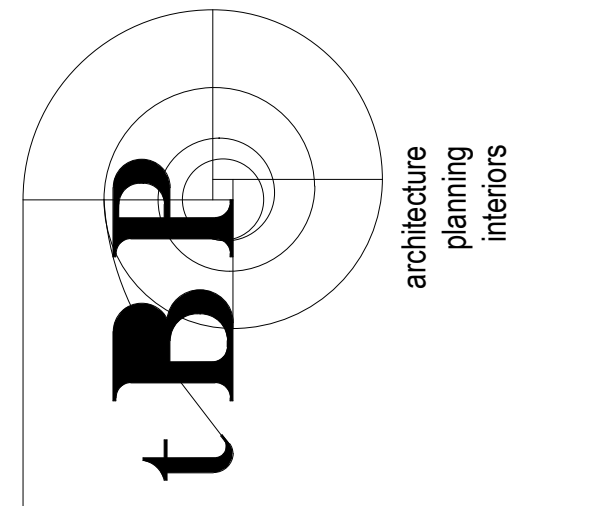

tBP/Architecture
4611 Teller Avenue
Newport Beach, CA 92660
ph: 949.673.0300 fx: 949.732.3895

architect

consultant

ARCADIA HIGH SCHOOL LOCKER ROOM ALTERATION

180 CAMPUS DR.
ARCADIA, CA 91006
ARCADIA UNIFIED SCHOOL DISTRICT

owner

tBP project number: 21110.00
file name:
drawn by: Author checked by: Checker
date: 12/20/2023

rev:	date:	description:
2	03/17/25	ADDENDUM 2

THIS DRAWING AND THE DESIGN, DETAILING, IDEAS AND OTHER INFORMATION CONTAINED HEREIN CONSTITUTE AN UNPUBLISHED WORK OF ARCHITECTURE AND SHALL REMAIN PROPERTY OF ARCHITECTURE IN PERPETUITY. NO PART THEREOF SHALL BE REPRODUCED, DISCLOSED, DISTRIBUTED, SOLD, PUBLISHED OR OTHERWISE USED IN ANY MANNER WITHOUT THE ADVANCED EXPRESS WRITTEN CONSENT OF ARCHITECTURE.


drawing title:
SIGNAGE PLANS

drawing no.:
A10-1


EXTERIOR DOOR SCHEDULE																		
DOOR NO.	WIDTH	HEIGHT	TYPE	DOOR		FRAME		FIRE RATING	DETAIL					REMARKS (COMMENTS)	HARDWARE SET	SIGNAGE		
				MATERIAL	FINISH	MATERIAL	FINISH		JAMB	JAMB	HEAD	TRANSOM	THRESHOLD			SIGNAGE TEXT	SIGNAGE DETAIL	
BLDGB																		
BL02A	3'-0"	7'-0"	A	(E) HM		(E) HM			(E)	(E)	(E)	(E)	(E)	10	OFFICE		2 / 10.01	
BL03A	3'-0"	7'-0"	B	(E) HM		(E) HM			8/8.10	7/8.10	3/8.10	N/A	19/8.10	2	ASB COUNTER		2 / 10.01	
BL03B	3'-0"	7'-0"	B	(E) HM		(E) HM			(E)	(E)	(E)	(E)	(E)	10	ASB COUNTER		2 / 10.01	
BL04	4'-6"	7'-0"	C	HM		HM			8/8.10	8/8.10	3/8.10	N/A	19/8.10	1	WORKROOM / STORAGE		2 / 10.01	
BL06	3'-0"	7'-0"	B	HM		HM			8/8.10	8/8.10	3/8.10	N/A	19/8.10	3	TEAM ROOM 1		2 / 10.01	
BL07	3'-0"	7'-0"	B	HM		HM			8/8.10	8/8.10	3/8.10	N/A	19/8.10	5	TEAM ROOM 2		2 / 10.01	
BL09	3'-0"	7'-0"	AL	HM		HM			8/8.10	8/8.10	3/8.10	N/A	19/8.10	6	ALL GENDER		17 / 10.01	
BL10	3'-0"	7'-0"	B	HM		HM			5/8.51	8/8.10	3/8.10	N/A	19/8.10	2	OFFICE		2 / 10.01	
BL11	3'-0"	7'-0"	B	HM		HM			8/8.10	7/8.51	3/8.10	N/A	19/8.10	4	OFFICE		2 / 10.01	
BL13	3'-0"	7'-0"	A	(E) HM		(E) HM			(E)	(E)	(E)	(E)	(E)	10	STORAGE / OFFICE		2 / 10.01	
BL13A	3'-0"	7'-0"	A	HM		HM			8/8.10	9/8.10	3/8.10	N/A	19/8.10	1	STORAGE / OFFICE		2 / 10.01	
BL14	5'-8"	7'-0"	C	(E) HM		(E) HM			(E)	(E)	(E)	(E)	(E)	(E) PANIC HARDWARE	11	BOYS LOCKER		2 / 10.01
BL15A	5'-0"	7'-0"	AP	(E) HM		(E) HM			(E)	(E)	(E)	(E)	(E)	11	STORAGE		2 / 10.01	
BL17	3'-0"	7'-0"	A	(E) HM		(E) HM			(E)	(E)	(E)	(E)	(E)	10	BOYS		19 / 10.01	
BL18	5'-0"	7'-0"	AP	(E) HM		(E) HM			(E)	(E)	(E)	(E)	(E)	11	MECHANICAL		2 / 10.01	
BL19	3'-0"	7'-0"	AL	(E) HM		(E) HM			(E)	(E)	(E)	(E)	(E)	10	ELECTRICAL		2 / 10.01	
BL20	3'-0"	7'-0"	A	(E) HM		(E) HM			(E)	(E)	(E)	(E)	(E)	10	EQUIPMENT HANDOUT		2 / 10.01	
BL21	5'-8"	7'-0"	C	(E) HM		(E) HM			(E)	(E)	(E)	(E)	(E)	(E) PANIC HARDWARE	11	BOYS LOCKER		2 / 10.01
BL22	3'-0"	7'-0"	A	(E) HM		(E) HM			(E)	(E)	(E)	(E)	(E)	10	PE ATTENDANT OFFICE		2 / 10.01	
BLDGL																		
GL02	3'-0"	7'-0"	B	HM		HM			8/8.10	7/8.10 SIM.	3/8.10	N/A	19/8.10	3	OFFICE		2 / 10.01	
GL04	3'-0"	7'-0"	B	HM		HM			8/8.10	7/8.51	3/8.10	N/A	19/8.10	4	OFFICE		2 / 10.01	
GL05	3'-0"	7'-0"	A	HM		HM			8/8.10	8/8.10	3/8.10	N/A	19/8.10	2	OFFICE		2 / 10.01	
GL06	3'-0"	7'-0"	A	(E) HM		(E) HM			(E)	(E)	(E)	(E)	(E)	10	FACULTY SHOWER / LOCKER		2 / 10.01	
GL07	5'-8"	7'-0"	C	(E) HM		(E) HM			(E)	(E)	(E)	(E)	(E)	(E) PANIC HARDWARE	11	GIRLS LOCKER		2 / 10.01
GL08	3'-0"	7'-0"	A	HM		HM			8/8.10	7/8.10 SIM.	3/8.10	N/A	19/8.10	3	TEAM ROOM 1		2 / 10.01	
GL09	3'-0"	7'-0"	A	HM		HM			8/8.10	7/8.10 SIM.	3/8.10	N/A	19/8.10	2	TEAM ROOM 2		2 / 10.01	
GL10	3'-0"	7'-0"	A	(E) HM		(E) HM			(E)	(E)	(E)	(E)	(E)	10	TEAM ROOM 3		2 / 10.01	
GL11	5'-0"	7'-0"	C	HM		HM			9/8.10	9/8.10	3/8.10	N/A	19/8.10	3	TEAM ROOM 4		2 / 10.01	
GL13	5'-0"	7'-0"	C	(E) HM		(E) HM			(E)	(E)	(E)	(E)	(E)	11	STORAGE		2 / 10.01	
GL14	5'-8"	7'-0"	C	(E) HM		(E) HM			(E)	(E)	(E)	(E)	(E)	(E) PANIC HARDWARE	11	GIRLS LOCKER		2 / 10.01
GL15	3'-0"	7'-0"	AL	(E) HM		(E) HM			(E)	(E)	(E)	(E)	(E)	10	EQUIPMENT HANDOUT		2 / 10.01	
GL16	3'-0"	7'-0"	AL	(E) HM		(E) HM			(E)	(E)	(E)	(E)	(E)	10	ELECTRICAL		2 / 10.01	
GL17	5'-0"	7'-0"	APL	(E) HM		(E) HM			(E)	(E)	(E)	(E)	(E)	11	STORAGE		2 / 10.01	
GL18	3'-0"	7'-0"	A	(E) HM		(E) HM			(E)	(E)	(E)	(E)	(E)	10	GIRLS		18 / 10.01	
GL21	5'-8"	7'-0"	C	(E) HM		(E) HM			(E)	(E)	(E)	(E)	(E)	(E) PANIC HARDWARE	11	GIRLS LOCKER		2 / 10.01
GL24	5'-0"	7'-0"	APL	(E) HM		(E) HM			(E)	(E)	(E)	(E)	(E)	11	MECHANICAL		2 / 10.01	
NORTH GYM (BLDG. K)																		
NG1	7'-6"	7'-0"	AP	(E) HM		(E) HM			(E)	(E)	(E)	(E)	19/8.10	PROVIDE THRESHOLD, (E) DOOR AND FRAME TO REMAIN	8	NORTH GYMNASIUM	(E)	
NG2	7'-6"	7'-0"	AP	(E) HM		(E) HM			(E)	(E)	(E)	(E)	19/8.10	PROVIDE THRESHOLD, (E) DOOR AND FRAME TO REMAIN	8	NORTH GYMNASIUM	(E)	
NG3	7'-6"	7'-0"	AP	(E) HM		(E) HM			(E)	(E)	(E)	(E)	19/8.10	PROVIDE THRESHOLD, (E) DOOR AND FRAME TO REMAIN	8	NORTH GYMNASIUM	(E)	
NG4	3'-8"	7'-0"	A	(E) HM		(E) HM			(E)	(E)	(E)	(E)	19/8.10	PROVIDE THRESHOLD, (E) DOOR AND FRAME TO REMAIN	9	NORTH GYMNASIUM	(E)	
NG5	3'-8"	7'-0"	A	(E) HM		(E) HM			(E)	(E)	(E)	(E)	19/8.10	PROVIDE THRESHOLD, (E) DOOR AND FRAME TO REMAIN	9	NORTH GYMNASIUM	(E)	
NG6	7'-6"	7'-0"	AP	(E) HM		(E) HM			(E)	(E)	(E)	(E)	19/8.10	PROVIDE THRESHOLD, (E) DOOR AND FRAME TO REMAIN	8	NORTH GYMNASIUM	(E)	
NG7	7'-6"	7'-0"	AP	(E) HM		(E) HM			(E)	(E)	(E)	(E)	19/8.10	PROVIDE THRESHOLD, (E) DOOR AND FRAME TO REMAIN	8	NORTH GYMNASIUM	(E)	
NG8	7'-6"	7'-0"	AP	(E) HM		(E) HM			(E)	(E)	(E)	(E)	19/8.10	PROVIDE THRESHOLD, (E) DOOR AND FRAME TO REMAIN	8	NORTH GYMNASIUM	(E)	
Grand total: 44																		

INTERIOR DOOR SCHEDULE																	
DOOR NO.	WIDTH	HEIGHT	TYPE	DOOR		FRAME		FIRE RATING	DETAIL					REMARKS (COMMENTS)	HARDWARE SET	SIGNAGE	
				MATERIAL	FINISH	MATERIAL	FINISH		JAMB	JAMB	HEAD	TRANSOM	THRESHOLD			SIGNAGE TEXT	SIGNAGE DETAIL
BLDG BL																	
BL02	3'-0"	7'-0"	B	WD		(E) WD			(E)	(E)	(E)	(E)	(E)	PROVIDE DOOR AND HARDWARE, (E) FRAME TO REMAIN	5	OFFICE	2 / 10.01
BL05	3'-0"	7'-0"	A	WD		(E) WD			(E)	(E)	(E)	(E)	(E)	PROVIDE DOOR AND HARDWARE, (E) FRAME TO REMAIN	6	ALL GENDER	17 / 10.01
BL08	3'-0"	7'-0"	A	(E) WD		(E) WD			(E)	(E)	(E)	(E)	(E)		10	MECHANICAL	2 / 10.01
BL14A	5'-8"	7'-0"	C	(E) WD		(E) WD			(E)	(E)	(E)	(E)	(E)	(E) PUSH-PULL DOOR, NO LATCH	11	EXIT ROUTE	4 / 10.01
BL15	3'-0"	7'-0"	B	WD		HM			12/8.10	5/8.51	13/8.10 SIM.	N/A	N/A		5	PE ATTENDANT OFFICE	2 / 10.01
BL16	3'-0"	7'-0"	A	(E) WD		(E) WD			(E)	(E)	(E)	(E)	(E)		10	BOYS	19 / 10.01
BL17A	3'-0"	7'-0"	A	HM		(E) HM			(E)	(E)	(E)	(E)	(E)	PROVIDE DOOR AND HARDWARE, (E) FRAME TO REMAIN	7	BOYS	19 / 10.01
BL21A	5'-8"	7'-0"	C	(E) HM		(E) HM			(E)	(E)	(E)	(E)	(E)	(E) PUSH-PULL DOOR, NO LATCH	11	EXIT ROUTE	4 / 10.01
BLDG GL																	
GL06A	3'-0"	7'-0"	A	HM		HM			12/8.10	13/8.10	13/8.10 SIM.	N/A	N/A		10	HEATER	2 / 10.01
GL07A	5'-8"	7'-0"	C	(E) WD		(E) WD			(E)	(E)	(E)	(E)	(E)	(E) PUSH-PULL DOOR, NO LATCH	11	EXIT ROUTE	4 / 10.01
GL14A	5'-8"	7'-0"	C	(E) HM		(E) HM			(E)	(E)	(E)	(E)	(E)	(E) PUSH-PULL DOOR, NO LATCH	11	EXIT ROUTE	4 / 10.01
GL16A	3'-0"	7'-0"	A	HM		(E) HM			(E)	(E)	(E)	(E)	(E)	PROVIDE DOOR AND HARDWARE, (E) FRAME TO REMAIN	7	GIRLS	18 / 10.01
GL19	3'-0"	7'-0"	A	(E) HM		(E) HM			(E)	(E)	(E)	(E)	(E)		10	GIRLS	18 / 10.01
GL20	3'-0"	7'-0"	B	HM		HM			12/8.10	5/8.51	13/8.10 SIM.	N/A	N/A		5	PE ATTENDANT OFFICE	2 / 10.01
GL21A	5'-8"	7'-0"	C	(E) HM		(E) HM			(E)	(E)	(E)	(E)	(E)	(E) PUSH-PULL DOOR, NO LATCH	11	EXIT ROUTE	4 / 10.01
GL22	2'-8"	7'-0"	AL	(E) HM		(E) HM			(E)	(E)	(E)	(E)	(E)		10	OFFICE	2 / 10.01
GL23	2'-8"	7'-0"	A	(E) HM		(E) HM			(E)	(E)	(E)	(E)	(E)		10	CLOSET	2 / 10.01
Grand total: 17																	


DOOR SCHEDULE

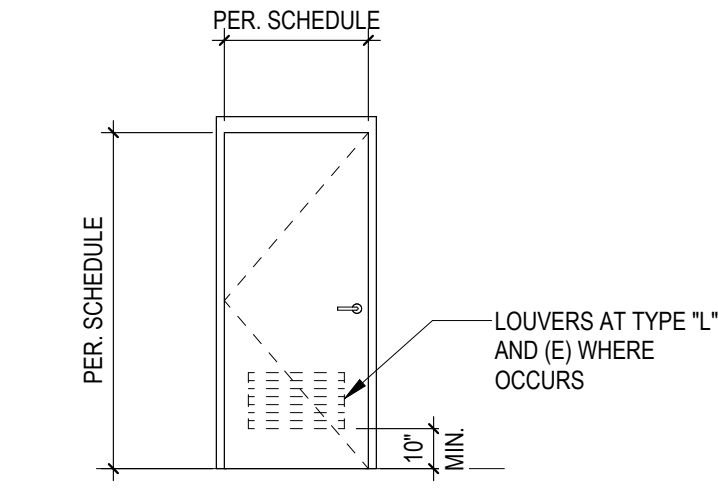

A
DOOR TYPE

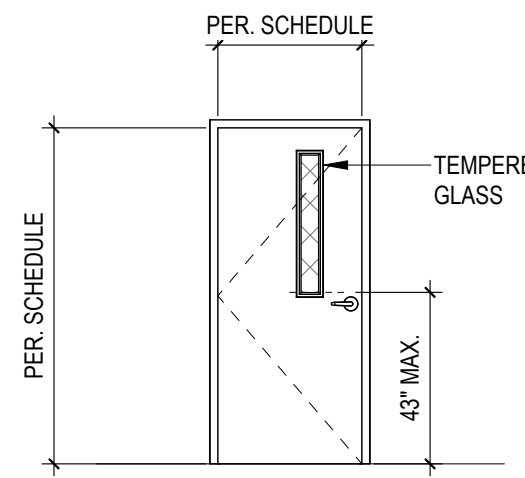

B

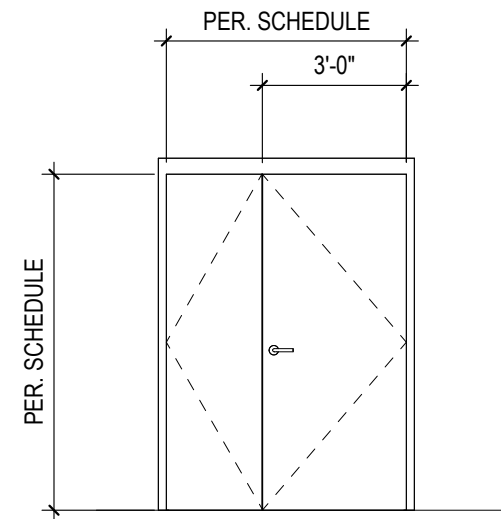

C


SHEET NOTES

- SEE SCHEDULE FOR DIMENSIONS
- DOORS SHALL BE 1-3/4" THICK UNLESS NOTED OTHERWISE.
- THE LETTER "P" FOLLOWING THE "DOOR TYPE" DESIGNATION IN THE DOOR SCHEDULE INDICATES PAIR OF DOORS. BOTH LEAVES ARE THE SAME SIZE, UNLESS NOTED OTHERWISE.
- THE LETTER "X" FOLLOWING THE "DOOR TYPE" LETTER IN THE DOOR SCHEDULE INDICATES A FIXED PANEL ABOVE DOOR LEAF. SCHEDULE DIMENSION INCLUDES PANEL, UNLESS NOTED OTHERWISE.
- FIXED PANELS SHALL BE OF THE SAME MATERIAL, CONSTRUCTION AND THICKNESS AS DOOR LEAF, AND SHALL BE PROVIDED BY THE SAME MANUFACTURER, UNLESS NOTED OTHERWISE.
- THE LETTER "1" FOLLOWING DOOR TYPE DESIGNATION IN THE DOOR SCHEDULE INDICATES DOORS WITH LOUVERS. SEE DOOR TYPE FOR SIZE OF LOUVER.
- LOUVERS IN EXTERIOR DOORS SHALL BE VANDAL-PROOF, SECURITY TYPE.
- GLASS IN ALL FIRE RATED DOORS SHALL BE UL LISTED, 5/16" THICK, FIRE RESISTIVE GLASS, INSTALLED IN STEEL FRAMES.
- GLASS IN NON-RATED EXTERIOR DOORS SHALL BE TINTED TEMPERED GLASS.
- ALL GLASS IN DOORS SHALL BE TEMPERED OR LAMINATED SAFETY GLASS. SEE LEGEND ON FOR GLASS TYPES.
- EXTERIOR DOOR REQUIREMENTS:
 - ALL EXTERIOR DOORS IN BUILDINGS, INCLUDING, BUT NOT LIMITED TO DOORS OF TOILETS AND STORAGE ROOMS, SHALL CONFORM WITH THE REQUIREMENTS OF THE 2022 EDITION OF THE CALIFORNIA BUILDING CODE.
 - EXIT DOOR SHALL BE OPERABLE FROM THE INSIDE WITHOUT THE USE OF A KEY OR ANY SPECIAL KNOWLEDGE OR EFFORT.
 - HAND ACTIVATED DOOR OPENING HARDWARE SHALL BE CENTERED BETWEEN 34" TO 44" ABOVE FINISH FLOOR.
 - DEAD BOLTS ARE NOT PERMITTED UNLESS OPERABLE WITH A SINGLE EFFORT LEVER TYPE HARDWARE.
 - ALL ROOMS SERVING AN OCCUPANCY LOAD OF 50 OR GREATER, AND DOORS LOCATED ON THE DISCHARGE OF EXIT CORRIDORS ARE REQUIRED TO BE PROVIDED WITH PANIC HARDWARE (CBC 1007.3.10).
 - ALL FIRE DOOR LABELS SHALL COMPLY WITH CBC 713.3.
- FIRE ASSEMBLIES REQUIRED TO HAVE A ONE-HOUR FIRE PROTECTION RATING SHALL BE EITHER AUTOMATIC OR SELF-CLOSING FIRE ASSEMBLIES TO BE ACTIVATED BY AN INCREASE IN TEMPERATURE SHALL HAVE HEAT ACTUATING DEVICES INSTALLED ON EACH SIDE OF THE WALL AT THE CEILING HEIGHT WHERE THE CEILING IS MORE THAN 3 FEET ABOVE THE TOP OF THE OPENING OR BY A SINGLE FUSIBLE LINK IN THE OPENING INCORPORATED IN THE CLOSING DEVICE.
- ALL FIRE-RESISTIVE ASSEMBLIES FOR PROTECTED OPENING SHOULD COMPLY WITH SECTION 713 CBC.
- SEE SPECIFICATION SECTION 08071 FOR DOOR HARDWARE INDEX AND DOOR HARDWARE SETS.
- ALL DOORS WITH KEY CARD ACCESS SYSTEM, U.O.N. CARD READERS ARE DOOR MOUNTED. TOP OF DOOR MOUNTED CARD READERS TO BE 44" MAX. A.F.F.
- PROVIDE ACOUSTIC INSULATION IN ALL HOLLOW METAL DOOR FRAMES.

DOOR ABBREVIATIONS


AFP	ACCORDION TYPE PARTITION
ALUM	ALUMINUM
AS	ACID STAIN
ATFD	ACCORDION TYPE FIRE DOOR
DEM PART	DEMOUNTABLE PARTITION
(E)	EXISTING
EP	EPOXY PAINT
F	FACTORY FINISH
FPD	FOLDING FABRIC DOOR
FFP	FOLDING PANEL PARTITION
FFWD	FOLDING PANEL WOOD DOOR
GL	GLASS
HON	HOLLOW CORE NATURAL FINISH
HCP	HOLLOW CORE PAINT FINISH
HM	HOLLOW METAL
LAQ	LACQUER FINISH
MCN	MINERAL CORE NATURAL FINISH
MCP	MINERAL CORE PAINT FINISH
PE	PAINT EGGSHELL
PF	PAINT FLAT
PG	PAINT GLOSS
PSG	PAINT SEMI-GLOSS
S	SEAL
SCN	SOLID CORE NATURAL FINISH
SCP	SOLID CORE PAINT FINISH
SCPL	SOLID CORE PLASTIC LAMINATE
STN	STAIN FINISH
SST	STAINLESS STEEL
STL	UNGLAZED
UG	VARNISH FINISH
VF	WAX
W	WOOD
WD	WOOD

KEYPLAN

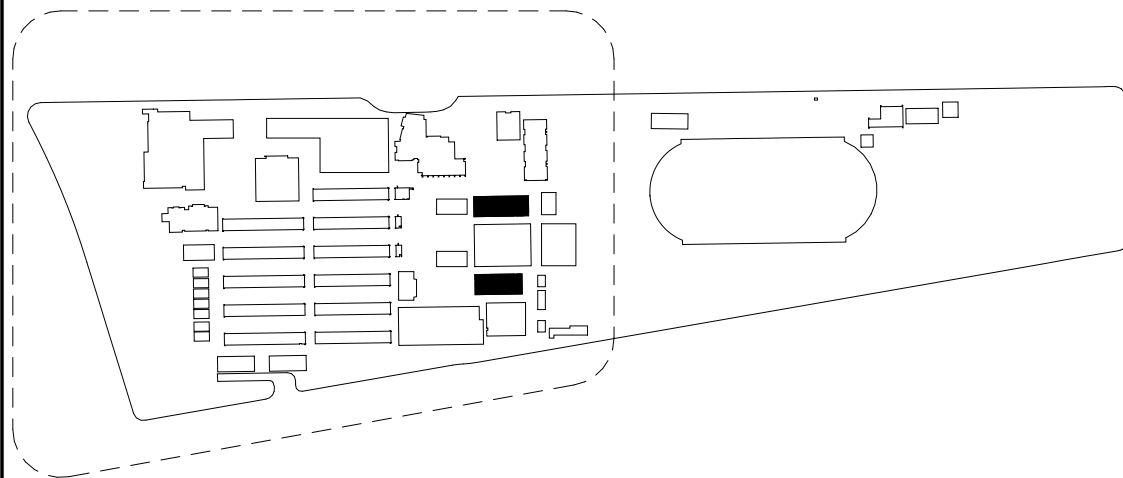

DIVISION OF THE STATE ARCHITECT
355 S. GRAND AVE, SUITE 2100
LOS ANGELES, CA 90071
ph: 213.897.3995 fx: 213.897.3159/0726
DSA Application # 03-123759
DSA File # 19-H32

agency

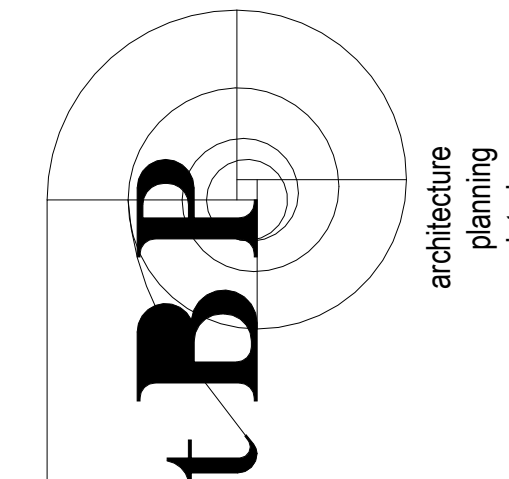


SHEET NOTES

1. FOR MORE INFORMATION, SEE ALSO SHEET 9.01 FINISH SCHEDULE



GLASS SCHEDULE INFORMATION

- G-1 INSULATING VISION GLASS UNIT OF NOMINAL 1" OVERALL THICKNESS
OUTER LIGHT:
COATED, OPTIBLUE TINTED, HEAT TREATED GLASS, FULLY TEMPERED.
NOMINAL 1/4" THICK, SOLARBAN 80 LOW-E COATING ON #2 SURFACE. AIR SPACE 1/2".
INNER LIGHT:
UNCOATED CLEAR, HEAT TREATED GLASS, FULLY TEMPERED.
NOMINAL 1/4" THICK
- G-2 INSULATING TRANSLUCENT GLASS UNIT OF NOMINAL 1" OVERALL THICKNESS
OUTER LIGHT:
COATED, OPTIBLUE TINTED, HEAT TREATED GLASS, FULLY TEMPERED.
NOMINAL 1/4" THICK, SOLARBAN 80 LOW-E COATING ON #2 SURFACE. AIR SPACE 1/2".
INNER LIGHT:
UNCOATED CLEAR, HEAT TREATED GLASS, FULLY TEMPERED.
NOMINAL 1/4" THICK, TRANSLUCENT GLASS SATIN ON #4 SURFACE
- G-3 CLEAR HEAT TREATED GLASS, FULLY TEMPERED, 1/4" THICK
INTERIOR ONLY
- G-4 TWO LAYER 1/8" THICK UNCOATED CLEAR, LAMINATED GLASS
FULLY TEMPERED, SAFETY GLAZING PER CBC CHAPTER 24

KEYPLAN

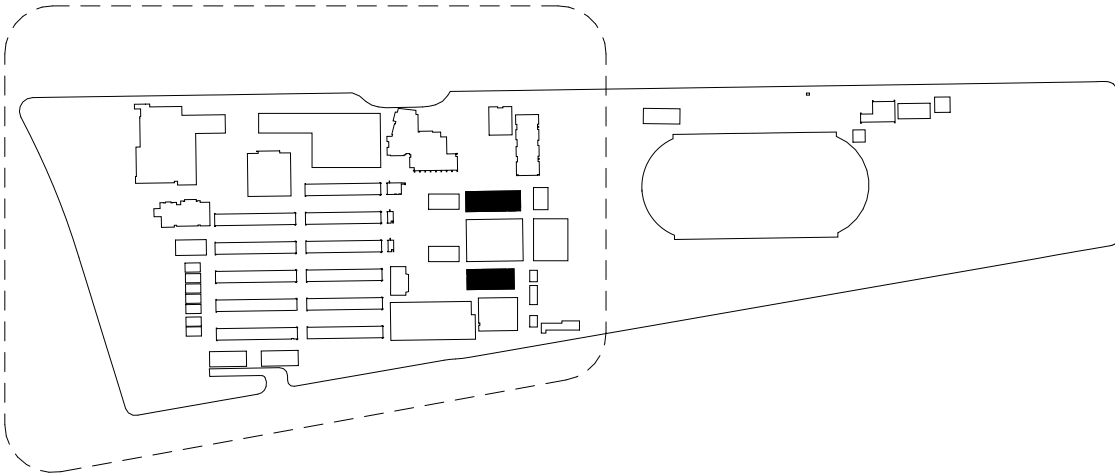

DIVISION OF THE STATE ARCHITECT
355 S. GRAND AVE, SUITE 2100
LOS ANGELES, CA 90071
ph: 213.897.3995 fx: 213.897.3159/0726
DSA Application # 03-123759
DSA File # 19-H32

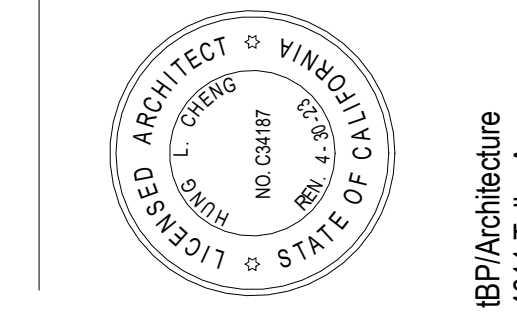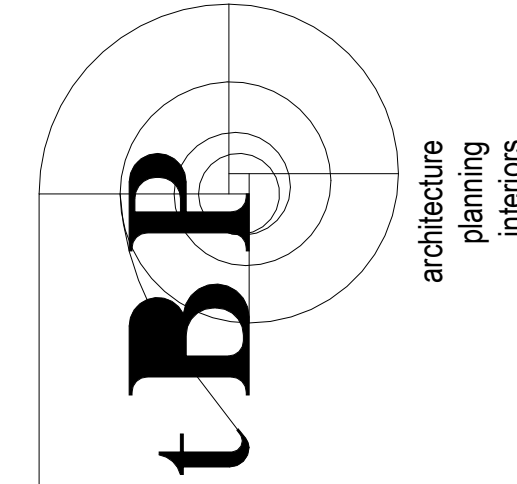

ARCADIA HIGH SCHOOL
LOCKER ROOM ALTERATION

180 CAMPUS DR.
ARCADIA, CA 91006

ARCADIA UNIFIED SCHOOL DISTRICT

owner

tBP project number: 21110.00

file name:

drawn by: Author checked by: Checker

date: 12/20/2023

rev: 2 date: 03/17/25 description: ADDENDUM 2

THIS DRAWING AND THE DESIGN, SPECIFICATIONS, IDEAS AND OTHER INFORMATION CONTAINED HEREIN CONSTITUTE UNPUBLISHED WORK OF ARCHITECTURE AND SHALL REMAIN THE PROPERTY OF ARCHITECTURE IN PERPETUITY. NO PART THEREOF SHALL BE REPRODUCED, DISCLOSED, DISTRIBUTED, SOLD, PUBLISHED OR OTHERWISE USED IN ANY WAY WITHOUT THE ADVANCED EXPRESS WRITTEN CONSENT OF ARCHITECTURE.

drawing title:
WINDOW SCHEDULE

drawing no.:

8.50



FINISH SCHEDULE

SPACE		FLOOR			BASE			WALL			CEILING			REMARKS	
NUMBER	NAME	MATERIAL	FINISH	COLOR	MATERIAL	BASE HEIGHT	FINISH	COLOR	MATERIAL	FINISH	COLOR	MATERIAL	FINISH		COLOR
BLDG BL															
BL-1	BOYS LOCKER RM	SEALED CONC	SLR	ET-2	RUBBER BASE	4"	F	RB-1	(E) PLASTER / (E) GYP. BD.	PSG	MATCH (E)	(E) PLASTER	PSG	MATCH (E)	A6-1
BL-1B	SHOWER	EPOXY TERRAZZO	SLR	ET-2	TERRAZZO EPOXY WALL BASE	4"	SLR	ET-2	TERRAZZO / PARTITION	SLR / F	ET-1 / PTC-2	(E) PLASTER	PSG	MATCH (E)	
BL-1C	SHOWER	EPOXY TERRAZZO	SLR	ET-2	TERRAZZO EPOXY WALL BASE	4"	SLR	ET-2	TERRAZZO / PARTITION	SLR / F	ET-1 / PTC-2	(E) PLASTER	PSG	MATCH (E)	
BL-1D	SHOWER	EPOXY TERRAZZO	SLR	ET-2	TERRAZZO EPOXY WALL BASE	4"	SLR	ET-2	TERRAZZO / PARTITION	SLR / F	ET-1 / PTC-2	(E) PLASTER	PSG	MATCH (E)	
BL-1E	SHOWER	EPOXY TERRAZZO	SLR	ET-2	TERRAZZO EPOXY WALL BASE	4"	SLR	ET-2	TERRAZZO / PARTITION	SLR / F	ET-1 / PTC-2	(E) PLASTER	PSG	MATCH (E)	
BL-1F	SHOWER	EPOXY TERRAZZO	SLR	ET-2	TERRAZZO EPOXY WALL BASE	4"	SLR	ET-2	TERRAZZO / PARTITION	SLR / F	ET-1 / PTC-2	(E) PLASTER	PSG	MATCH (E)	
BL-1G	SHOWER	EPOXY TERRAZZO	SLR	ET-2	TERRAZZO EPOXY WALL BASE	4"	SLR	ET-2	TERRAZZO / PARTITION	SLR / F	ET-1 / PTC-2	(E) PLASTER	PSG	MATCH (E)	
BL-1H	SHOWER	EPOXY TERRAZZO	SLR	ET-2	TERRAZZO EPOXY WALL BASE	4"	SLR	ET-2	TERRAZZO / PARTITION	SLR / F	ET-1 / PTC-2	(E) PLASTER	PSG	MATCH (E)	
BL-1I	SHOWER	EPOXY TERRAZZO	SLR	ET-2	TERRAZZO EPOXY WALL BASE	4"	SLR	ET-2	TERRAZZO / PARTITION	SLR / F	ET-1 / PTC-2	(E) PLASTER	PSG	MATCH (E)	
BL-2	OFFICE	CARPET	F	CPT-1	RUBBER BASE	4"	F	RB-1	(E) PLASTER / (E) GYP. BD.	PSG	MATCH (E)	ACP	F	ACP-1	A6-1
BL-3	ASB OFFICE	CARPET	F	CPT-1	RUBBER BASE	4"	F	RB-1	(E) PLASTER / (E) GYP. BD.	PSG	MATCH (E)	(E) PLASTER / (E) GYP. BD.	F / PSG	ACP-1 / MATCH (E)	A6-1
BL-3A	ASB COUNTER	RESILIENT	F	RS-1	RUBBER BASE	4"	F	RB-1	(E) PLASTER / (E) GYP. BD.	PSG	MATCH (E)	ACP	F	ACP-1	A6-1
BL-3B	LOST & FOUND STOR.	CARPET	F	CPT-1	RUBBER BASE	4"	F	RB-1	(E) PLASTER	PSG	MATCH (E)	ACP	F	ACP-1	A6-1
BL-3C	KITCHENETTE	RESILIENT	F	RS-1	RUBBER BASE	4"	F	RB-1	(E) PLASTER / GYP. BD.	PSG	MATCH (E)	ACP	F	ACP-1	A6-1
BL-4	WORK ROOM STORAGE	RESILIENT	F	RS-1	RUBBER BASE	4"	F	RB-1	(E) PLASTER	PSG	MATCH (E)	ACP	F	ACP-1	A6-1
BL-5	ALL-GENDER R.R.	(E) CONCRETE	SLR	CF-1	RUBBER BASE	4"	F	RB-1	(E) PLASTER / (E) GYP. BD.	PSG	MATCH (E)	(E) PLASTER	PSG	MATCH (E)	A7-2
BL-6	TEAM RM. 1	SEALED CONC	SLR	CF-1	RUBBER BASE	4"	F	RB-1	(E) PLASTER / GYP. BD.	PSG	MATCH (E)	ACPGYP. BD.	F / PSG	ACP-1 / MATCH (E)	A6-2
BL-7	TEAM RM. 2	SEALED CONC	SLR	CF-1	RUBBER BASE	4"	F	RB-1	(E) PLASTER / GYP. BD.	PSG	MATCH (E)	ACPGYP. BD.	F / PSG	ACP-1 / MATCH (E)	A6-2
BL-8	MECH.	(E) CONCRETE	SLR	CF-1	(E) CEMENT BASE	(E) 6"	(E)	(E)	(E) PLASTER	PSG	MATCH (E)	(E) PLASTER	PSG	MATCH (E)	
BL-9	ALL GENDER	EPOXY TERRAZZO	SLR	ET-2	EPOXY TERRAZZO	4"	F	ET-2	TERRAZZO	F	ET-2	GYP. BD.	PSG	P-5	A7-5
BL-10	OFFICE	CARPET	F	CPT-1	RUBBER BASE	4"	F	RB-1	(E) PLASTER / GYP. BD.	PSG	MATCH (E)	ACP	F	ACP-1	A6-3
BL-11	OFFICE	CARPET	F	CPT-1	RUBBER BASE	4"	F	RB-1	(E) PLASTER / GYP. BD.	PSG	MATCH (E)	ACP	F	ACP-1	A6-3
BL-12	OFFICE	CARPET	F	CPT-1	RUBBER BASE	4"	F	RB-1	(E) PLASTER / GYP. BD.	PSG	MATCH (E)	ACP	F	ACP-1	A6-3
BL-13	PE ATTENDANT OFFICE	CARPET	F	CPT-1	RUBBER BASE	4"	F	RB-1	(E) PLASTER / GYP. BD.	PSG	MATCH (E)	ACP	F	ACP-1	A6-4
BL-14	VEST.	(E) CONCRETE	SLR	CF-1	(E) CEMENT BASE	(E) 6"	(E)	(E)	(E) PLASTER	PSG	MATCH (E)	(E)	(E)	MATCH (E)	
BL-15	STORAGE	(E) CONCRETE	(E)	(E)	(E) CEMENT BASE	(E) 6"	(E)	(E)	(E) PLASTER	(E)	(E)	(E) PLASTER	(E)	(E)	
BL-16	BOYS TOILET	(E) TERRAZZO	(E)	(E)	(E) TERRAZZO	(E) 6"	(E)	(E)	(E) TERRAZZO / (E) PLASTER	(E)	(E)	(E) PLASTER	(E)	(E)	
BL-17	BOYS TOILET	(E) TERRAZZO	(E)	(E)	(E) TERRAZZO	(E) 6"	(E)	(E)	(E) TERRAZZO / (E) PLASTER / GYP. BD.	(E) / PSG	(E) / MATCH (E)	(E) PLASTER	(E)	MATCH (E)	A7-1
BL-18	MECHANICAL	(E) CONCRETE	(E)	(E)	(E) CEMENT BASE	(E) 6"	(E)	(E)	(E) PLASTER	(E)	(E)	(E) PLASTER	(E)	(E)	
BL-19	ELECTRICAL	(E) CONCRETE	(E)	(E)	(E) CEMENT BASE	(E) 6"	(E)	(E)	(E) PLASTER	(E)	(E)	(E) PLASTER	(E)	(E)	
BL-20	EQUIP. HANDOUT	(E) CONCRETE	(E)	(E)	(E) CEMENT BASE	(E) 6"	(E)	(E)	(E) PLASTER	(E)	(E)	(E) PLASTER	(E)	(E)	
BL-21	VEST.	(E) CONCRETE	SLR	CF-1	(E) CEMENT BASE	(E) 6"	(E)	(E)	(E) PLASTER	PSG	MATCH (E)	(E) PLASTER	PSG	MATCH (E)	
BL-22	SHARED STOR/TEMP. OFFICE	(E) CONCRETE	SLR	CF-1	(E) CEMENT BASE	(E) 6"	(E)	(E)	(E) PLASTER / GYP. BD.	PSG	MATCH (E)	(E) PLASTER	PSG	MATCH (E)	A6-4
EPOXYB	SHOWER	EPOXY TERRAZZO	F	ET-2	TERRAZZO	4"	F	RB-1	TERRAZZO / PARTITION	F	ET-2 / PTC-2	(E) PLASTER	PSG	MATCH (E)	A7-5
BLDG GL															
GL-1	GIRLS LOCKER RM	(E) CONCRETE	SLR	RS-1	(E) CEMENT BASE	(E) 6"	(E)	(E)	(E) PLASTER / (E) GYP. BD.	PSG	MATCH (E)	(E) PLASTER	PSG	MATCH (E)	
GL-1A	SHOWER	EPOXY TERRAZZO	F	ET-2	TERRAZZO EPOXY WALL BASE	4"	SLR	ET-2	TERRAZZO / PARTITION	SLR / F	ET-1 / PTC-2	(E) PLASTER	PSG	MATCH (E)	
GL-1B	SHOWER	EPOXY TERRAZZO	F	ET-2	TERRAZZO EPOXY WALL BASE	4"	SLR	ET-2	TERRAZZO / PARTITION	SLR / F	ET-1 / PTC-2	(E) PLASTER	PSG	MATCH (E)	
GL-1C	SHOWER	EPOXY TERRAZZO	F	ET-2	TERRAZZO EPOXY WALL BASE	4"	SLR	ET-2	TERRAZZO / PARTITION	SLR / F	ET-1 / PTC-2	(E) PLASTER	PSG	MATCH (E)	
GL-1D	SHOWER	EPOXY TERRAZZO	F	ET-2	TERRAZZO EPOXY WALL BASE	4"	SLR	ET-2	TERRAZZO / PARTITION	SLR / F	ET-1 / PTC-2	(E) PLASTER	PSG	MATCH (E)	
GL-1E	SHOWER	EPOXY TERRAZZO	F	ET-2	TERRAZZO EPOXY WALL BASE	4"	SLR	ET-2	TERRAZZO / PARTITION	SLR / F	ET-1 / PTC-2	(E) PLASTER	PSG	MATCH (E)	
GL-1F	SHOWER	EPOXY TERRAZZO	F	ET-2	TERRAZZO EPOXY WALL BASE	4"	SLR	ET-2	TERRAZZO / PARTITION	SLR / F	ET-1 / PTC-2	(E) PLASTER	PSG	MATCH (E)	
GL-1G	SHOWER	EPOXY TERRAZZO	F	ET-2	TERRAZZO EPOXY WALL BASE	4"	SLR	ET-2	TERRAZZO / PARTITION	SLR / F	ET-1 / PTC-2	(E) PLASTER	PSG	MATCH (E)	
GL-2	OFFICE	CARPET	F	CPT-1	RUBBER BASE	4"	F	RB-1	(E) PLASTER / (E) GYP. BD.	PSG	MATCH (E)	ACP	F	ACP-1	A6-4
GL-3	OFFICE	CARPET	F	CPT-1	RUBBER BASE	4"	F	RB-1	(E) PLASTER / GYP. BD.	PSG	MATCH (E)	ACP	F	ACP-1	A6-4
GL-5	OFFICE	CARPET	F	CPT-1	RUBBER BASE	4"	F	RB-1	(E) PLASTER / GYP. BD.	PSG	MATCH (E)	ACP	F	ACP-1	A6-5
GL-6	FACULTY SHOWER/LOCKER	(E) RESILIENT	(E)	(E)	(E)	(E)	(E)	(E)	(E) PLASTER / (E) GYP. BD.	PSG	MATCH (E)	(E) PLASTER	PSG	MATCH (E)	A7-2
GL-6A	HEATER	(E) CONCRETE	(E)	(E)	(E) CEMENT BASE	(E)	(E)	(E)	(E) PLASTER	(E)	(E)	(E) PLASTER	(E)	(E)	
GL-7	VEST	(E) CONCRETE	SLR	CF-1	(E) CEMENT BASE	(E) 6"	(E)	(E)	(E) PLASTER	PSG	MATCH (E)	(E) PLASTER	PSG	MATCH (E)	
GL-8	TEAM RM.1	SEALED CONC.	SLR	CF-1	RUBBER BASE	4"	F	RB-1	(E) PLASTER / GYP. BD.	PSG	MATCH (E)	ACPGYP. BD.	F / PSG	ACP-1 / MATCH (E)	A6-5
GL-9	TEAM RM. 2	SEALED CONC.	SLR	CF-1	RUBBER BASE	4"	F	RB-1	(E) PLASTER / GYP. BD.	PSG	MATCH (E)	ACPGYP. BD.	F / PSG	ACP-1 / MATCH (E)	A6-6
GL-10	TEAM RM. 3	SEALED CONC.	SLR	CF-1	RUBBER BASE	4"	F	RB-1	(E) PLASTER / GYP. BD.	PSG	MATCH (E)	ACPGYP. BD.	F / PSG	ACP-1 / MATCH (E)	A6-6
GL-11	TEAM RM. 4	SEALED CONC.	SLR	CF-1	RUBBER BASE	4"	F	RB-1	(E) PLASTER / GYP. BD.	PSG	MATCH (E)	ACPGYP. BD.	F / PSG	ACP-1 / MATCH (E)	A6-7
GL-12	STORAGE	(E) VCT	(E)	(E)	(E)	(E)	(E)	(E)	(E) PLASTER	(E)	(E)	(E) PLASTER	(E)	(E)	
GL-14	VEST.	(E) CONCRETE	SLR	CF-1	(E) CEMENT BASE	(E) 6"	(E)	(E)	(E) PLASTER	PSG	MATCH (E)	(E) PLASTER	PSG	MATCH (E)	
GL-15	EQUIP. HANDOUT	(E) VCT	(E)	(E)	(E)	(E)	(E)	(E)	(E) GYP. BD.	(E)	(E)	(E) PLASTER	(E)	(E)	
GL-16	ELEC. RM.	(E) CONCRETE	(E)	(E)	(E) CEMENT BASE	(E)	(E)	(E)	(E) GYP. BD.	(E)	(E)	(E) PLASTER	(E)	(E)	
GL-17	STORAGE	(E) VCT	(E)	(E)	(E)	(E)	(E)	(E)	(E) GYP. BD.	(E)	(E)	(E) PLASTER	(E)	(E)	
GL-18	GIRLS TOILET	(E) TERRAZZO	(E)	(E)	(E) TERRAZZO	(E) 6"	(E)	(E)	(E) TERRAZZO / (E) PLASTER	(E) / PSG	MATCH (E)	(E) PLASTER	PSG	MATCH (E)	A7-1
GL-19	GIRLS TOILET	(E) TERRAZZO	(E)	(E)	(E) TERRAZZO	(E) 6"	(E)	(E)	(E) TERRAZZO / (E) PLASTER	(E)	(E)	(E) PLASTER	(E)	(E)	
GL-20	PE ATTENDANT OFFICE	(E) CONCRETE	SLR	RS-1	(E) CEMENT BASE	(E) 6"	(E)	(E)	(E) PLASTER / GYP. BD.	PSG	MATCH (E)	(E) PLASTER	PSG	MATCH (E)	A6-7
GL-21	VEST.	(E) CONCRETE	SLR	RS-1	(E) CEMENT BASE	(E) 6"	(E)	(E)	(E) PLASTER	PSG	MATCH (E)	(E) PLASTER	PSG	MATCH (E)	
GL-22	CLOSET	(E) CONCRETE	(E)	(E)	(E) CEMENT BASE	(E) 6"	(E)	(E)	(E) PLASTER	(E)	(E)	(E) PLASTER	(E)	(E)	
GL-23	CLOSET	(E) CONCRETE	(E)	(E)	(E) CEMENT BASE	(E) 6"	(E)	(E)	(E) PLASTER	(E)	(E)	(E) PLASTER	(E)	(E)	
GL-24	MECHANICAL ROOM	(E) VCT	(E)	(E)	(E) CEMENT BASE	(E) 6"	(E)	(E)	(E) PLASTER	(E)	(E)	(E) PLASTER	(E)	(E)	


SHEET NOTES

INTERIOR WALL AND CEILING FINISH MATERIAL SHALL BE CLASSIFIED IN ACCORDANCE WITH ASTM B4 OR UL 723. SUCH INTERIOR FINISH MATERIALS SHALL BE GROUPED IN THE FOLLOWING CLASSES IN ACCORDANCE WITH THEIR FLAME AND SMOKE-DEVELOPED INDEXES. REFER TO 803.1.1 (SEE EXCEPTION 803.1.2 AND CFC 803.1).

- INTERIOR WALL AND CEILING FINISHES SHALL BE CLASSIFIED FOR FIRE PERFORMANCE AND SMOKE DEVELOPMENT PER SECTION 803.
- INTERIOR WALL AND CEILING FINISHES SHALL BE CLASSIFIED BY OCCUPANCY PER TABLE 803.1.1 OR BE TESTED PER SECTION 803.1.2 (NFPA 286 CRITERIA).
- TEXTILE AND VINYL WALL COVERING SHALL BE TESTED OPER 803.13 ACCEPTANCE CRITERIA OF NFPA 286 OR PER 803.14 ACCEPTANCE CRITERIA TESTED TO ASTM E84 OR UL 723 CLASS FLAME SPREAD INDEX AND PROTECTED BY AN AUTOMATIC FIRE SPRINKLER SYSTEM PER 903.1.1 OR 903.1.1.2.
- EXCEPTION: 903.2 MATERIAL LESS THAN 0.03" THICK APPLIED DIRECTLY NEED NOT BE TESTED.
- INTERIOR FLOOR FINISHES SHALL COMPLY WITH SECTION 804.
- DECORATIVE TRIM & MATERIALS SHALL COMPLY WITH SECTION 806.
- THERMAL AND ACOUSTICAL INSULATION SHALL COMPLY WITH SECTION 719.

CALIFORNIA REQUIRES ALL FABRIC USED IN PUBLIC PLACES TO BE REGISTERED WITH THE STATE FIRE MARSHAL, AND COMPLY WITH TITLE 19 REQUIREMENTS OF THE CALIFORNIA CODE OF REGULATIONS.

DIVISION OF THE STATE ARCHITECT
355 S. GRAND AVE, SUITE 2100
LOS ANGELES, CA 90071
ph: 213.897.3995 fx: 213.897.5159/0726
DSA Application # 03-123759
DSA File # 19-H32

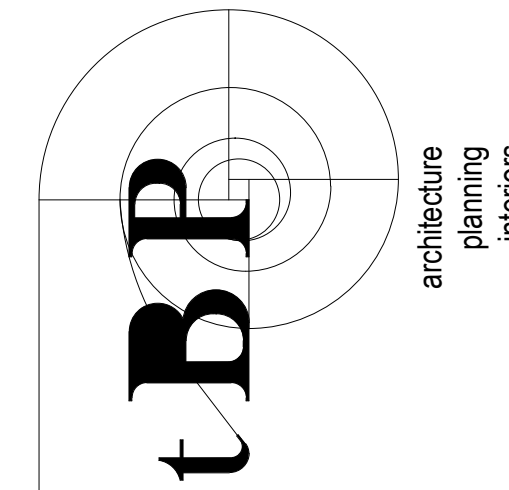


architect

consultant

ABBREVIATIONS

ACP	ACOUSTICAL CEILING PANEL
ACT	ACOUSTICAL CEILING TILE
BD	BOARD
CMU	CERAMIC MOSAIC TILE
CMU	CONCRETE MASONRY UNIT
CPT	CARPET
CONC	CONCRETE
CT	CERAMIC TILE
EPXY	EPOXY
EXP	EXPOSED
FRP	FACTORY FINISH
GYP	GYP. FINISH
GYP. BD.	GYP. FINISH BOARD
GWB	GYP. FINISH BOARD
LTF	LINOLEUM TILE FLOORING
MTL	METAL
EP	EPOXY PAINT
PE	PAINT EGGSHELL
PF	PAINT FLAT
PG	PAINT GLOSS
PNL	PANEL
PSG	PAINT SEMI GLOSS
Q	QUARRY TILE
RB	RUBBER BASE
RESIL	RESILIENT
RTF	RUBBER TILE FLOORING
SE	SATIN FINISH
SV	SHEET VINYL
UOS	UNDERSIDE OF STRUCTURE
VCT	VINYL COMPOSITION TILE
VWC	VINYL WALL COVERING

KEYPLAN

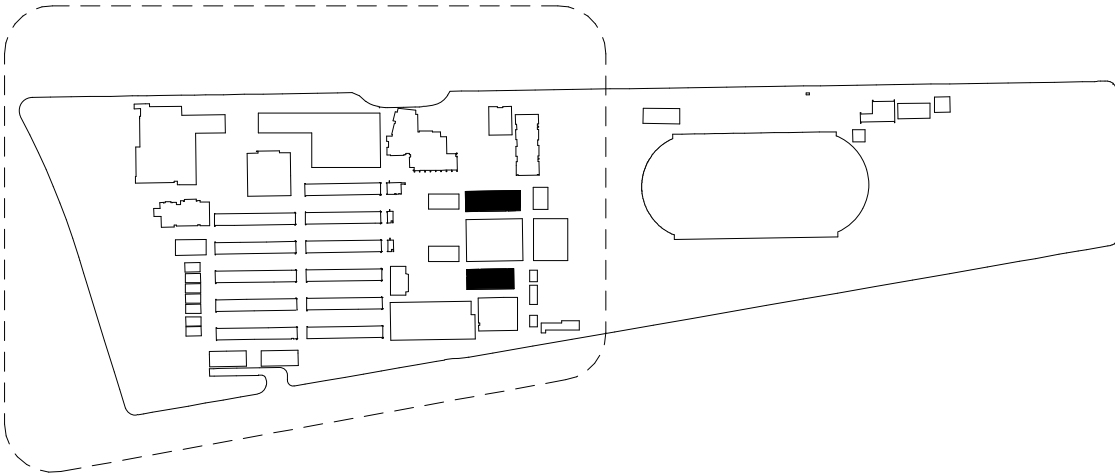

ARCADIA HIGH SCHOOL
LOCKER ROOM ALTERATION

180 CAMPUS DR.
ARCADIA, CA 91006

ARCADIA UNIFIED SCHOOL DISTRICT

tBP project number: 21110.00

file name:

drawn by: Author checked by: Checker

date: 12/20/2023

rev:	date:	description:
1	03/12/25	ADDENDUM 1
2	03/17/25	ADDENDUM 2

THIS DRAWING AND THE DESIGN, SPECIFICATIONS, IDEAS AND OTHER INFORMATION CONTAINED HEREIN CONSTITUTE UNPUBLISHED WORK OF ARCHITECTURE AND SHALL REMAIN THE PROPERTY OF ARCHITECTURE IN PERPETUITY. NO PART OF THIS DRAWING SHALL BE REPRODUCED, DISCLOSED, DISTRIBUTED, SOLD, PUBLISHED OR OTHERWISE USED IN ANY MANNER WITHOUT THE ADVANCED EXPRESS WRITTEN CONSENT OF ARCHITECTURE.

drawing title:
FINISH SCHEDULE

drawing no.:

9.01



COLOR SCHEDULE

SPEC SECTION	MATERIAL	DESIGNATION	MANUF. / CATEGORY	COLOR NO.	COLOR NAME	REMARKS	SPEC SECTION	MATERIAL	DESIGNATION	MANUF. / CATEGORY	COLOR NO.	COLOR NAME	REMARKS
03 30 30 CAST-IN-PLACE CONCRETE	CONCRETE FLOORS	CF-1	-	-	NATURAL COLOR	INTERIOR							
	CONCRETE FLOORS	CF-2	-	-	NATURAL COLOR	EXTERIOR							
04 21 13.13 BRICK VENEER MASONRY	BRICK VENEER	BR-1	INTERSTATE BRICK	-	EMPEROR, TERRA COTTA, MATTE	EXTERIOR							
05 41 00 ARCHITECTURAL WOOD CASEWORK	PLASTIC LAMINATE	LP-1	FORMICA	5786-NG	ASHWOOD OAK, NATURAL GRAIN	INTERIOR, CASEWORK VERTICAL FACE							
	SOLID SURFACE COUNTERTOP	SS-1	FORMICA EVERFORM	749	GRAY RENEW	INTERIOR							
07 62 00 SHEET METAL FLASHING AND TRIM	FLASHING	FL-1	SEE SPECIFICATIONS	-	COLOR TO MATCH ADJACENT SURFACE	FACTORY FINISH							
07 92 00 JOINT SEALANT	SEALANT	JS-1	SEE SEPOIFICATIONS	-	COLOR TO MATCH ADJOINING SURFACES	-							
08 11 13 HOLLOW METAL DOORS AND FRAMES	HOLLOW METAL DOOR COLOR	HMD-1	BENJAMIN MOORE	HC-184	COTTAGE RED	EXTERIOR, INTERIOR							
	HOLLOW METAL FRAME COLOR	HMF-1	BENJAMIN MOORE	HC-184	COTTAGE RED	EXTERIOR, INTERIOR							
08 14 16 FLUSH WOOD DOORS	WOOD DOOR COLOR	WD-1	BENJAMIN MOORE	HC-184	COTTAGE RED	INTERIOR							
08 31 00 ACCESS DOORS AND PANELS	ACCESS DOOR PANELS	AD-1	KARP ASSOCIATES	-	COLOR TO MATCH P-5	EXTERIOR, INTERIOR							
08 43 13 ALUMINUM FRAMED STOREFRONTS	ALUMINUM FRAMED STOREFRONT	AL-1	ARCADIA	UCS1131XL	SILVER 3-COAT XL	EXTERIOR, INTERIOR							
	ALUMINUM FRAMED WINDOW SHADE	WS-1	ARCADIA	UCS1131XL	SILVER 3-COAT XL	EXTERIOR							
08 80 00 GLAZING	WINDOW GLAZING	G-1	VITRO	-	SOLARBAN 60 (SRF #2) OPTIBLUE + CLEAR	EXTERIOR, VISION GLASS CLEAR, INSULATED, SEE SHEET 8.50							
	WINDOW GLAZING	G-2	VITRO	-	SOLARBAN 60 (SRF #2) OPTIBLUE + CLEAR	EXTERIOR, TRANSLUCENT GLASS SATIN, INSULATED, SEE SHEET 8.50							
	WINDOW GLAZING	G-3	VITRO	-	CLEAR	INTERIOR, VISION GLASS CLEAR, TEMPERED, SEE SHEET 8.50							
	WINDOW GLAZING	G-4	VITRO	-	CLEAR	INTERIOR, SAFETY GLAZING PER CBC CHAPTER 24, LAMINATED, SEE SHEET 8.50							
09 24 00 PORTLAND CEMENT PLASTER	CEMENT PLASTER	PL-1	PAREx	2125-70	MATCH BENJAMIN MOORE WEDDING VEIL SAND SMOOTH ACRYLIC FINISH	EXTERIOR							
	CEMENT PLASTER	PL-2	PAREx	1599	MATCH BENJAMIN MOORE MARINA GRAY SAND SMOOTH ACRYLIC FINISH	EXTERIOR, ACCENT							
09 51 00 SUSPENDED ACOUSTICAL CEILINGS	ACOUSTICAL CEILING	ACP-1	ARMSTRONG DUNE SECOND LOOK (2'x4')	2722	WHITE	INTERIOR, ANGLED TEGULAR							
09 65 00 RESILIENT FLOORING	RESILIENT BASE	RB-1	TARKETT	48	GREY WG	INTERIOR							
09 66 23 RESINOUS MATRIX TERRAZZO FLOORING	EPOXY TERRAZZO	ET-1	TERRAZZO & MARBLE SUPPLY CO. TERROXY RESIN SYSTEMS	TZ 21GG-1182	-	INTERIOR, RESTROOM WALL							
	EPOXY TERRAZZO	ET-2	TERRAZZO & MARBLE SUPPLY CO. TERROXY RESIN SYSTEMS	TZ 21GG0-1175	-	INTERIOR, RESTROOM FLOOR AND BASE							
09 77 00 FIBERGLASS REINFORCED WALL PANELS	FIBERGLASS REINFORCED PLASTIC	FRP-1	MARLITE STANDARD FRP	S100G	WHITE	INTERIOR							
09 90 00 PAINTING	PAINT	P-1	BENJAMIN MOORE	2125-70	WEDDING VEIL	EXTERIOR							
	PAINT	P-2	BENJAMIN MOORE	1599	MARINA GRAY	EXTERIOR							
	PAINT	P-4	BENJAMIN MOORE	HC-184	COTTAGE RED	EXTERIOR, DOORS							
	PAINT	P-5	BENJAMIN MOORE	OC-152	SUPER WHITE	INTERIOR, CEILING							
	PAINT	P-6	BENJAMIN MOORE	OC-45	SWISS COFFEE	INTERIOR, FIELD							
	PAINT	P-7	BENJAMIN MOORE	1587	GIBRALTER CLIFFS	INTERIOR, ACCENT							
09 96 00 HIGH PERFORMANCE COATING	HIGH PERFORMANCE COATING	HP-1	AKZO NOBLE PAINTS DEVOE TRU-GLAZE-WB 4428	1599	MATCH BENJAMIN MOORE COTTAGE RED	EXTERIOR COLUMNS, AND BRACES							
	HIGH PERFORMANCE COATING	HP-2	AKZO NOBLE PAINTS DEVOE TRU-GLAZE-WB 4428	2125-70	MATCH BENJAMIN MOORE WEDDING VEIL	EXTERIOR STAIR STRINGER							
10 11 00 VISUAL DISPLAY UNIT	MARKER BOARD	MB-1	CLARIDGE SERIES 8	100	WHITE	INTERIOR							
10 21 13.19 PLASTIC TOILET COMPARTMENTS	HDPE	PTC-1	HADRIAN	227	PAISLEY	INTERIOR, RESTROOM							
10 21 13.19 PLASTIC TOILET COMPARTMENTS	HDPE	PTC-2	HADRIAN	215	BURGUNDY	INTERIOR, SHOWERS							
10 29 00 TOILET ACCESSORIES	SEE SPECIFICATIONS	-	SEE SPECIFICATIONS	-	-	-							
12 24 00 WINDOW SHADES	SHADES	RS-1	MECHOSHADE SYSTEMS INC. EUROTWILL 6000 SERIES	6009	DOVE GREY	3% OPEN							
DIVISION 22 PLUMBING	SEE SPECIFICATIONS	-	SEE SPECIFICATIONS	-	SEE SPECIFICATIONS	-							
DIVISION 23 HEATING, VENTILATION, AND HVAC	SEE SPECIFICATIONS	-	SEE SPECIFICATIONS	-	CUSTOM	AT EXPOSED DUCTS MATCH P-5							
DIVISION 26 ELECTRICAL	SEE SPECIFICATIONS	-	SEE SPECIFICATIONS	-	SEE SPECIFICATIONS	-							
DIVISION 27 COMMUNICATIONS	SEE SPECIFICATIONS	-	-	-	-	-							
32 14 13 PRECAST CONCRETE UNIT PAVING	CONCRETE UNIT PAVER	CUP-1	ACKER- STONE INDUSTRY INC.	-	BUFF-BROWN	EXTERIOR							

C:\Users\wmsa\OneDrive\TBP\Documents\AHS_Archievt\Archives_P\Lockers_Capital_wmsa\HSR203.rvt

ABBREVIATIONS



A.C.T.	ACOUSTICAL CEILING TILE
AGL	AGLOMMERATE TILE
BD	BOARD
CMT	CERAMIC MOSAIC TILE
CMU	CONCRETE MASONRY UNIT
CONC	CONCRETE
CT	CERAMIC TILE
EPXY	EPOXY
EXPSD	EXPOSED
F	FACTORY FINISH
FRP	FIBER REINFORCED PLASTIC PANEL
GL	GLASS
GYP	GYPSUM
LAM	PLASTIC LAMINATE
LTF	LINOLEUM TILE FLOORING
MTL	METAL
EP	EPOXY PAINT
PE	PAINT EGGSHELL
PF	PAINT FLAT
PG	PAINT GLOSS
PNL	PANEL
PS	PAINT SATIN
PSG	PAINT SEMI GLOSS
QT	QUARRY TILE
RESIL	RESILIENT
RTF	RUBBER TILE FLOORING
SF	SATIN FINISH
SLR	SEALER
SS	STAINLESS STEEL
SV	SHEET VINYL
U.O.S	UNDERSIDE OF STRUCTURE
VCT	VINYL COMPOSITION TILE
VFWC	VINYL FABRIC WALL COVERING

SHEET NOTES

1. ALL INTERIOR FINISHES SHALL COMPLY WITH THE FLAME SPREAD AND SANITATION REQUIRMENTS OF CHAPTERS 6, C & C.
- A. INTERIOR WALL AND CEILING FINISH MATERIALS SHALL BE CLASSIFIED IN ACCORDANCE WITH ASTM 84 OR UL 723. SUCH INTERIOR FINISH MATERIALS SHALL BE GROUPED IN THE FOLLOWING CLASSES IN ACCORDANCE WITH THEIR FLAME AND SMOKE-DEVELOPED INDEXES. REFER TO 803.1.1 (SEE EXCEPTION 803.1.2) AND CFC 803.1.
- a. INTERIOR WALL AND CEILING FINISHES SHALL BE CLASSIFIED FOR FIRE PERFORMANCE AND SMOKE DEVELOPMENT PER SECTION 803.
- b. INTERIOR WALLS AND CEILING FINISHES SHALL BE CLASSIFIED BY OCCUPANCY PER TABLE 803.13 OR BE TESTED PER SECTION 803.1.2 (NFPA 286 CRITERIA).
- c. TEXTILE AND VINYL WALL COVERINGS SHALL BE TESTED PER 803.1.3 ACCEPTANCE CRITERIA OF NFPA 265. OR, PER 803.1.4 ACCEPTANCE CRITERIA TESTED TO ASTM E84 OR UL 723 CLASS A FLAME SPREAD INDEX AND PROTECTED BY AN AUTOMATIC FIRE SPRINKLER SYSTEM PER 903.1.1 OR 903.1.1.2. EXCEPTION: 803.2 MATERIALS LESS THAN 0.036" THICK APPLIED DIRECTLY NEED NOT BE TESTED.
- d. INTERIOR FLOOR FINISHES SHALL COMPLY WITH SECTION 804.
- e. DECORATIVE TRIM & MATERIALS SHALL COMPLY WITH SECTION 806.
- f. THERMAL AND ACOUSTICAL INSULATION SHALL COMPLY WITH SECTION 719.
- B. CALIFORNIA REQUIRES ALL FABRIC USED IN PUBLIC PLACES TO BE REGISTERED WITH THE STATE FIRE MARSHAL AND COMPLY WITH TITLE 19 REQUIREMENTS OF THE CALIFORNIA CODE OF REGULATIONS.

DIVISION OF THE STATE ARCHITECT
355 S. GRAND AVE, SUITE 2100
LOS ANGELES, CA 90071
ph: 213.897.3995 fx: 213.897.3159/0726
DSA Application # 03-123759
DSA File # 19-H32

agency

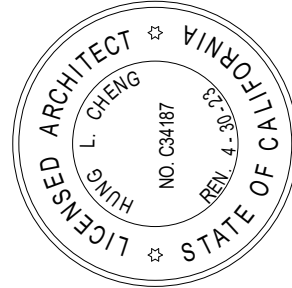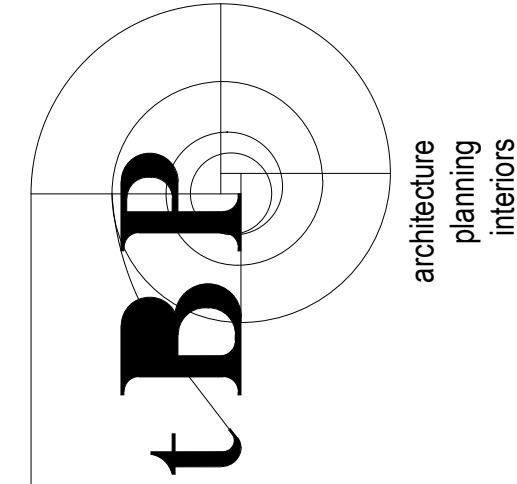

tBP Architecture
4611 Teller Avenue
Newport Beach, CA 92660
ph: 949.673.0300 fx: 949.732.3895

architect

consultant

ARCADIA HIGH SCHOOL
LOCKER ROOM ALTERATION

180 CAMPUS DR.
ARCADIA, CA 91006

ARCADIA UNIFIED SCHOOL DISTRICT

owner

tBP project number: 21110.00

file name:

drawn by: Author checked by: Checker

date: 12/20/2023

rev: 2 date: 03/17/25 description: ADDENDUM 2


THIS DRAWING AND THE DESIGN, DEPICTIONS, IDEAS AND OTHER INFORMATION CONTAINED HEREIN CONSTITUTE UNPUBLISHED WORK OF ARCHITECTURE AND SHALL REMAIN PROPERTY OF ARCHITECTURE IN PERPETUITY. NO PART THEREOF SHALL BE REPRODUCED, DISCLOSED, DISTRIBUTED, SOLD, PUBLISHED OR OTHERWISE USED IN ANY MANNER WITHOUT THE ADVANCED EXPRESS WRITTEN CONSENT OF ARCHITECTURE.

drawing title:
COLOR SCHEDULE

drawing no.:

9.02

C:\Users\W\OneDrive\Documents\ANS_Architectural\Projects\BL Lockers_E_R24_wanna0123.rvt

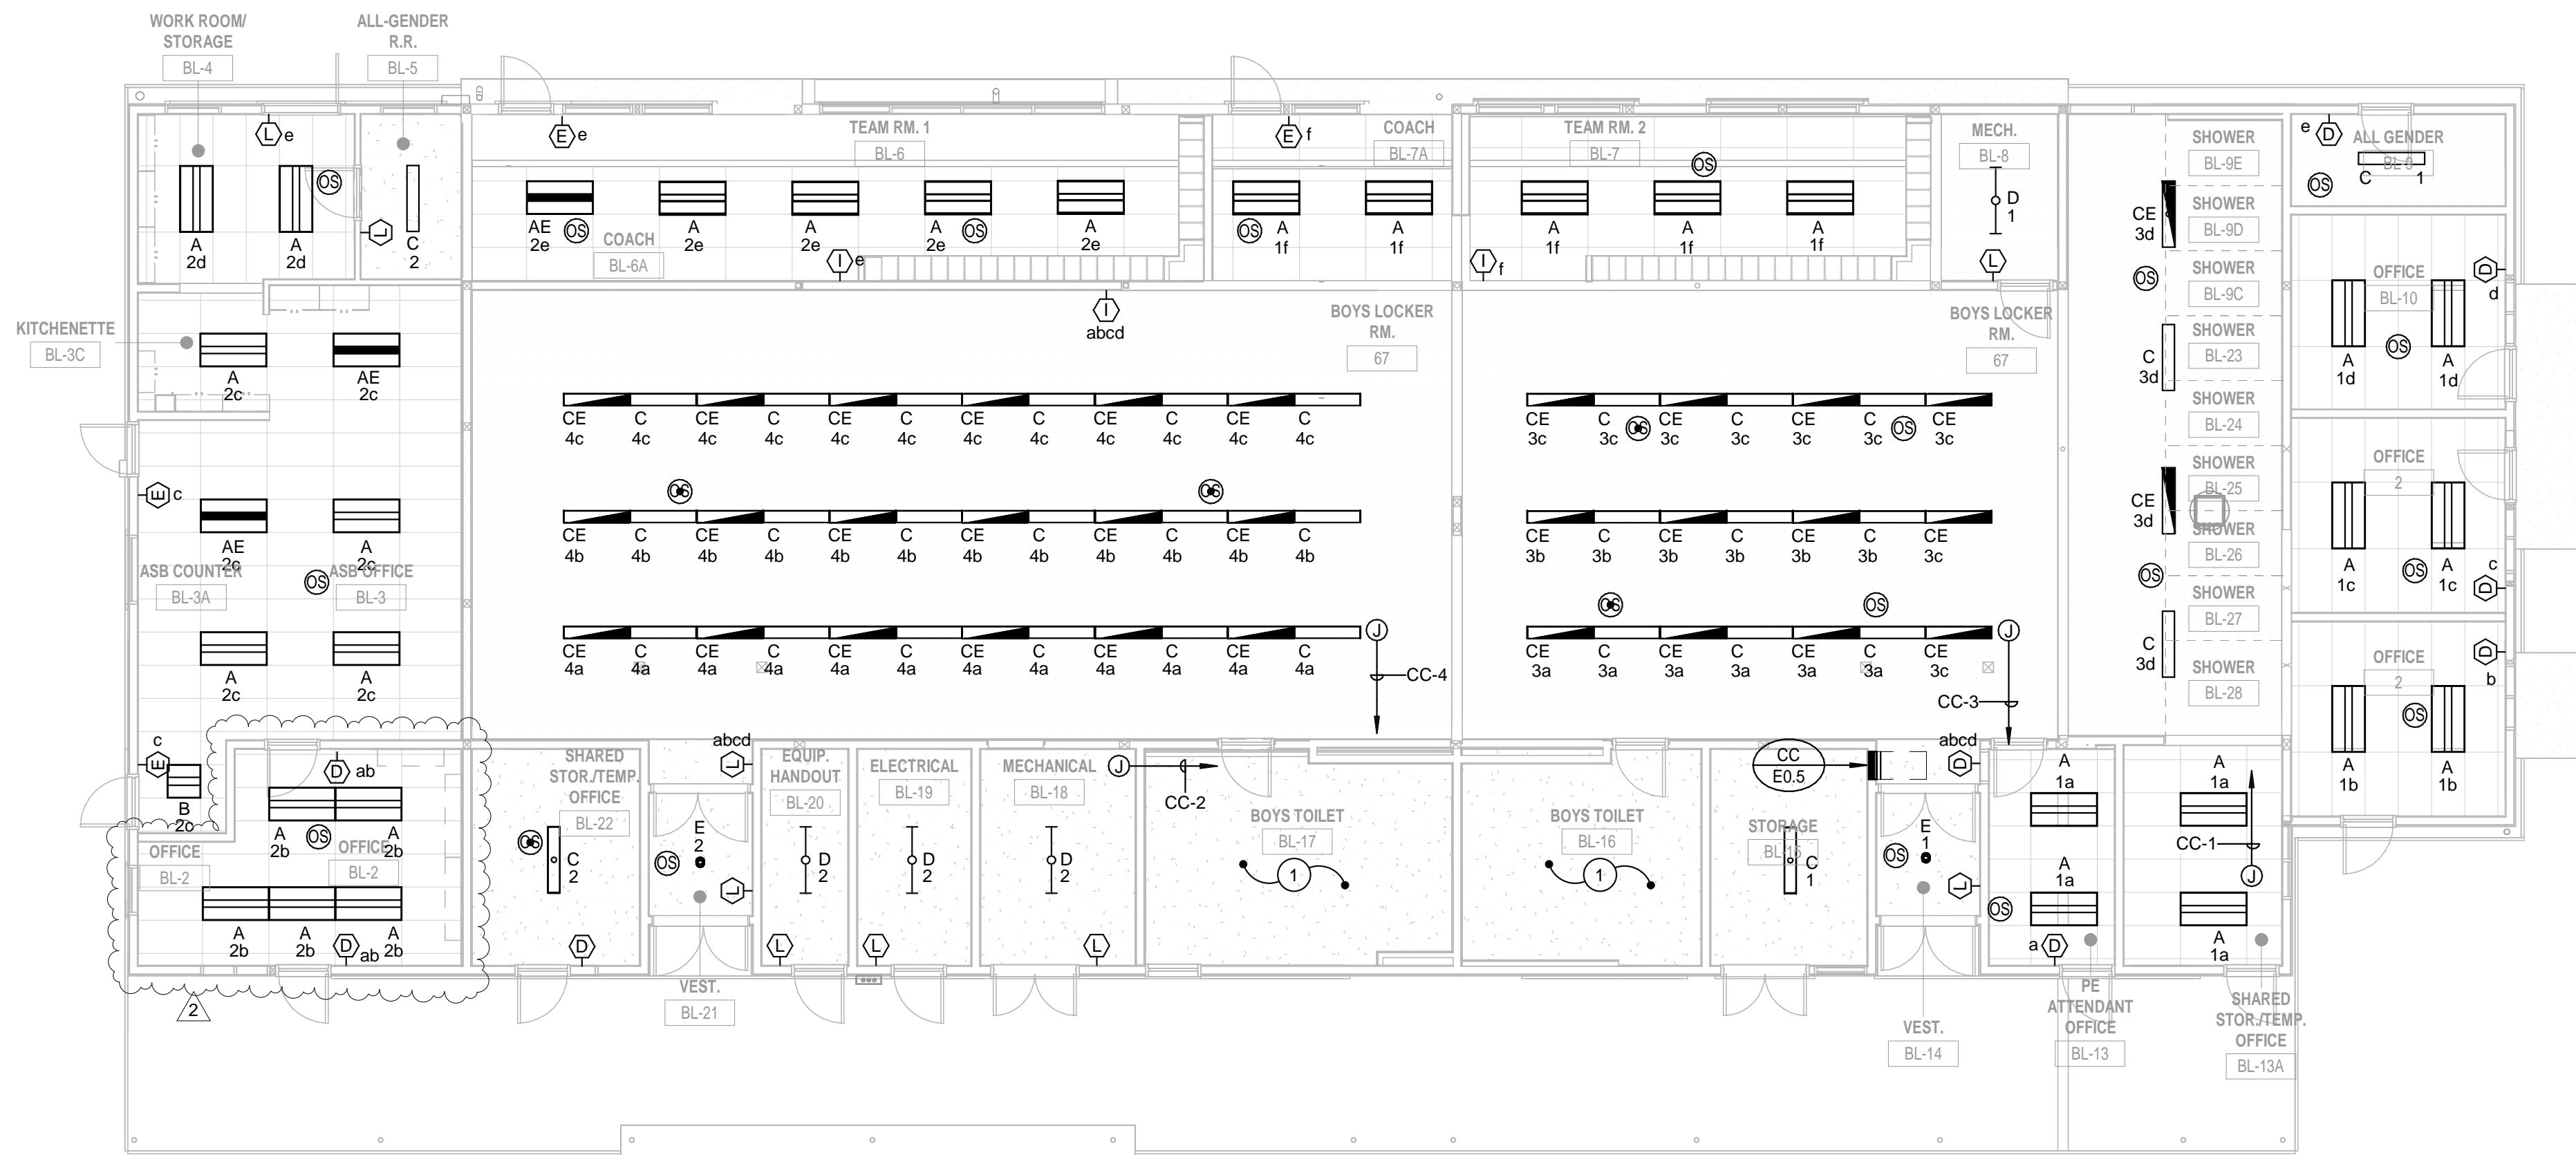

BUILDING BL LIGHTING PLAN

SCALE 1/8" = 1'-0"

REMODEL PLAN NOTES

- EXISTING LTS TO REMAIN.


GENERAL LIGHTING NOTES

- REFER TO LIGHTING CONTROL WIRING DIAGRAM ON E0.3 FOR TYPICAL LIGHTING CONTROL LAYOUT.
- FOR CLARITY BRANCH CIRCUIT CONDUIT AND CONDUCTORS REQUIREMENTS HAVE NOT BEEN SHOWN ON PLANS FOR NORMAL AND EMERGENCY LIGHTING. FOR LIGHTING THROUGHOUT ALL SPACES, PROVIDE CONDUIT AND CONDUCTORS IN ACCORDANCE WITH SPECIFICATIONS 26 05 33. IN ADDITION, LIGHTING CONDUCTORS SHALL MATCH CIRCUIT CONDUCTORS SHOWN FOR HOME RUNS ON PLANS. CONDUIT SIZES SHALL BE AS FOLLOWING:
2 #12 = 1/2"C. 3 #12 = 1/2"C. 4 #12 = 3/4"C. 5 #12 = 3/4"C.
6 #12 = 3/4"C. 7 #12 = 1"C. 8 #12 = 1"C. 9 #12 = 1"C.
- FOR EMERGENCY LIGHTING BRANCH CIRCUITS, PROVIDE CONDUIT AND CONDUCTORS, SEPARATE FROM NORMAL LIGHTING BRANCH CIRCUIT. REFER TO NOTE "B" ABOVE.
- COORDINATE MOUNTING OF DEVICE, EQUIPMENT AND ALASSOCIATED OUTLET BOXES AND CONDUIT RUNS WITH ARCHITECTURAL PLANS AND DETAILS FOR ADDITIONAL INFORMATION.
- PROVIDE 1"C. AND CONTROL CABLEING SIDE-BY-SIDE WITHPOWER CONDUITS IN ACCESSIBLE CEILING SPACES.

DEMOLITION PLAN NOTES

- DISCONNECT AND REMOVE EXISTING LIGHTING FIXTURES, WIRING AND CONTROL WIRING. PRESERVE ALL THROUGH WIRING.

KEYPLAN

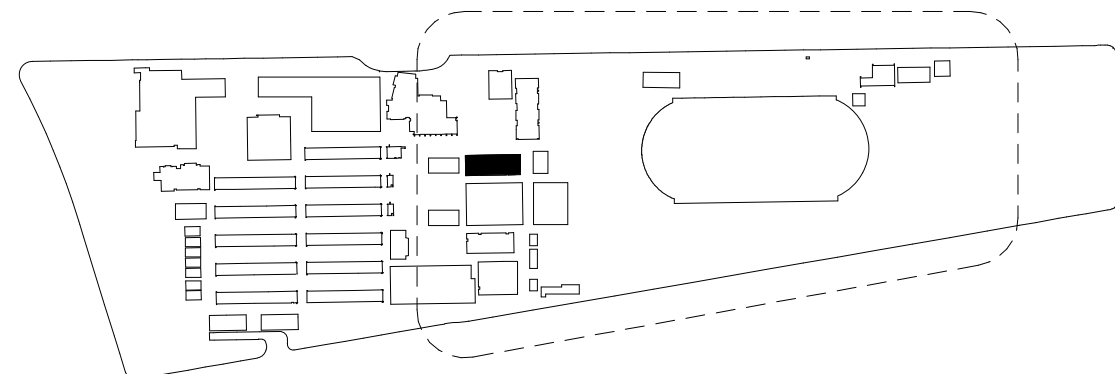


BUILDING BL DEMOLITION LIGHTING PLAN

SCALE 1/8" = 1'-0"

DIVISION OF THE STATE ARCHITECT
355 S GRAND AVE #2100,
LOS ANGELES, CA 90071
(213) 897-3995
DSA Application #
DSA File #

agency

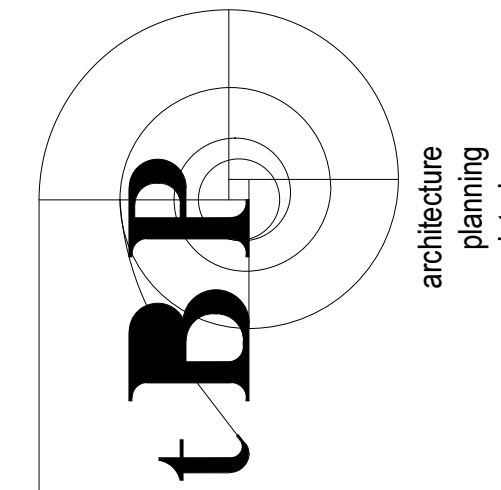

architect



consultant

ARCADIA HIGH SCHOOL LOCKER ROOM ALTERATION

180 CAMPUS DR
ARCADIA, CA 91006

ARCADIA UNIFIED SCHOOL DISTRICT

owner

tBP project number: 21101.00

file name:

drawn by: Author checked by: Checker

date: .

rev: 2 date: 03/17/25 description: ADDENDUM #2


THE DRAWING AND THE DESIGN, SPECIFICATIONS, IDEAS AND OTHER INFORMATION CONTAINED HEREIN CONSTITUTE UNPUBLISHED WORK OF ARCHITECTURE, AND SHALL REMAIN PROPERTY OF ARCHITECTURE IN PERPETUITY. NO PART THEREOF SHALL BE REPRODUCED, DISCLOSED, DISTRIBUTED, SOLD, PUBLISHED OR OTHERWISE USED IN ANY WAY WITHOUT THE ADVANCED EXPRESS WRITTEN CONSENT OF ARCHITECTURE.

drawing title:
BUILDING BL LIGHTING PLANS



drawing no.:

E2.1

C:\Users\Wmarras\Documents\ANS_Architectural\Plumbing_E_R24_wmarras0123.rvt

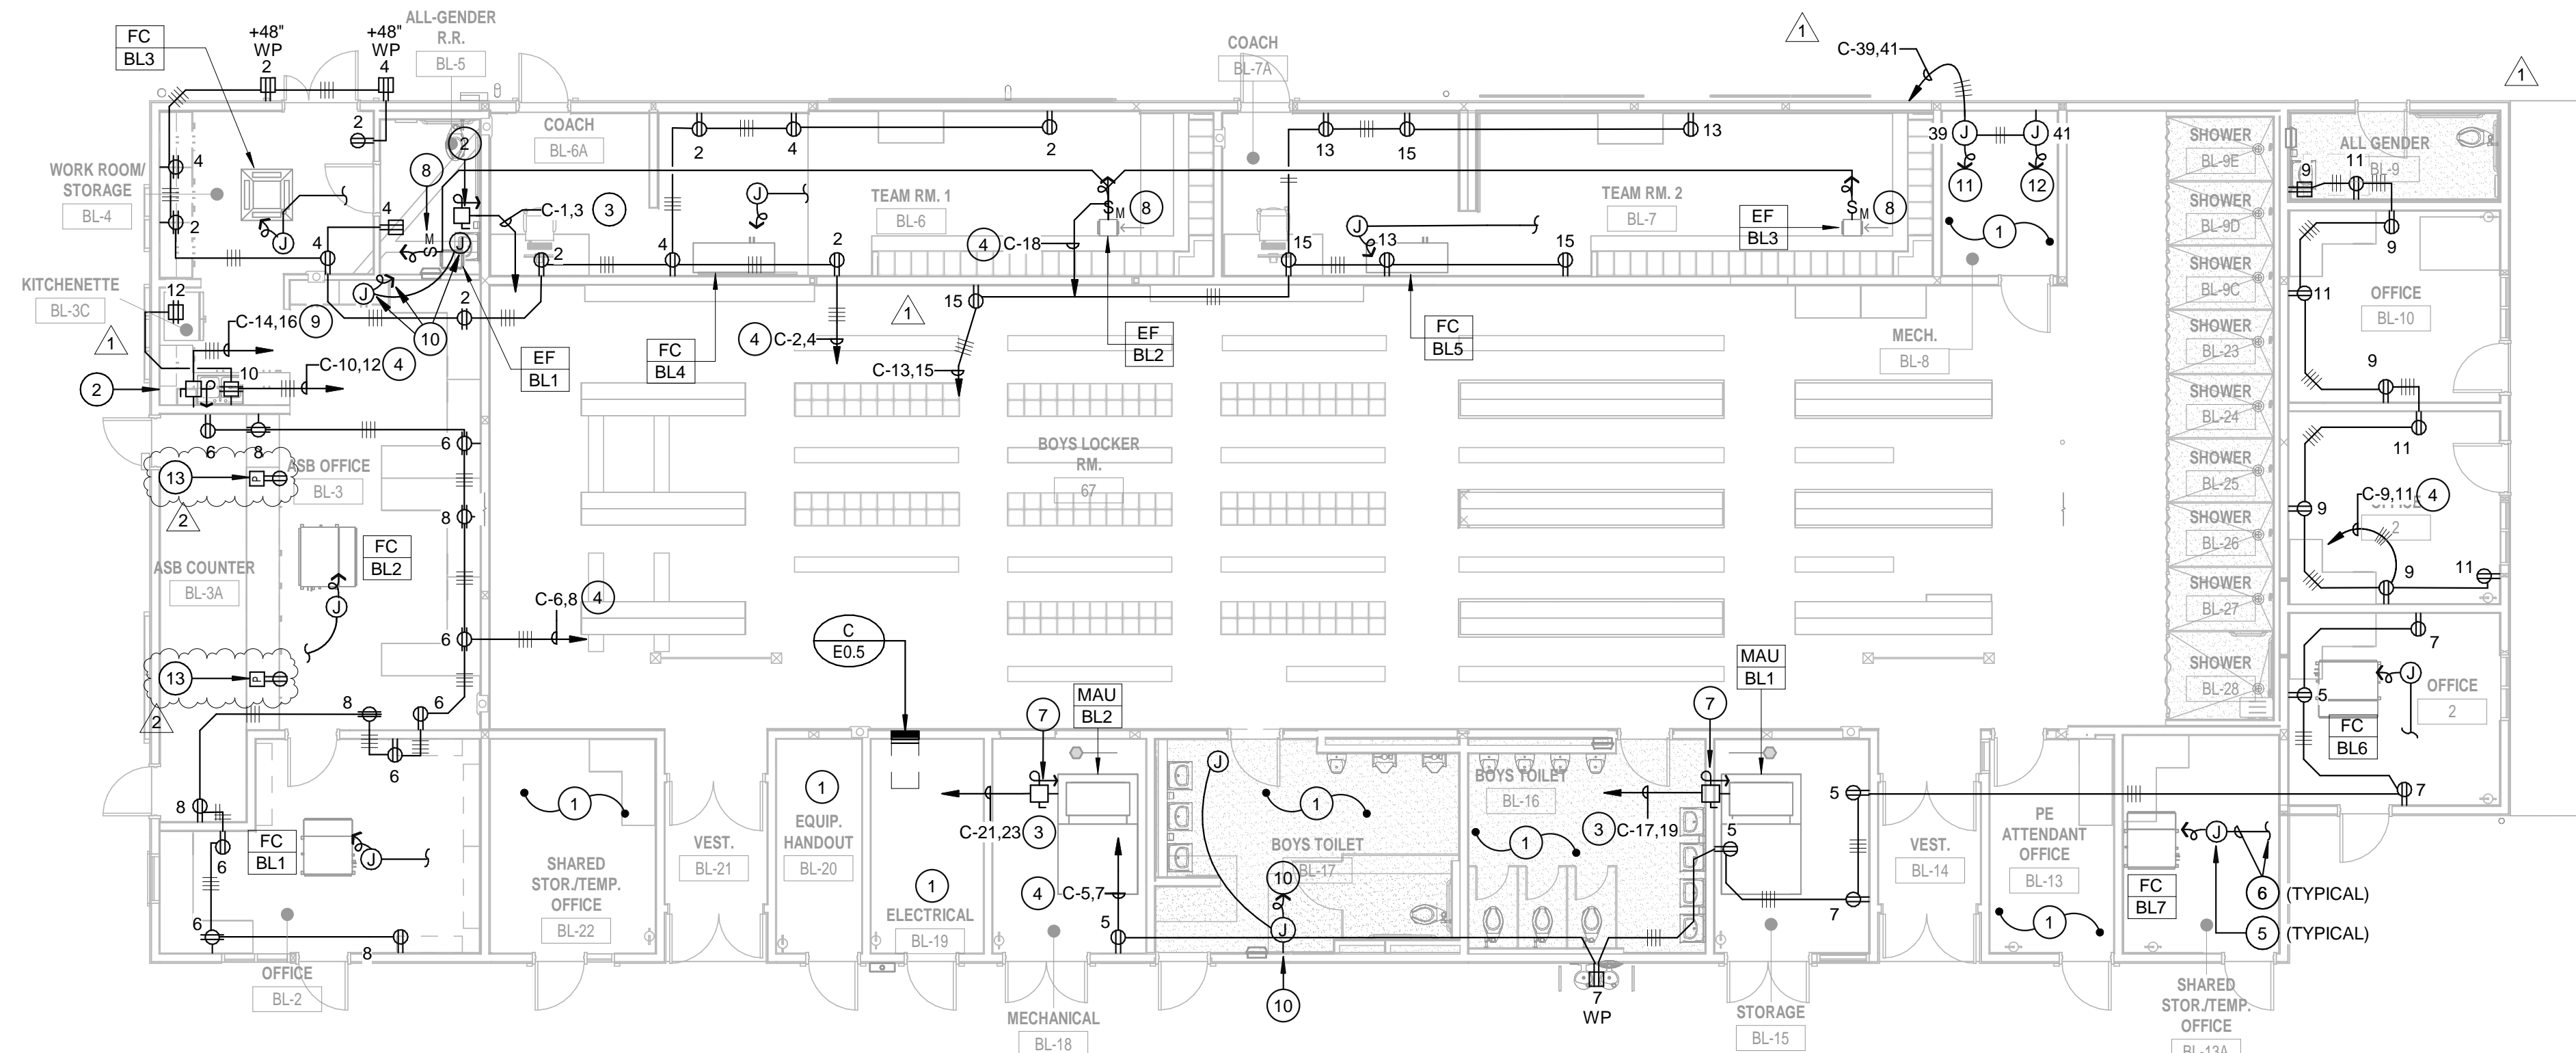

BUILDING BL POWER PLAN SCALE 1/8" = 1'-0" 1

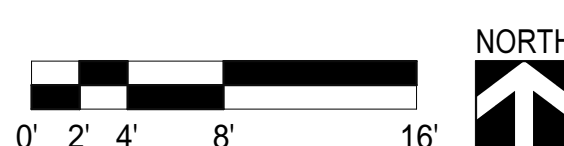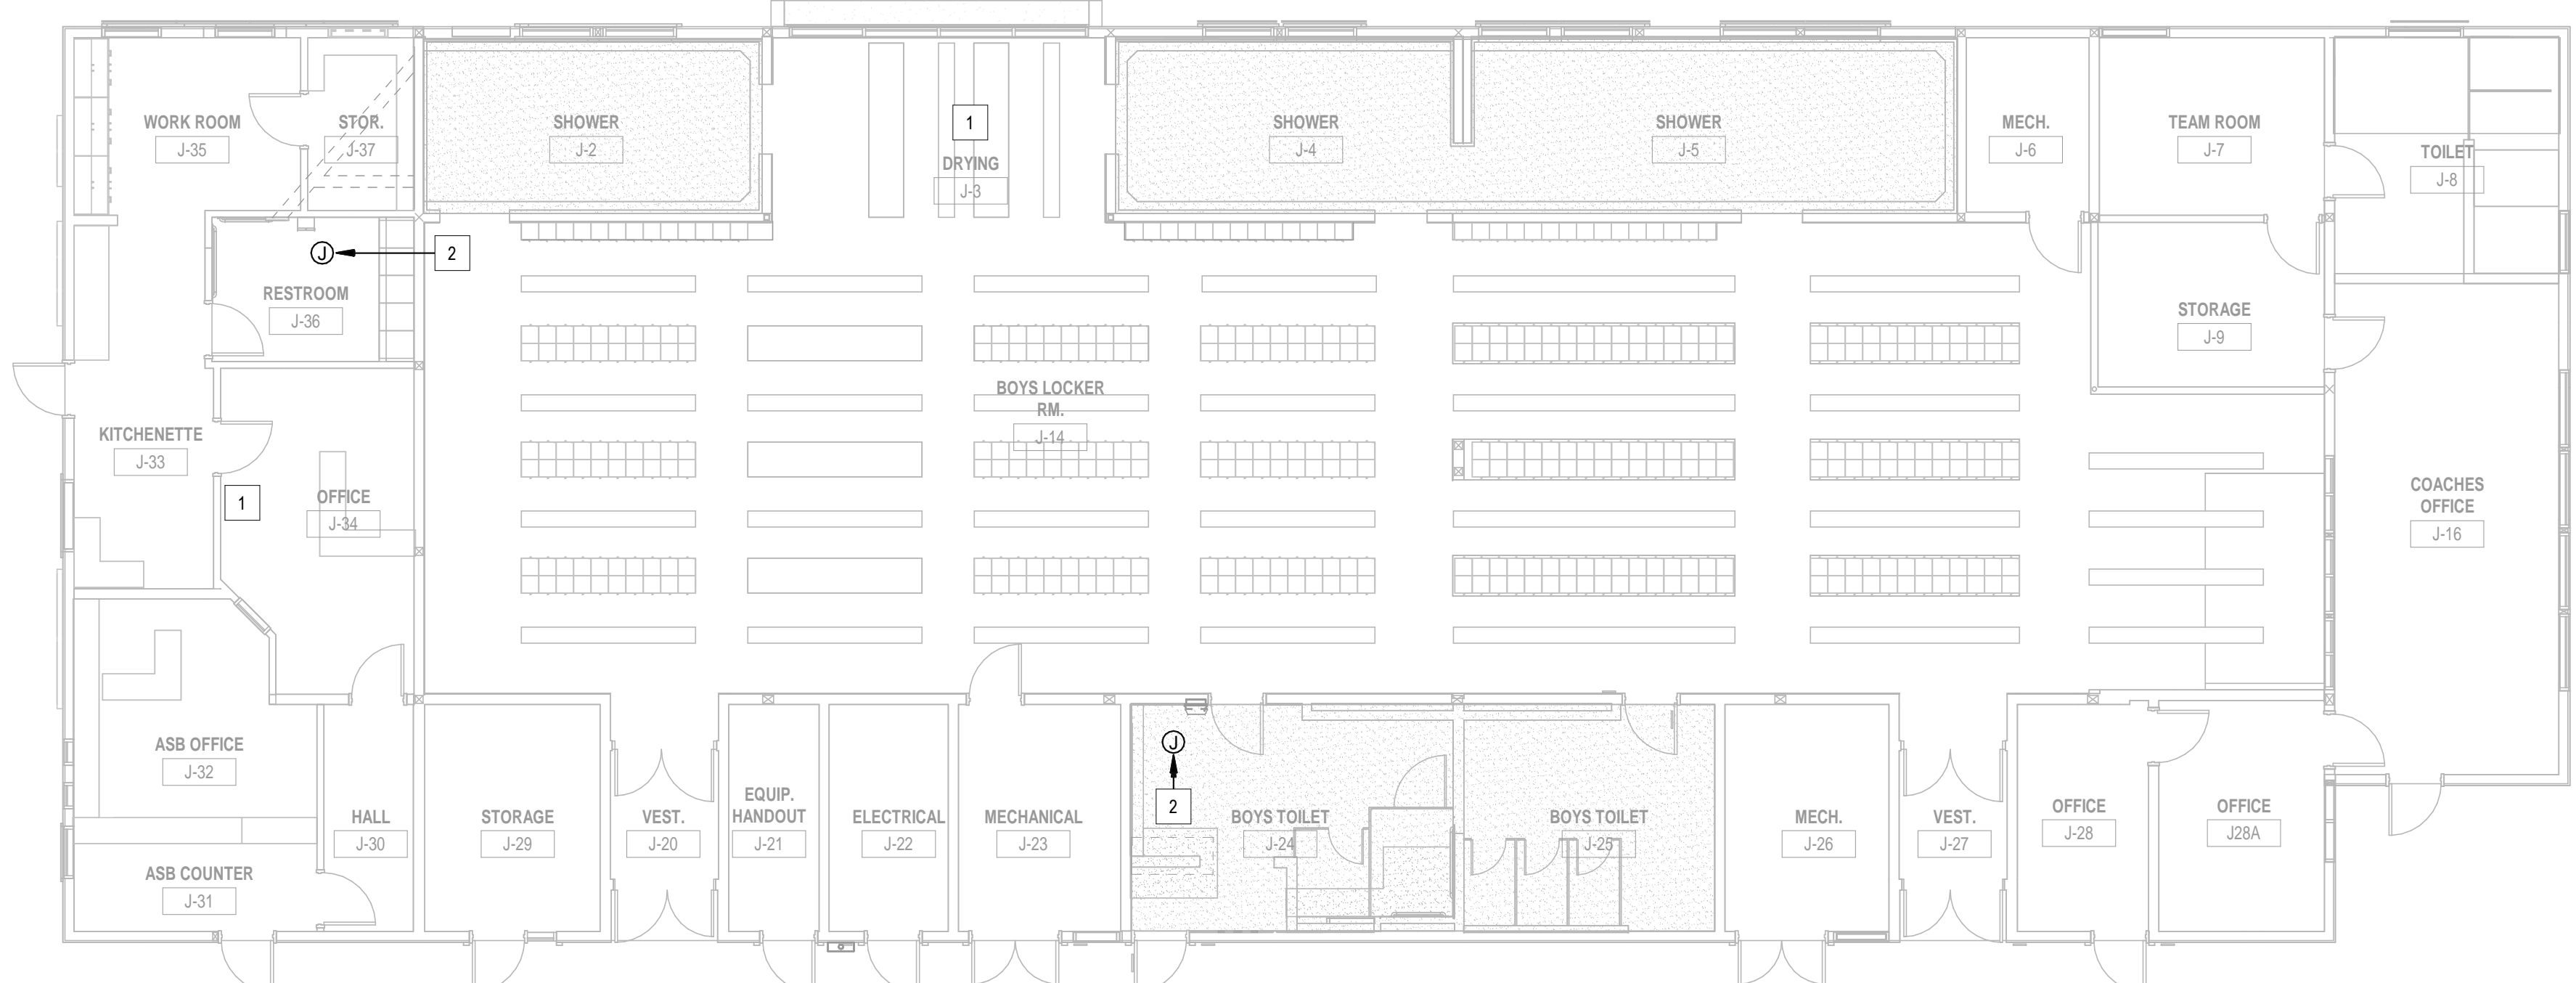

BUILDING BL DEMOLITION POWER PLAN SCALE 1/8" = 1'-0" 2


REMODEL PLAN NOTES

- EXISTING ELECTRICAL TO REMAIN IN THIS ROOM. PROTECT IN PLACE PRESERVE ALL THROUGH WIRING.
- CONNECT TO INSTANTANEOUS HOT WATER HEATER IN ACCORDANCE WITH THE MANUFACTURERS REQUIREMENTS. REFER TO PLUMBING DRAWINGS FOR EXACT LOCATION AND ADDITIONAL INFORMATION.
- PROVIDE 3/4" C - 2#10, 1#10 GRD.
- PROVIDE #10 CONDUCTORS FOR ENTIRE BRANCH CIRCUIT.
- CONNECT TO FAN COIL UNIT IN ACCORDANCE WITH THE MANUFACTURERS REQUIREMENTS. REFER TO MECHANICAL DRAWINGS FOR EXACT LOCATION AND ADDITIONAL INFORMATION.
- PROVIDE 3/4" C - 2#10, 1#10 GRD. UP TO ROOF MOUNTED MECHANICAL EQUIPMENT. REFER TO SHEET ES.1 FOR CONTINUATION.
- CONNECT TO MAKE-UP AIR UNIT IN ACCORDANCE WITH THE MANUFACTURERS REQUIREMENTS. REFER TO MECHANICAL DRAWINGS FOR EXACT LOCATION AND ADDITIONAL INFORMATION.
- CONNECT TO EXHAUST FAN IN ACCORDANCE WITH THE MANUFACTURERS REQUIREMENTS. REFER TO MECHANICAL DRAWINGS FOR EXACT LOCATION AND ADDITIONAL INFORMATION.
- PROVIDE 3/4" C - 2#8, 1#8 GRD.
- INTERCEPT AND EXTEND EXISTING CONDUIT AND CONDUCTORS SAFED OFF DURING DEMOLITION PHASE. CONNECT TO HAND DRYER IN ACCORDANCE WITH MANUFACTURERS REQUIREMENTS.
- CONNECT TO WATER HEATER IN ACCORDANCE WITH MANUFACTURES REQUIREMENTS. REFER TO PLUMBING DRAWINGS FOR EXACT LOCATION AND ADDITIONAL INFORMATION.
- CONNECT TO CIRCULATION PUMP IN ACCORDANCE WITH MANUFACTURERS REQUIREMENTS. REFER TO PLUMBING DRAWINGS FOR EXACT LOCATION AND ADDITIONAL INFORMATION.
- MOUNT DUPLEX RECEPTACLE IN PEDESTAL SINGLE SIDED OUTLET BOX ON TOP OF COUNTER. BK RESOURCES #BK-SOPP OR EQUAL. PROVIDE BOX, DEVICES, COVER PLATES, CONDUIT, WIRE, ETC. FOR A COMPLETE AND OPERABLE SYSTEM.



DEMOLITION PLAN NOTES

- DISCONNECT AND REMOVE ELECTRICAL DEVICES IN WALLS BEING DEMOLISHED. PRESERVE ALL THROUGH WIRING.
- DISCONNECT EXISTING HAND DRYER. SAFE OFF CONDUIT AND CONDUCTORS FOR CONNECTION TO HAND DRYER IN REMODEL PHASE. REFER TO ARCHITECTURAL DRAWINGS FOR ADDITIONAL INFORMATION.

KEYPLAN

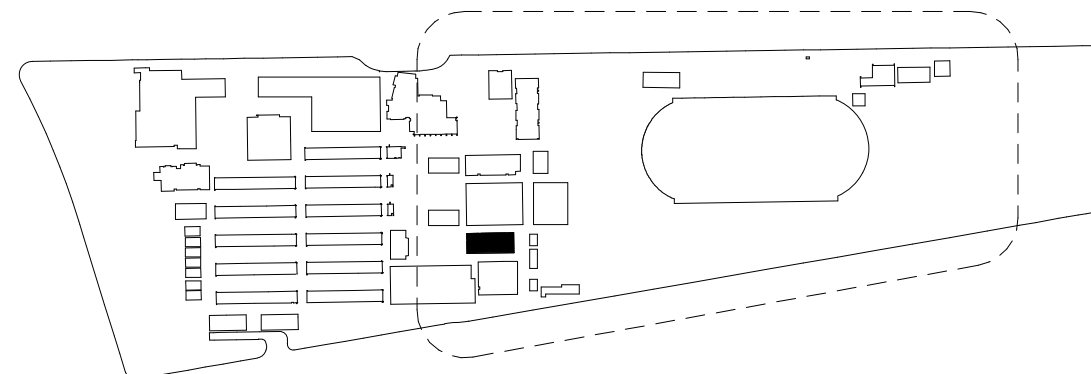

DIVISION OF THE STATE ARCHITECT
355 S GRAND AVE #2100,
LOS ANGELES, CA 90071
(213) 897-3995
DSA Application #
DSA File #

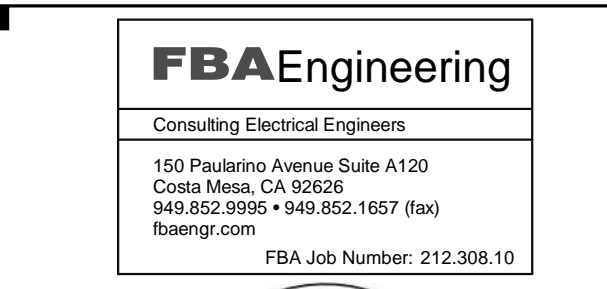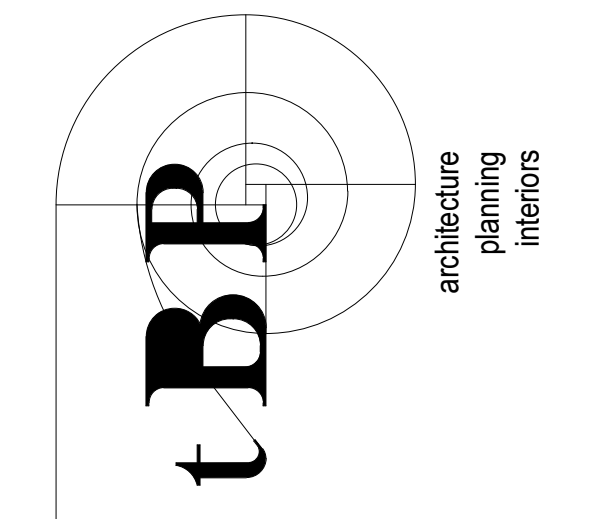

ARCADIA HIGH SCHOOL
LOCKER ROOM ALTERATION
180 CAMPUS DR
ARCADIA, CA 91006
ARCADIA UNIFIED SCHOOL DISTRICT

tBP project number: 21101.00

file name:

drawn by: Author checked by: Checker

date: .

rev:	date:	description:
1	03/12/25	ADDENDUM #1
2	03/17/25	ADDENDUM #2


THE DRAWING AND THE DESIGN, SPECIFICATIONS, IDEAS AND OTHER INFORMATION CONTAINED HEREIN CONSTITUTE UNPUBLISHED WORK OF ARCHITECTURE, AND SHALL REMAIN PROPERTY OF ARCHITECTURE. IN PERPETUITY. NO PART THEREOF SHALL BE REPRODUCED, DISCLOSED, DISTRIBUTED, SOLD, PUBLISHED OR OTHERWISE USED IN ANY WAY WITHOUT THE ADVANCED EXPRESS WRITTEN CONSENT OF ARCHITECTURE.

drawing title:
BUILDING BL POWER PLANS

drawing no.:



E3.1

C:\Users\Wramos\Documents\ANS_Architectural\Pluckers_E_R24_warmos0228.v4

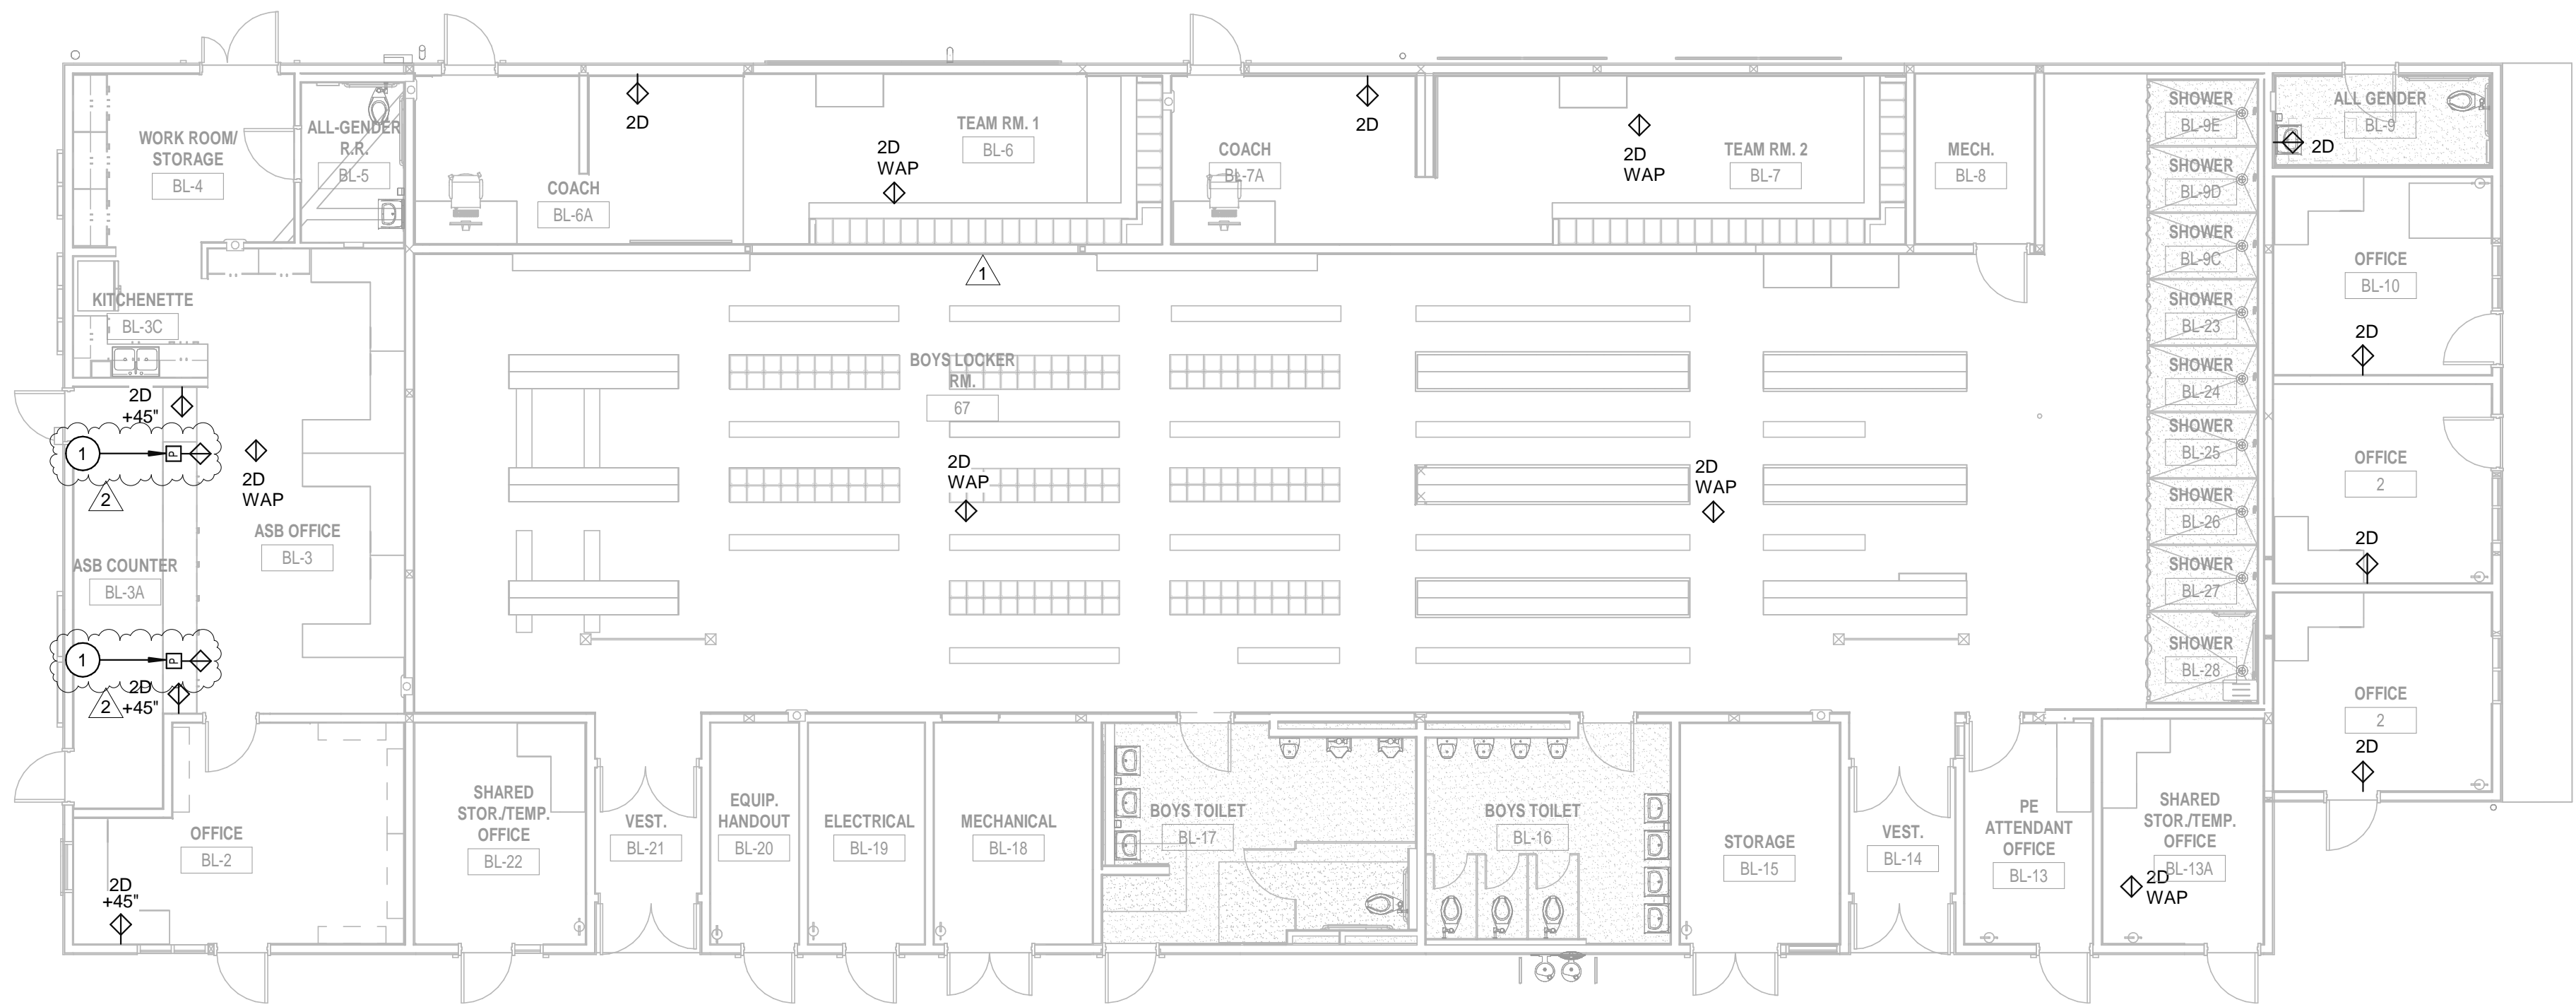

BUILDING BL SIGNAL PLAN

SCALE 1/8" = 1'-0" 1

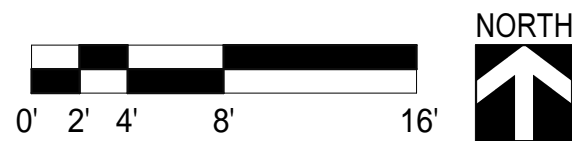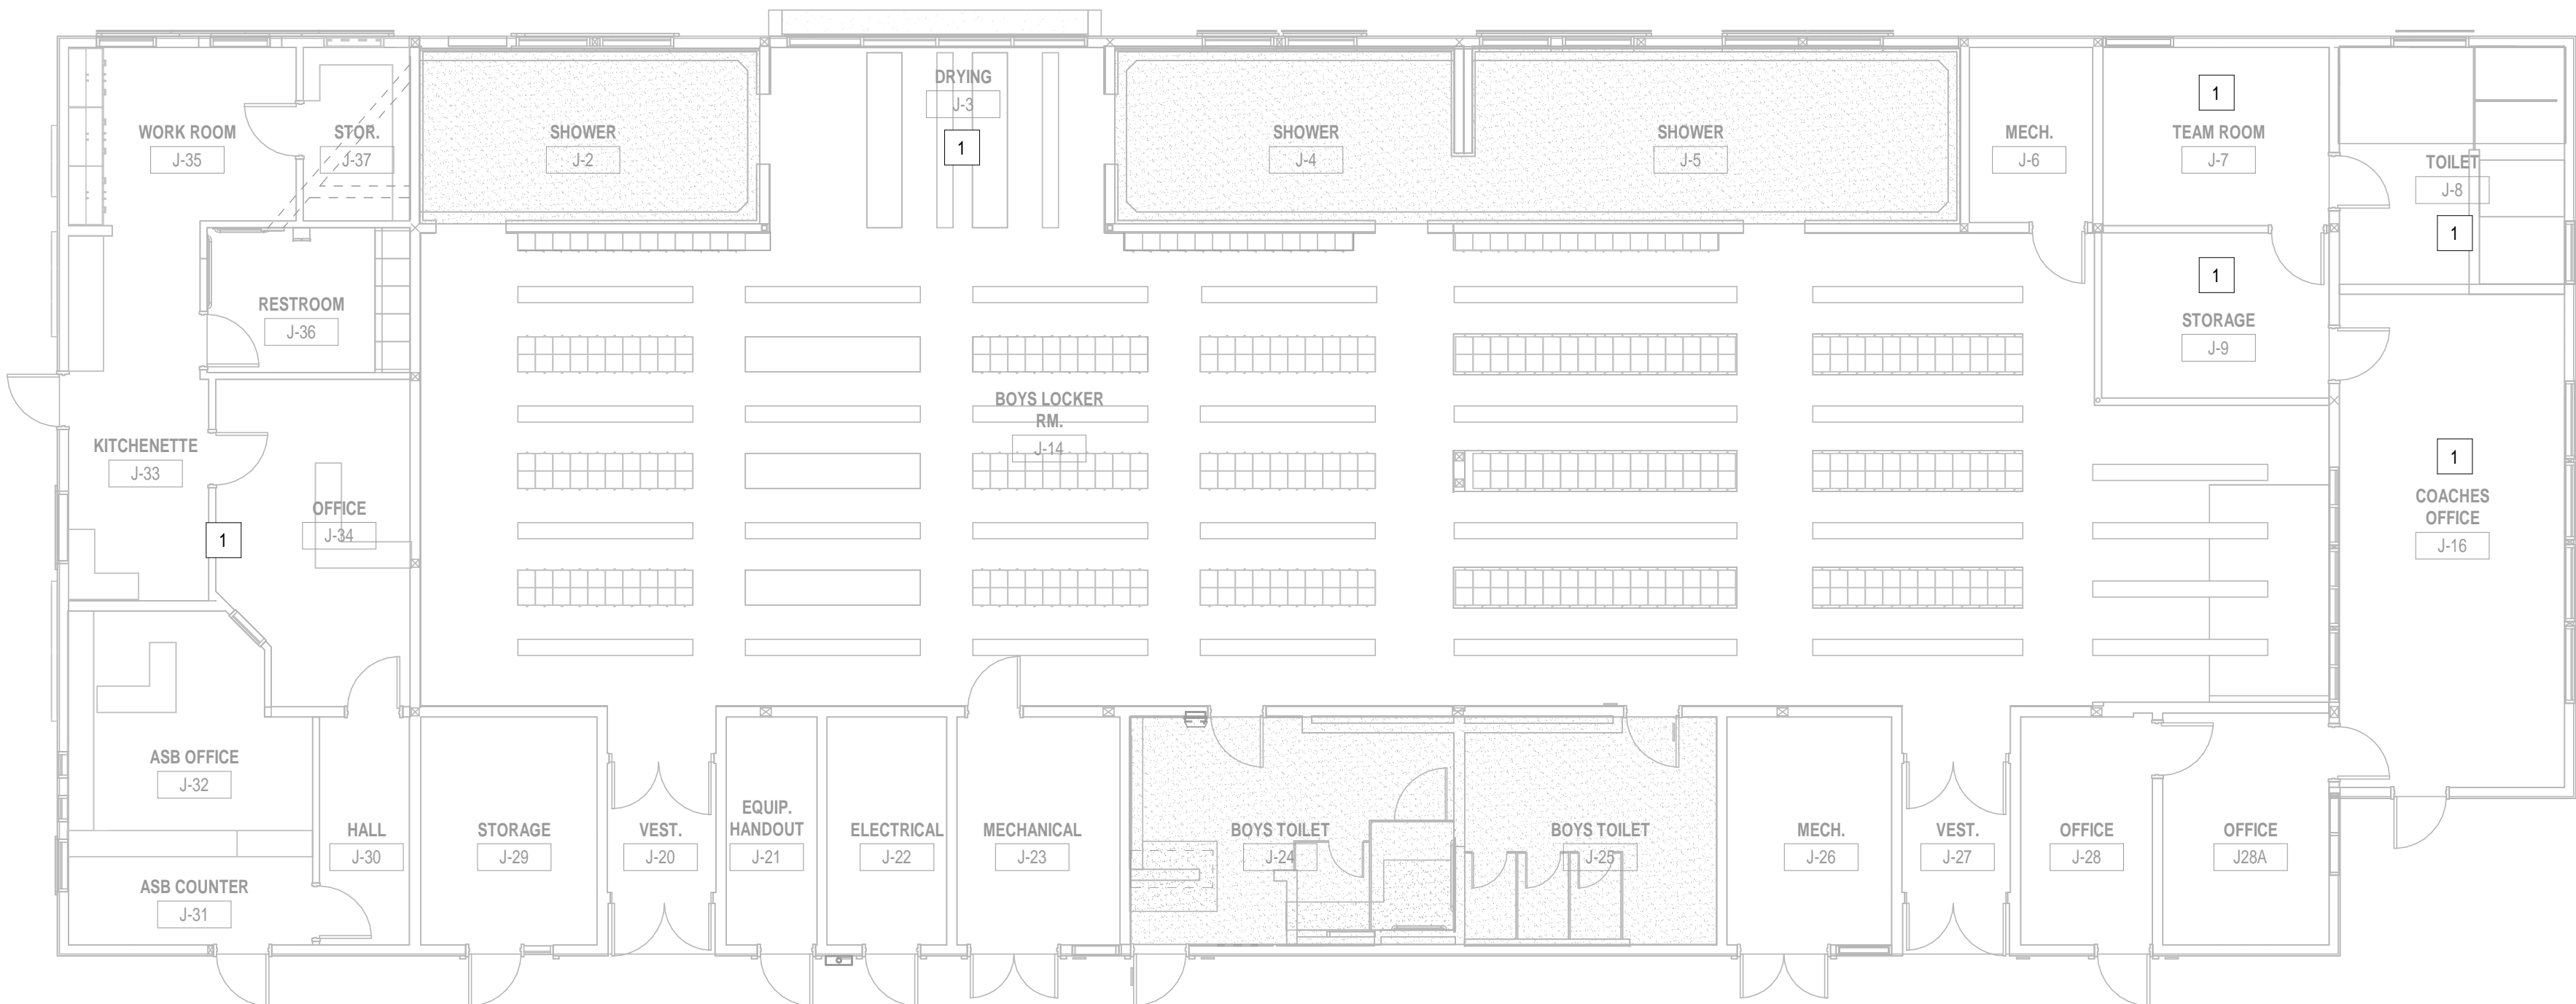

BUILDING BL DEMOLITION SIGNAL PLAN

SCALE 1/8" = 1'-0" 2

REMODEL PLAN NOTES

1. MOUNT DATA OUTLET DEVICES IN PEDESTAL SINGLE SIDED OUTLET BOX ON TOP OF COUNTER. BK RESOURCES #BK-SOPD OR EQUAL. PROVIDE BOX, DEVICES, COVER PLATES, CONDUIT, CABLING, ETC. FOR A COMPLETE AND OPERABLE SYSTEM.


2.

DEMOLITION PLAN NOTES

SIGNAL PERFORMANCE NOTES


1. EXISTING PHONE, CLOCK SPEAKER, CLASS PASSING, DATA EQUIPMENT TO REMAIN. PROTECT ION PLACE.
2. EXISTING PHONE OUTLETS, CLOCK SPEAKER, CLASS PASSING, DATA OUTLETS TO REMAIN. CONCEAL SURFACE MOUNTED CONDUITS, RACEWAYS AND CABLING IN WALLS WHEREVER POSSIBLE. WHERE NOT POSSIBLE, PROVIDE WIREMOLD RACEWAY TO MATCH EXISTING ON CAMPUS. MOUNT RACEWAY AS IN CONSPICUOUSLY AS POSSIBLE. PAINT TO MATCH SURROUNDING SURFACES.

KEYPLAN

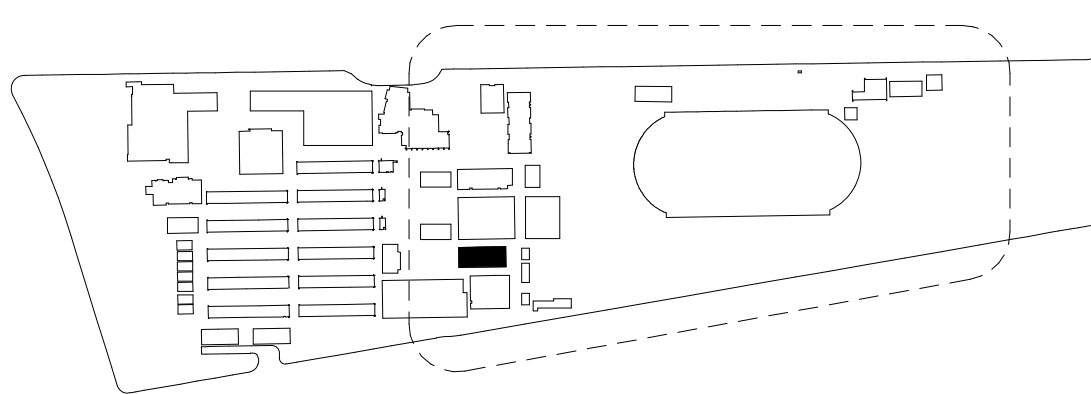


DIVISION OF THE STATE ARCHITECT
355 S GRAND AVE #2100,
LOS ANGELES, CA 90071
(213) 897-3995
DSA Application #
DSA File #

agency

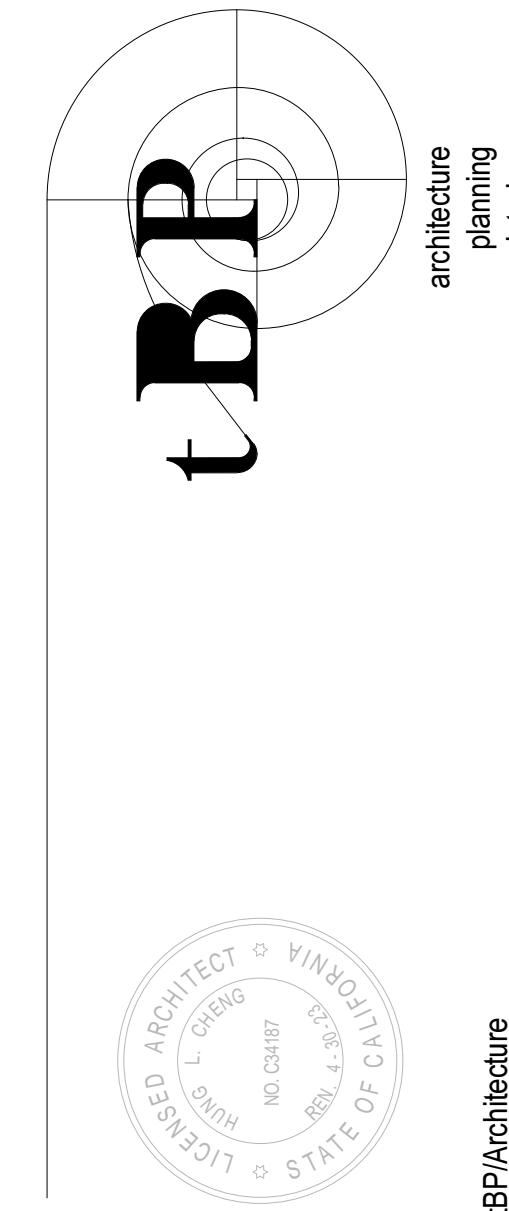

architect

FBAEngineering
Consulting Electrical Engineers
1551 Paulsen Avenue Suite A120
Costa Mesa, CA 92626
949.852.9955 • FAX 949.852.1857 (fax)
fbaengr.com
FBA Job Number: 212.308.10

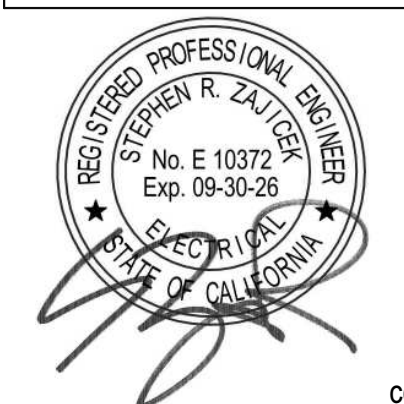

consultant

ARCADIA HIGH SCHOOL LOCKER ROOM ALTERATION

180 CAMPUS DR
ARCADIA, CA 91006

ARCADIA UNIFIED SCHOOL DISTRICT

owner

tBP project number: 21101.00

file name:

drawn by: Author checked by: Checker

date: .

rev:	date:	description:
1	03/12/25	ADDENDUM #1
2	03/17/25	ADDENDUM #2

THE DRAWING AND THE DESIGN, SPECIFICATIONS, IDEAS AND OTHER INFORMATION CONTAINED HEREIN CONSTITUTE UNPUBLISHED WORK OF ARCHITECTURE, AND SHALL REMAIN PROPERTY OF ARCHITECTURE IN PERPETUITY. NO PART THEREOF SHALL BE REPRODUCED, DISCLOSED, DISTRIBUTED, SOLD, PUBLISHED OR OTHERWISE USED IN ANY WAY WITHOUT THE ADVANCED EXPRESS WRITTEN CONSENT OF ARCHITECTURE.

drawing title:
BUILDING BL SIGNAL PLANS

drawing no.:

E4.1